10

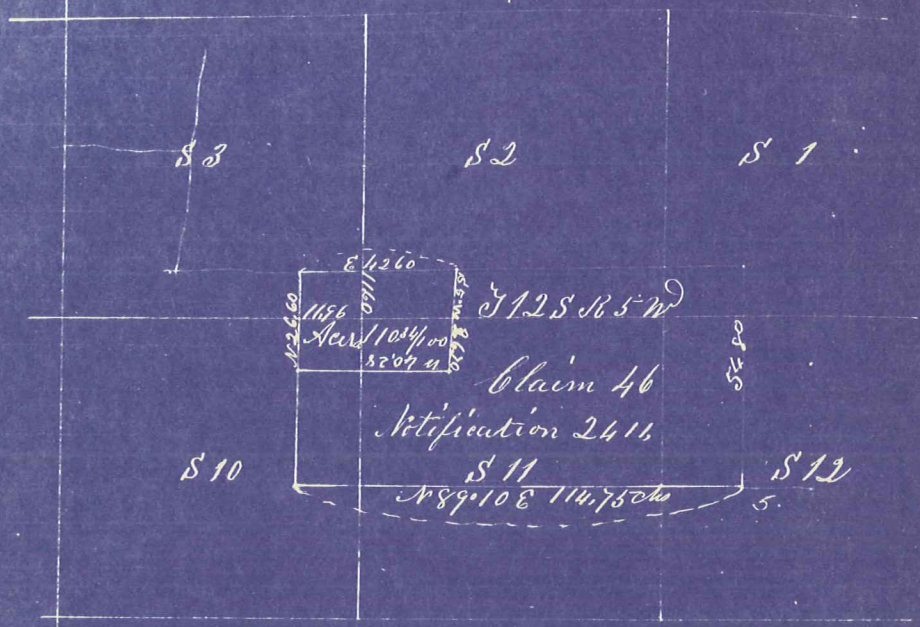

Survey No. 4

Joseph C Alexander
to
Charles S Knowles

Beginning at the N.W. corner of claim 46 T. 12 S R 5 W

East

42.60 ch Set a post & deposited glazed Brick. (in a Prairie on the N boundary line of C. 46)

S 5° W

26.70 ch Set a post & Glazed Brick. for the S.E corner

West

40.28 ch To J A Bennetts E boundary line Set at post from which a White Oak 12 ins in diam. bears N 21° E 1.84 chs distant

North

26.60 ch on the W boundary of claim 46 T. 12 S. R. 5 W. to place of beginning containing 110 84/100 Acres

11

Territory of Oregon
County of Benton } SS

I hereby certify that on the 21st day of July A.D. 1855 I Surveyed the foregoing described tract of land for Charles S Knowles assisted by Thomas P Adams & Lorenzo Abbot as duly qualified Chainmen that the foregoing diagram and notes are correct of said survey

L A. Davis County Surveyor