0005

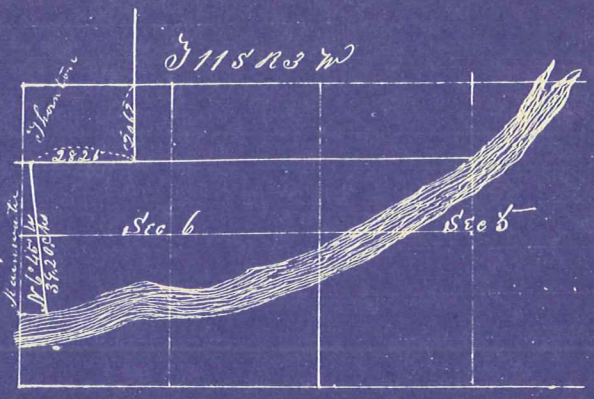

Survey No 5

For J. D. Thornton Administrator of Jarvis Huston deceased being the land claim of said Huston dec'd

Beginning at the S E corner of A. W. Ramsdales land claim on the Left Bank of the Willamette River on the East boundary claim 39, T 11 S R 3 W
N 6° 45' W 39.20 chs to the N E corner of claim " on the S boundary line of J. D. Thorntons claim on the N boundary of Survey No 5
East 118.40 chs to the West bank of the Willamette River thence with the meanders of the River to place of beginning

Territory of Oregon }
County of Benton } SS

I hereby certify that on the 11th day of Sept A.D. 1855 I surveyed the West and the North boundarys of the above described tract of land assisted by Wm W Walton & Samuel E Young as qualified chainmen and that I procured from the Office of the Surveyor General at Salem T & Sections 6 & 5 T 11 S R 3 W Exact Facings of the Government Survey as platted on said Map of T 11 S R 3 W } County