2000

15

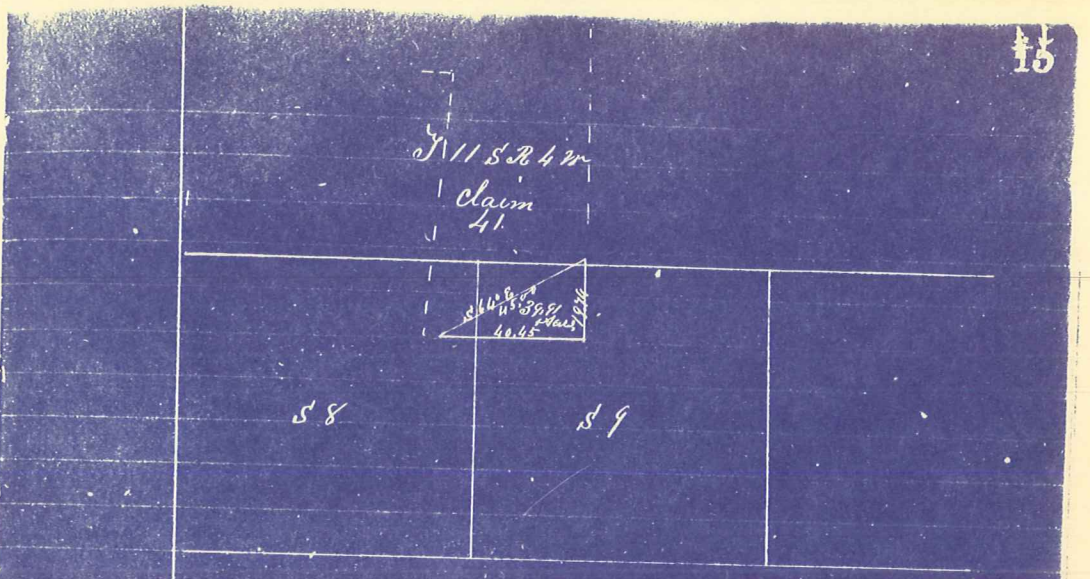

Survey No 7

Anthony Roberts to Isa Hunter

Beginning at a post 4.00 East of the S.W. corner of claim 41. T. 11 S. R. 4. W. on the South boundary of said claim

N 64° E
45.00 links to a post on the East boundary line of claim 41

South
19.74 links on the East boundary of claim 41

West
40.45 links to the SE corner claim 41 T 11 S R 4 W.

on the South boundary of said

to place of beginning containing

39.39/100 Acres

Territory of Oregon }
County of Benton } SS

I hereby certify that on the 19th day of September A.D. 1855 I surveyed the above described tract of land and by the agreement of the Parties Wm Taylor & Isa Hunter were qualified and assisted as chainmen that the above diagram and notes are correct of said survey

L. A. Davis County Surveyor