NOTE: DUPLICATE ORIGINAL
SEE SURVEY RECORD BOOK 1 PAGE 17

97

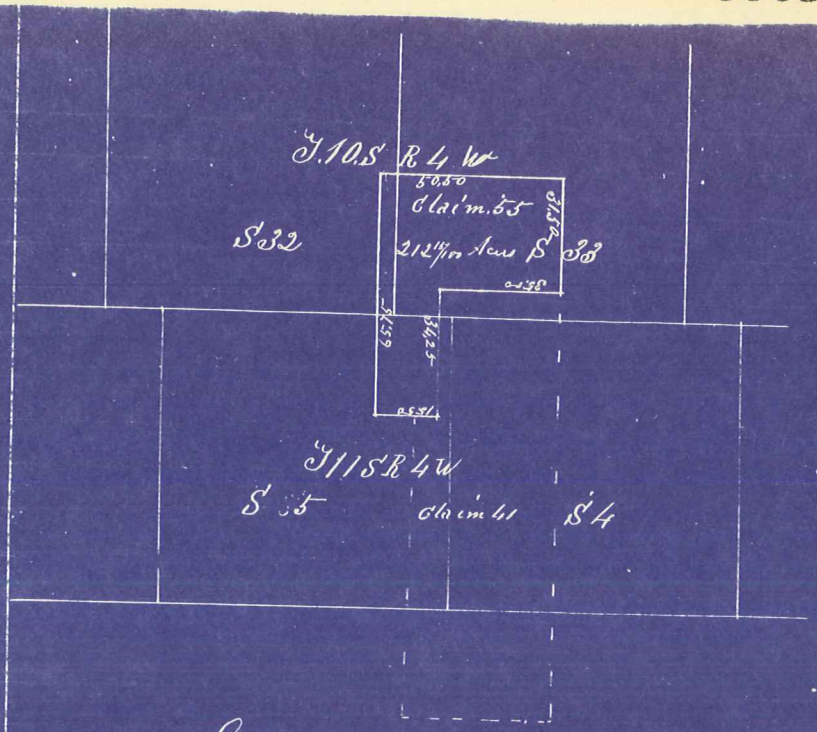

Survey No 9

Anthony Roberts to Stephen Taylor

Beginning at the N.E corner of claim 55 T10S R4W

South 3150 links to a post on the E boundary of claim 55 T10S R4W

West 3500 " to a post in claim 55 Section 33 T10S R4W

South 3425 " to a post in claim 41 Sections 5 T11S R4W

West 1550 " to a post the corner of claims 41 44 T11S R4W on the W boundary of 41 55 T10S T11S R4W

North 6675 " to the NW corner of claim 55 T10S R4W

East 5050 " to place of beginning containing 212 60/100 Acres

Territory of Oregon
County of Benton } Ss

I hereby certify that on the 20th day of September A.D. 1855 I Surveyed the above described tract of land and by the agreement of the Parties Stephen Taylor & Anthony Roberts assisted as chainman that the above diagram and Notes are correct. L. A. Davis County Surveyor