0011

Tp 13 S R 5 W

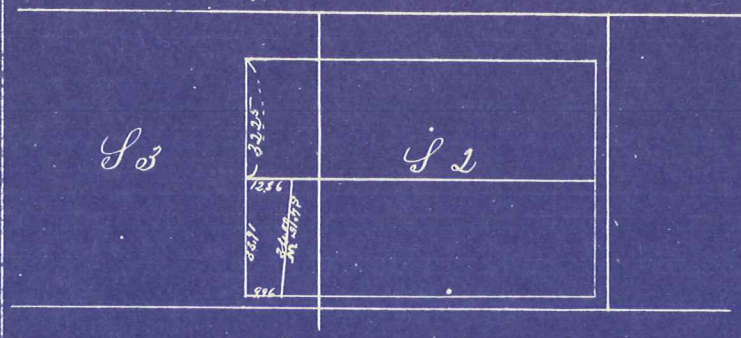


# Survey No 11

## Jesse Gage To James Kinney

Beginning at a post & mound 33.25 chs South of the N W corner of Claim 45. Tp 13 S R 5 W

East 1336 chs To a post on the West side of the Territorial Road

S 4° 15 W 34.00 chs With said Road To a post on the South boundary of claim 45 T 13 S R 5 W

West 9.96 chs On the South boundary of claim 45 T 13 S R 5 W To the S W corner of Claim 45 T 13 S R 5 W

North 33.91 chs On the West boundary of " " " " " To place of beginning containing 37 83/100 Acres

Territory of Oregon
County of Benton } ss

I hereby certify that on the 11 day of January A D 1856 that I surveyed the above described tract of land assisted by J W Lawrence & Lewis Dennis as Chainman and that the above diagram and note are correct of said survey

L A Davis County Surveyor