93

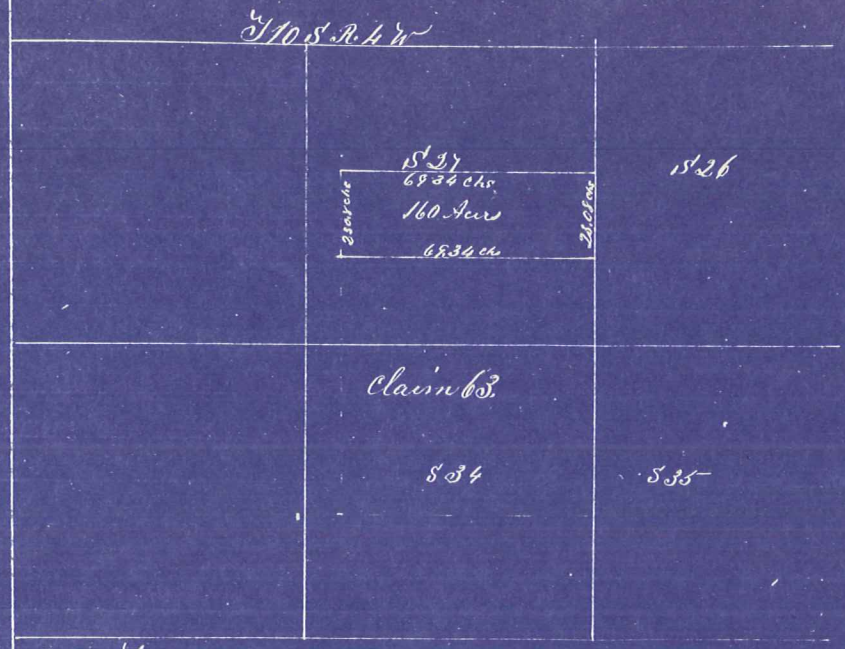

Wm H Johnson to Galliton Adkins
Survey No 13

Beginning at the N.E. corner of claim 63. T10S R4W 7.53 chs North of the ¼ corner on the West boundary of Section 26. T10S R4W

South 23.08 chs on the E boundary of claim 63. T10S R4W to a post A.W Oak Dia 13 inches in clus bars N 46° 30' W 2.65 chs distant.

West 69.34 chs to a post & mound on the W boundary line Claim 63

North 23.08 " to the N W corner of claim 63. T10S R4W

East 69.34 " on the N boundary line of C. 63. T10S R4W. to place of beginning containing 160 Acres

Territory of Oregon }
County of Benton } Ss

I hereby certify that on the 30th day March AD 1856 I Surveyed the above described tract of land assisted by J Allen & Alley Tourn Hughes as chainmen that the above diagram and notes are correct of said survey

L A Davis County Surveyor