24

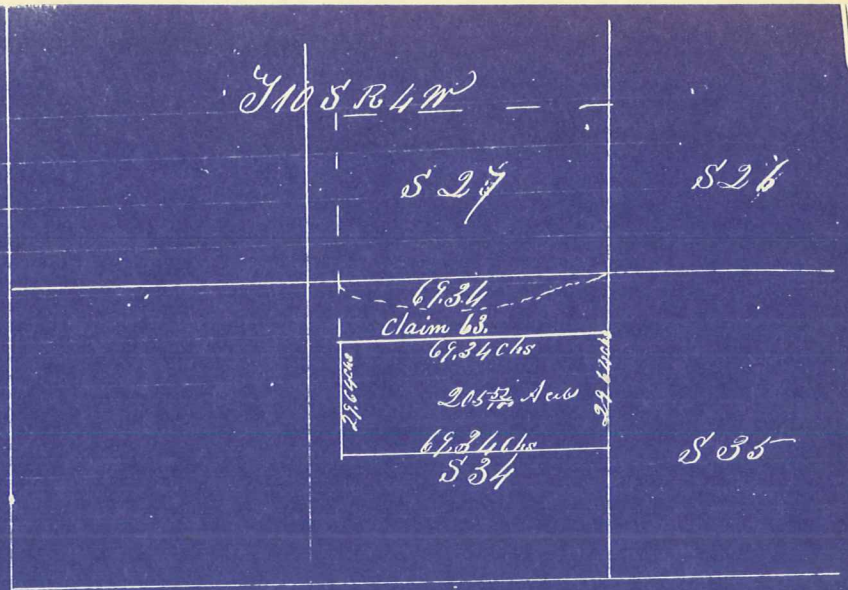


Wm H Johnson to Jacob Allen

Survey No 14

Beginning at the NE corner of claim 63 T10S R4W on the West boundary line Section 35 T10S R4W

North 29.64 chs — on said boundary to a post 15.55 chs South of the NE corner of Sec. 34 T10S R4W

West 69.34 chs — to a post on the W boundary of claim 63 T10S R4W

South 29.64 chs — on the W boundary of claim 63 to the SW corner " " " T10S R4W

East 69.34 chs — on the South boundary of " " " " " " to place of beginning containing 206 72/100 Acres

Territory of Oregon
County of Benton } ss

I hereby certify that on the 21st day of March AD 1856 I surveyed the above described tract of land, and by the agreement of Parties Wm H Johnson and Jacob Allen assisted as chainmen that the above Note and diagram are correct of said Survey

L A Davis County Surveyor