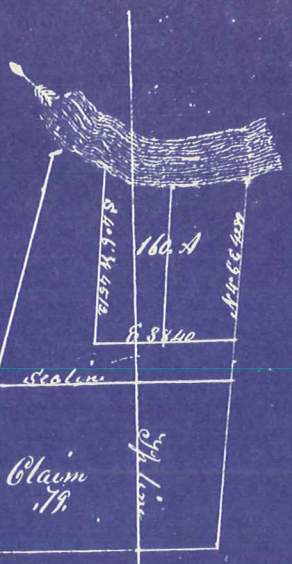

Survey No. 16

Gallitor Adkins To Wm H. Johnson

Beginning at a post on the left Bank of the Willamette River A White Fir Tree 18 inches diam bears S 50° W 31 Links distant,

S 4° 6' W 45.12 chs. To a post A White Oak Tree 2 Feet in diam bears N 75° 45' W 3.25 chs. dist. do, 30 inches in diam bears S 74° W. 2.36 chs dist.

East 38.40 chs. To a post on the E. boundary line Claim 79,

N 4° 6' E. 42.89 chs To the N.E corner of Claim 79 T.10.S.R.3.W. on the left Bank of the Willamette River

Meanders

S 77° W. 12.00 chs down stream
S 87° W 6.50 chs
N 79° W. 16.50 chs
N 62° W. 4.50 chs To place of beginning containing 160 A

Territory of Oregon } S.S.
County of Benton }

I hereby certify that on the 2d day of April A.D 1856 I surveyed the above described tract of land. The above notes & diagram is a correct record of said Survey

L. A Davis County Surveyor