T. 10 S R. 4 W

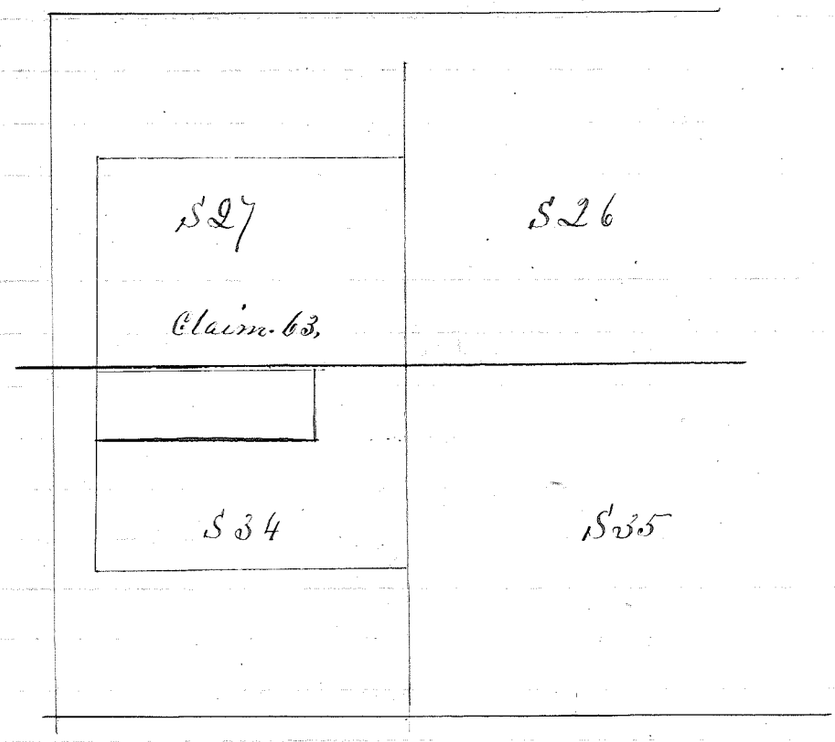

Survey No 17 #17

Wm H Johnson To Jennings B Conely

Beginning at a post on the West boundary line of Claim 63. T 10 S R 4 W. 29.64 chs North of the S.W. Corner of claim 63. " " " "

East 49.34 chs To a W. Hughes S.E. corner
North 16.23 chs To a post
West 49.34 To a post on the W. boundary line of Claim 63
South 16.23 To place of beginning containing 80 Acres

Territory of Oregon }
County of Benton } ss

I hereby certify that on the 15th day of April A.D. 1856 I Surveyed the above described tract of land, that the above is a correct record of said Survey

L. A Davis County Surveyor