28

T11S R5 W

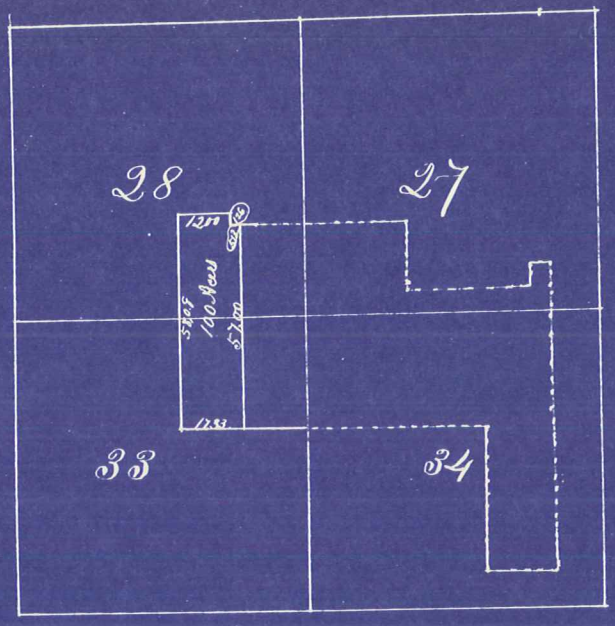

Survey No 18

J P Priddy To A M Witham

Beginning at the N.W. corner of Claim 53, T11S R5 W.

N 89°30' E	17.33 chs To a post, deposit & stone
N 1° W	57.00 chs To a post from which a White Oak tree bears S 41° W 81 Links dist. 20 inches in dia. also, 18 inches in dia bears S 23. E 1.51 chs dist
S 88°45' W	5.33. chs To the corner of claims 54 & 62. T11S R5 W
North	1.26 chs " " " " claim 55. " " " " "
West	12.00 chs To the N.W. corner of claim 62. T.11.S. R.5.W.
S 1° E	58.09 chs On the west line of claim 62. to place of beginning containing 100 Acres

N 1° W

N 89°30'

S 1° E

S 89°30' W