T. 11. S. R. 4. W.

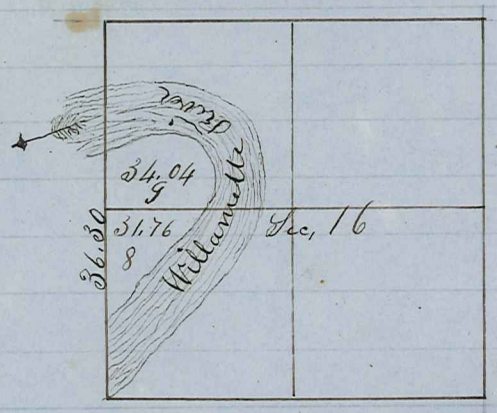

Survey No 29 #29

For D D Stovid, J B Lewis, Wm Elliot and J. P Friedly of Water Lots Numbered 8 & 9 T 11 S R 4 W

Sept. 7th 1856