Chs

T 13 S R 5 W

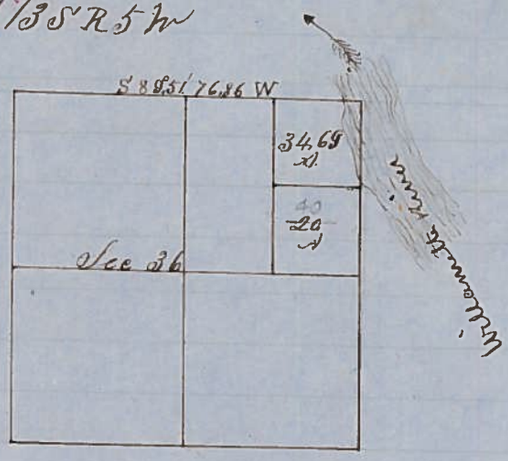

Survey No 31 #31

For John E Potts

Beginning at the 1/4 corner on the East boundary line of Section 36. T13S R5. W

West.

20.00 To a post, from which,
A White Oak 15 in dia bears N 4° E 87 links dist—

North

20.00 To a post, from which
A White Ash 20 in dia bears S 5 6°30' W 48 links dist—

East

20.00 To a post on the East boundary of Section
36 T, 13, S, R 5, W.

South

20.00 To place of beginning containing 40 Acres