Survey No 59 #59

Survey of Land sold By P. H. Bowman to John W. Rothell,

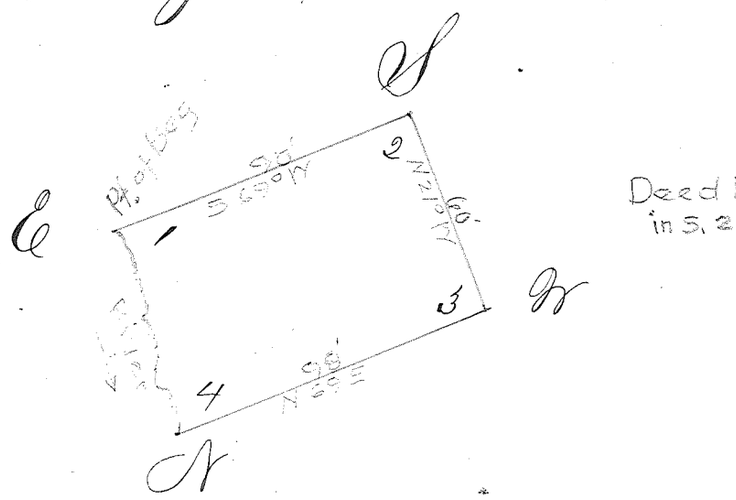

Beginning at the Waters Edge on the bank of the Willamette River

Run S 69° W 90 feet

Thence N 21° W 60 feet

" N 69° E 98 feet

" along the Edge of the Willamette River to the Place of beginning,

The same lot of ground being situated in the Town of Spring Hill, Benton County Oregon,

Jas. A. Cauthorn
Co. Surveyor,

Recorded By me this 23d day of June 1869

B. F. Wilson
County Clerk