Survey No 60 #60

Survey of Land sold by P W Bowman
To John W. Rothell

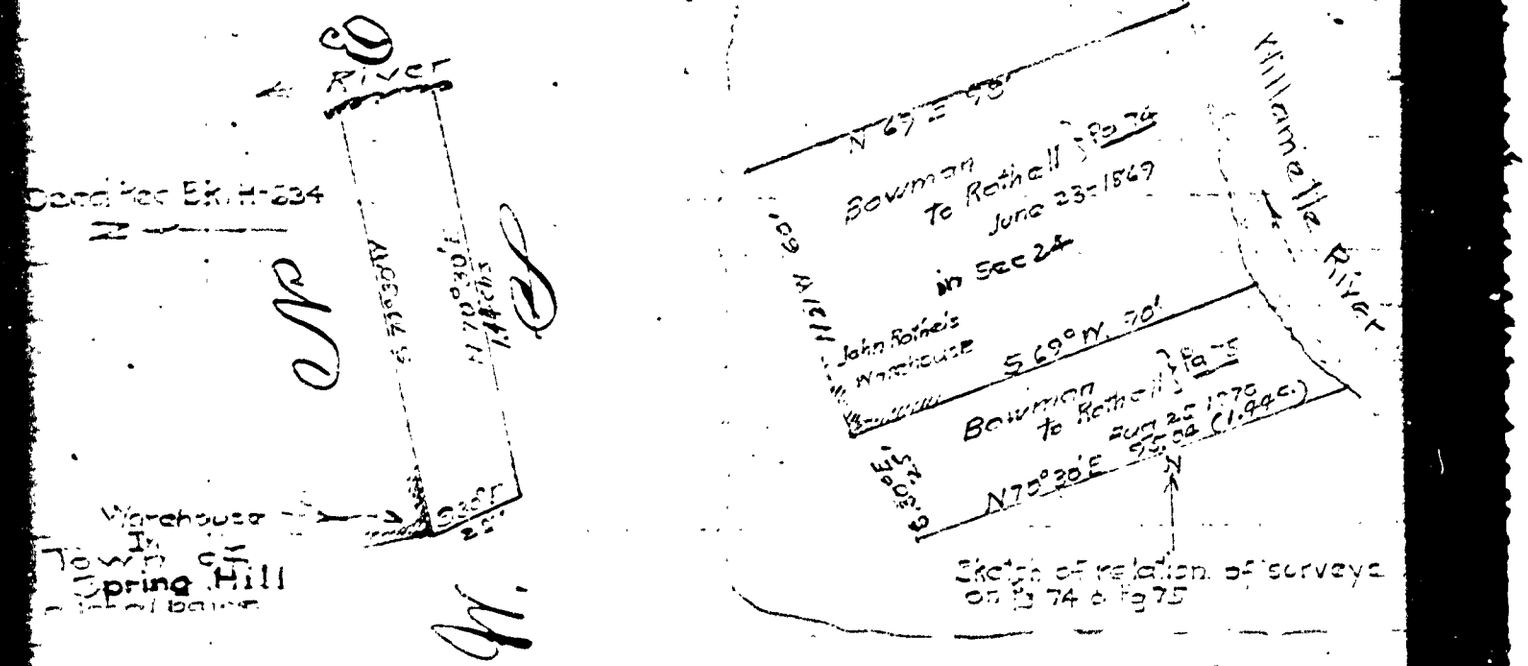

"Beginning at S. W. Corner of John Rothels Warehouse in the town of Spring Hill, in Benton Co, Oregon - Run S. 30° E 25 feet Thence N 70° 30' E. 1.44 chains to the Edge of Willamette River - thence along the Water edge to a point on a line parallel with the south side of said Ware House - thence S 70° 30' W. to the place of beginning —

"Recorded by me this 25th day of August 1870 —

B. W. Wilson
County Clerk