Book No 1
MINING
TRANSIT BOOK
363

77

Rice. 8/21 [illegible] Survey 17,

Length of E line 5-47.+16.5

#79

Dech, Aug. 21 [illegible]

12-11-34.4 — 49.9 — 7.2

5-59.2 — 998

12°-4'-35.2" — 3493

45.6 — 8.15

15.5'-20.8" — 359.2

37

59.2

Bearing of S. line S59-13'W.

Length " " ~~6.229~~ ~~111.11'~~

S 82°-30'W.

Length of N end 5.35 — 346.5'

Length of S " 6.067 — 109.36

North side 342.60'

S " 394.87

Length of West side 10.583

346.5 — 342.60 — 21 — 40.36 — 394.87 — 05.49

Hrs. 8½ for Rice

C

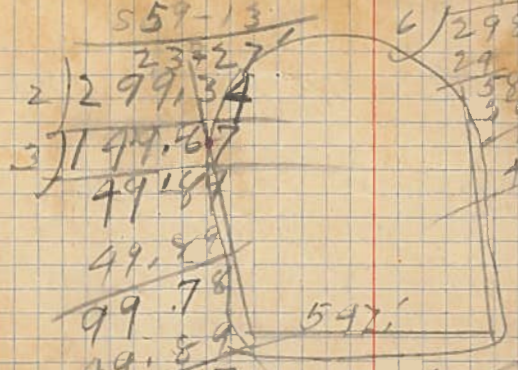

S59-13

23+27

2)299.34

3)149.67

49.89

49.89

99.78

49.89

49.67

150.

49.89

199.89

49.89

249.78

2)230.86

115.43

108.43

547.

16.5

563.5

2)275.5

137.75

106.32

14.85

121.18

1)299+16

150

149.16

3)49.72

49.72

4

99.44

99.44

49.72

149.16

528

190

132

580

528

52

49.83

6)298.98

29

54

34

49

15

49.83

49.83

99.66

49.83

149.49

49.83

199.32

49.83

249.15

49.83

298.98

108

14.85

230

66)563.58

528

35

330

2)299.2

3)149.73

49.73

A 49.23

49.46

A 49.15

Grove.

Plat of Survey No. 17 #79 Claim No. 40

Section N½ 3 Township 12 S. Range 5 W.

Scale: 1 Chains to the Inch.

Field Notes recorded at page ....., Vol. ....., Record of Surveys.

F.B. 1 — 77
Court " 3 — 6
see deeds for corners.

MADE FOR G.F. Rice

5.677
8.537
14.214

7

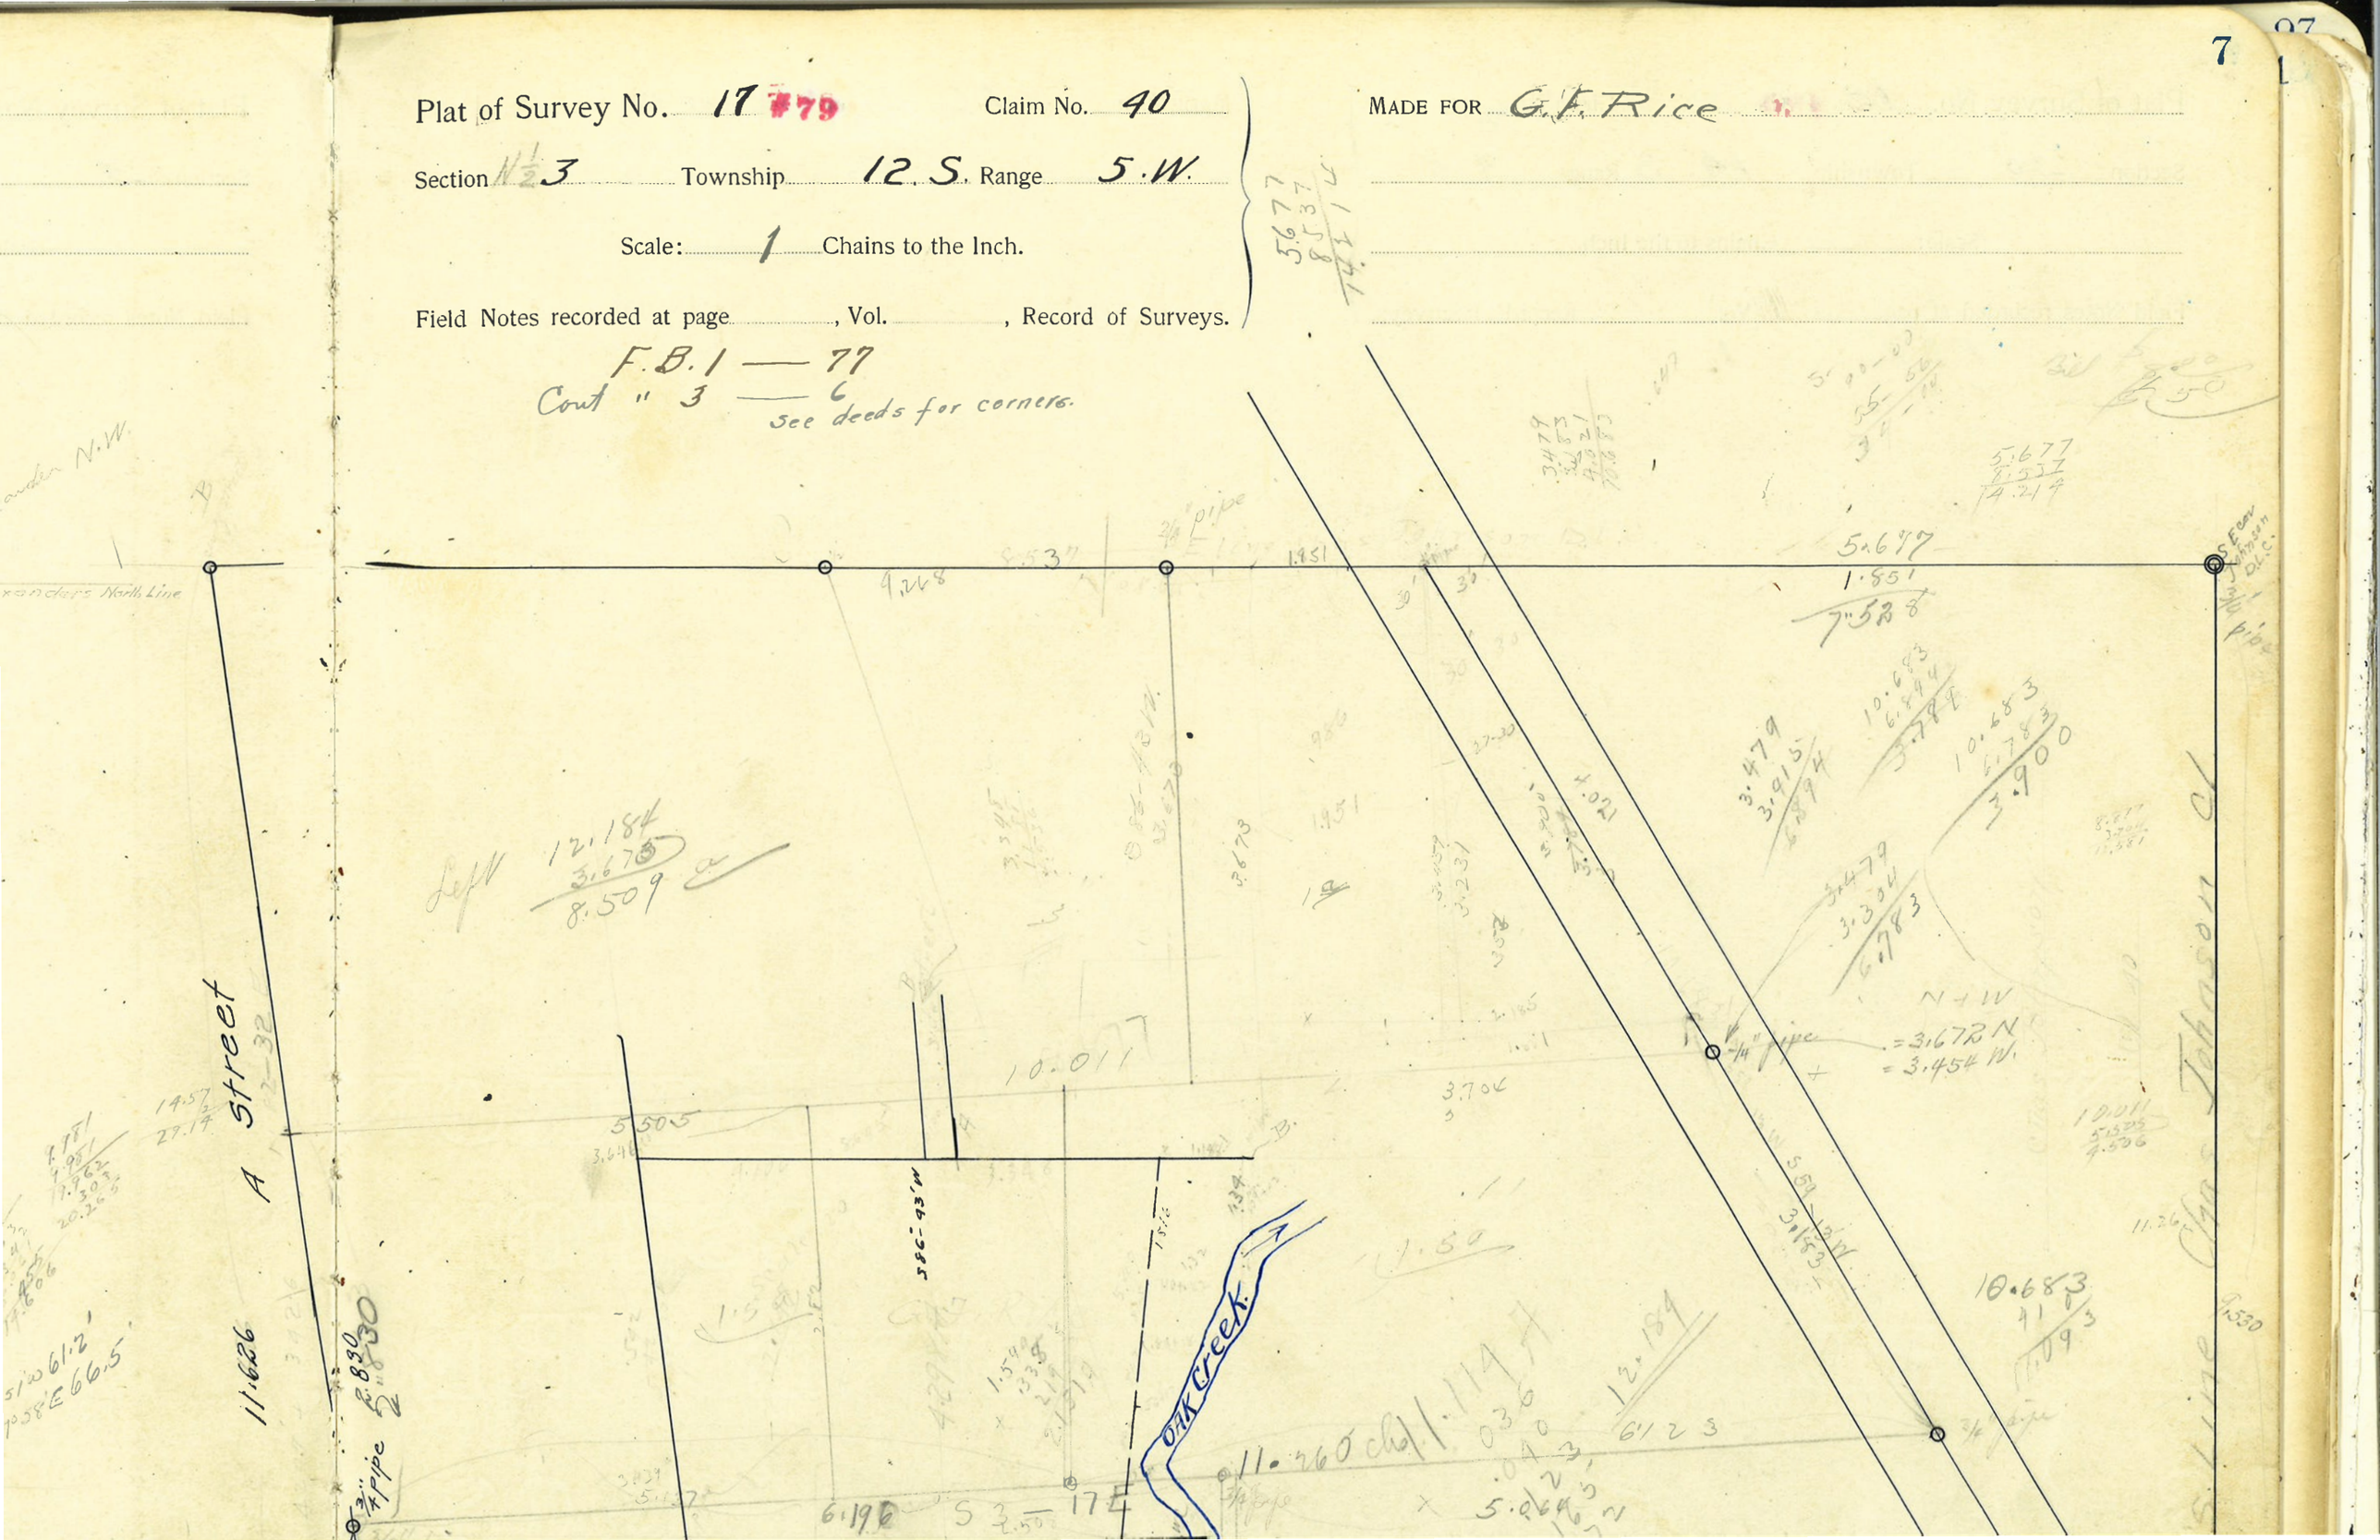

Oak Creek

Approx. Q line

Sec 2

Sec 11

Blank

CS-79

Walters' Sub-division
Rice Tracts - May 13, 1997

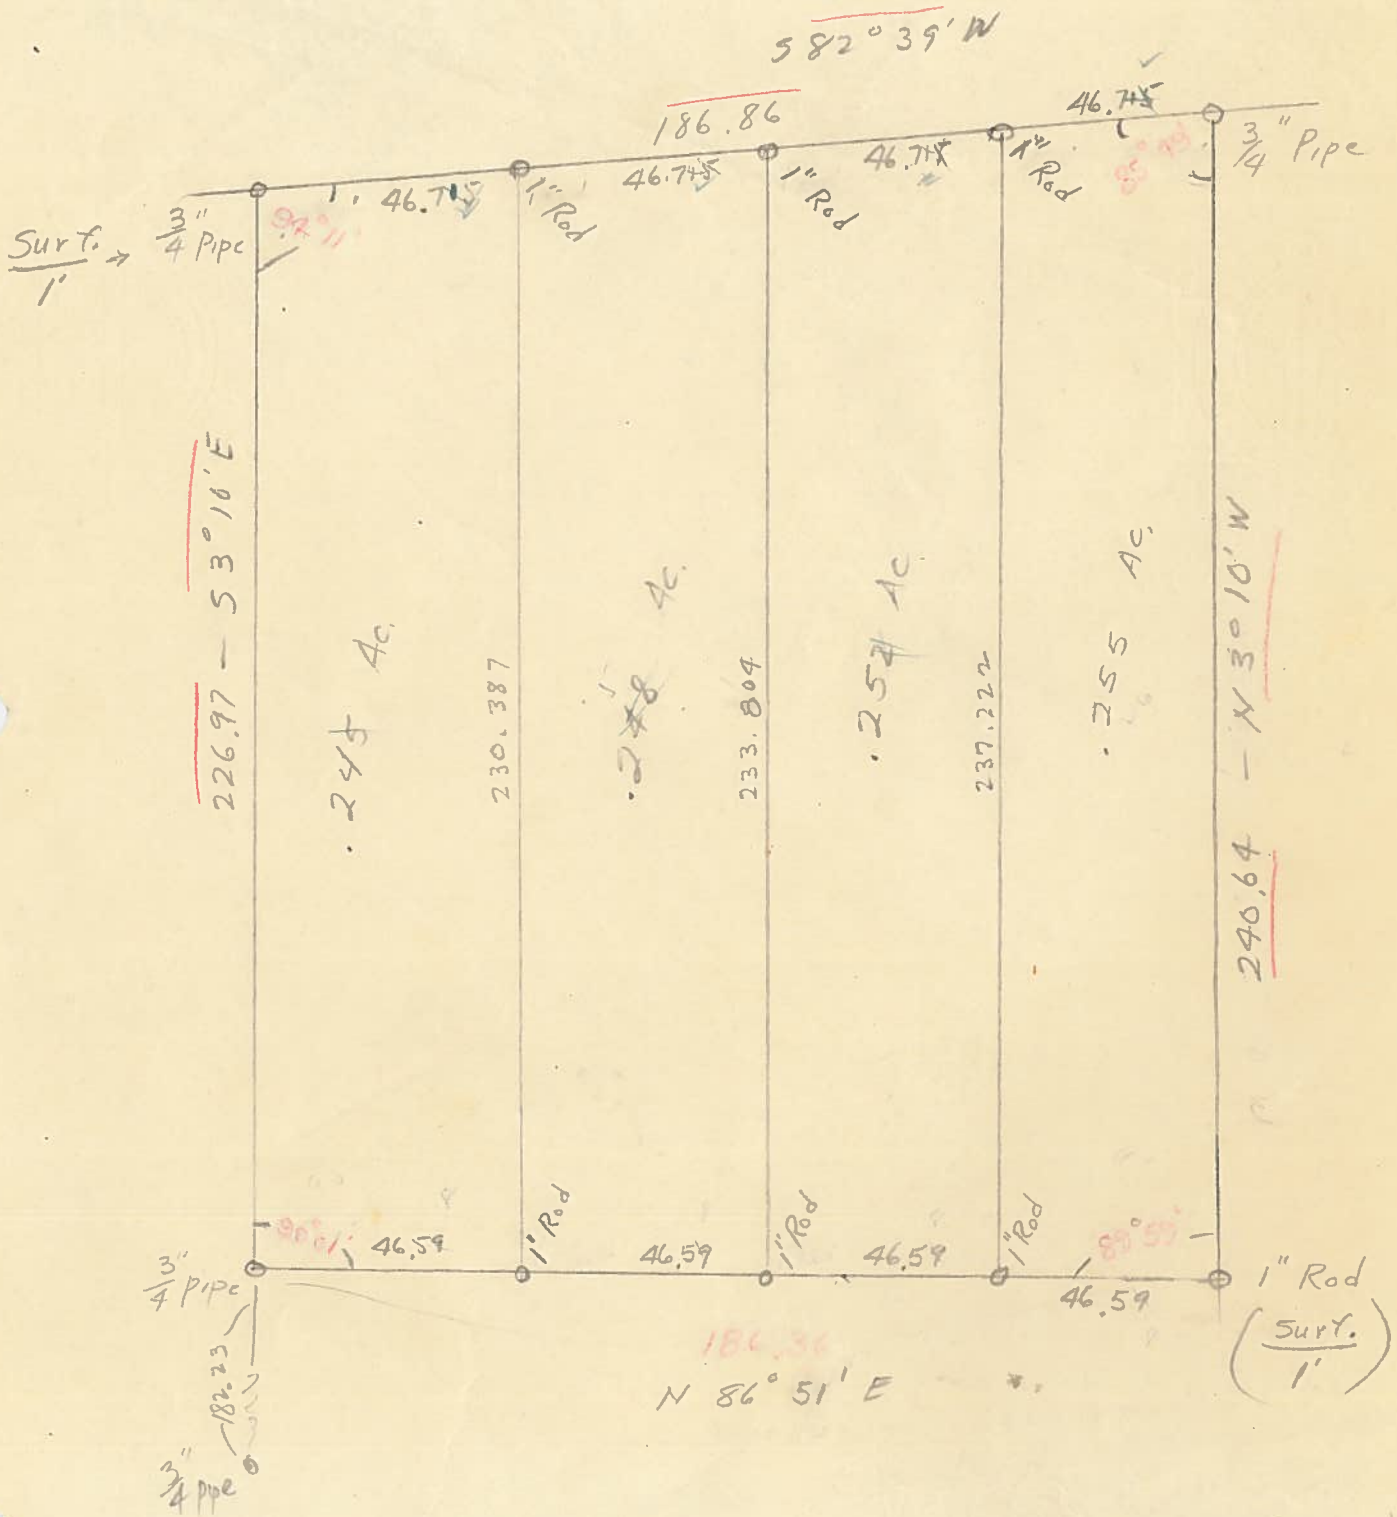

South Line 1' off given bearing (86° 50')