County Surveyor's Record, Benton County, Oregon.

'EY NO. 21 #84 MADE FOR J.J. Whitney.

Date of commencment of Survey Oct. 13, 1908.

After receiving notice from Mr. Whitney and giving Mr. Thamp due notice as provided by the Statutes of the State of Oregon, I proceeded to make the survey having Frank Perfect and myself as Chainmen and Mr. Thabp as miscellaneous help.

I reestablished the S.W. corner of Sec. 36' Tp 10-4. and ran thence S 71°-30' E 42.42. the calculated distance to place me 49.00 South and 40.28' East of the N.W. corner of the John Q Thornton D.L. C. #37. at 2626.0' Struck the N bank of Lake, at this point an line Lake is 379' wide.

I then reestablished the South exterior corner of the above claim and ran thence N. 109.2' to water edge, across lake is +287.' and to center is 252.7' from exterior corner, at a point 52.2' N of above corner I ran N 70°-26' E to point in county road and measured N 200.5' and continued line S 70-26' W to the waters edge at a point 13.03' from the center point in Lake.

I then went to the N exterior corner of the Thornton claim and measured W. 3°46'49' = 52.346' and put point on N line ~~1346.7'~~ West and directly on a line the proportionate part of the line to make descriptions and measurments conform to my 50' tape

I ran thence S. 34° E by sun 33.40' to a point in the lake setting a 1½" Section of Galvanized pipe. From which

a fir 36" in diameter	bears	N 74-55 W	87.3',
an alder 10" "		N 30-30 W	33.8'

I then continued my line N 70°-26' E from point near road + found it to be 2356.4' to corner and striking 19.2' Southerly from corner Giving me a correction of -15' to apply to line North. Corrected line back setting W.C. 3.87' N and planting a Sand Stone 16"x16"x4" with the following trees marked C.S. N° 21, B.T.

a Balm 16" in diameter,	bears	N 58°-45' W	20.5',
an ash 9" "	"	N 35°-45 E	40.8',
a Balm 20" "	"	S 78°— E	57.0'

after setting several points on line to the county road found that I was just about 1.5' South of an old fence, between the parties and from all old deeds and abstracts available I concluded that the line, which was originally surveyed in the fence was in reality as I placed it, The true length of line was found to be 4193.9' = 63.543 or 3.0' short. The true Bearing of line was found to be N 70-11 E.

Survey finished Jan 11 1908.

Latitude of point near road was 44°-38' N

Declination for Oct. 20, 1908, at 2 o'clock, 10°-25'-12.8" corrected for refraction.

Longitude is appox 122.2° West of Greenwich

True bearing of line N 70°-11' E.

Magnetic Variation 21°-33'. E J. Marion Wilkes
County Surv.

Weather very changeable but rain most of the time with the exception of Oct 20th in the afternoon.

Recorded Jan. 12. 1909
by
J. Marion Wilkes,
County Surveyor.

Plat of Survey No. 21 Claim No. 37

Section 1 Township 11S Range 4W.

Scale: 10 Chains to the Inch.

Field Notes recorded at page 27, Vol. 1, Record of Surveys.

J. & R. — 10

MADE FOR J. J. Whitney of Albany &
Establish Line between him & Frank
Tharp. Official Survey

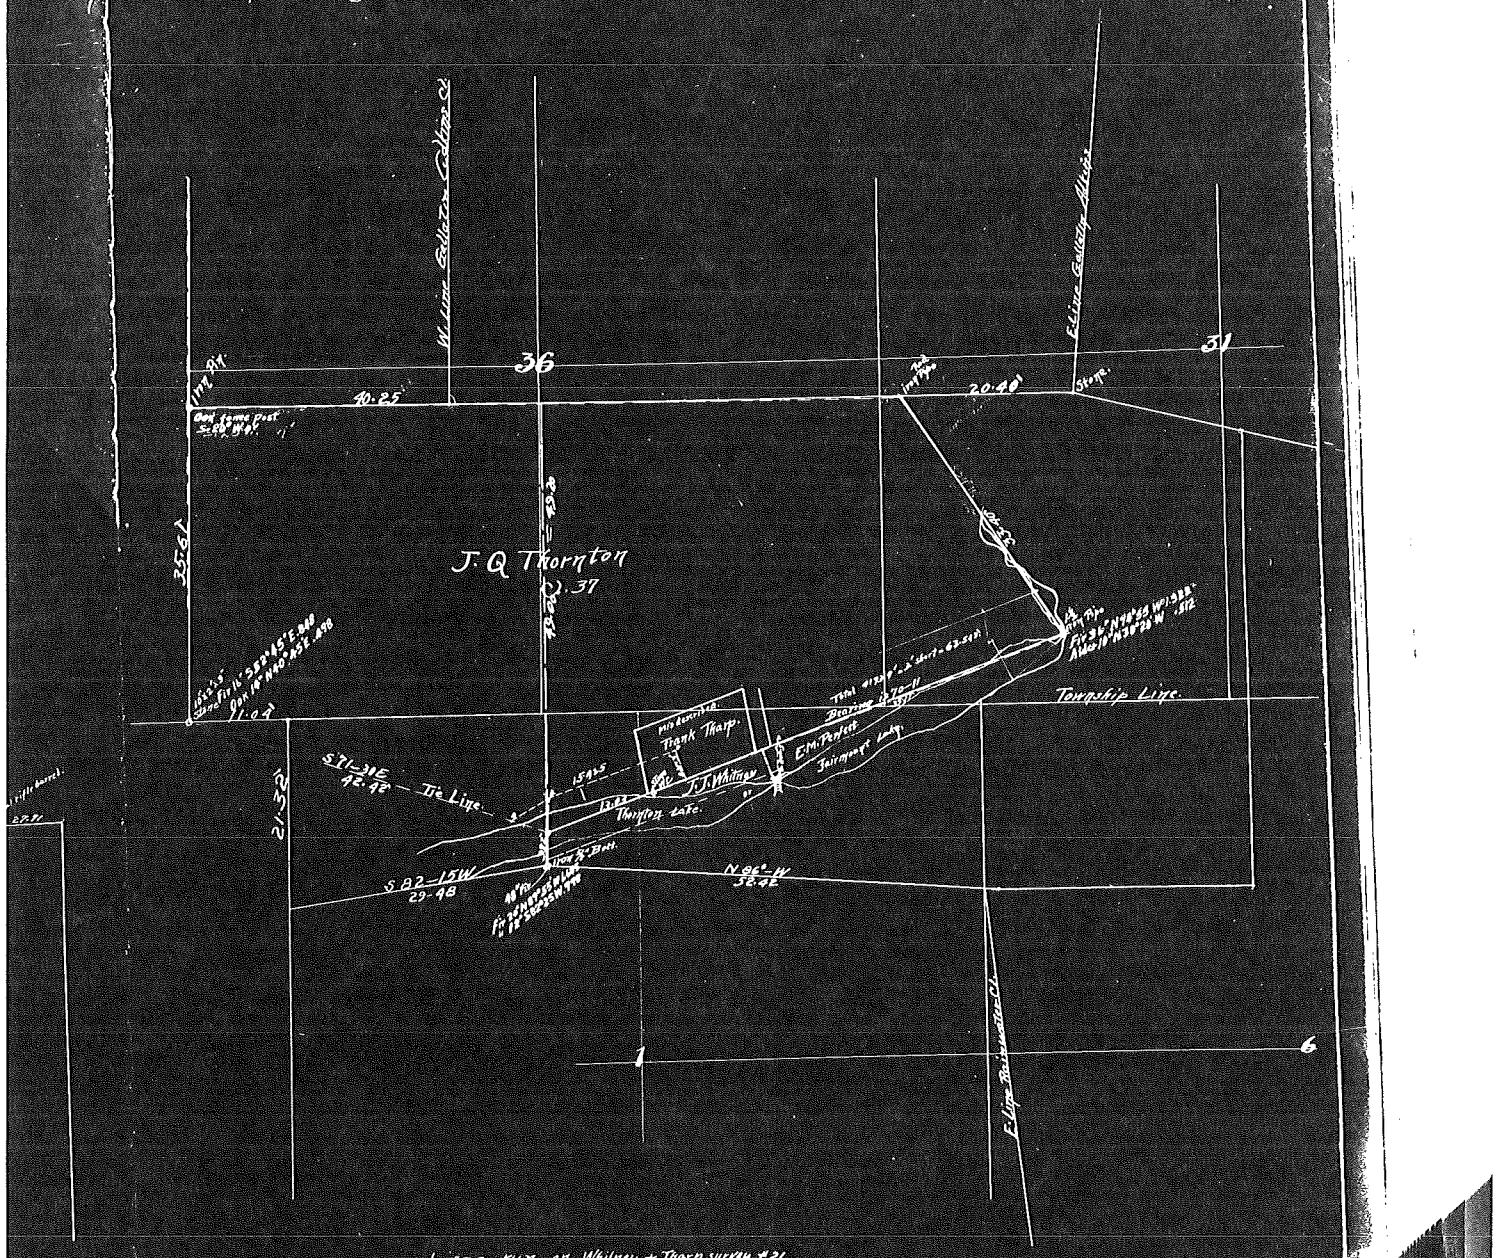

FB #2
10

#84

Survey No. 21 — J. W. Whitney — Albany — Oct. 13. 08.

Reestab. S.E. Cor. Sec 35

2 bb standing.

stone 10" x 12" x 3" — bk 19 — N 40-45 E 329

Fir 16" S. 52-45 E 56'

thence S 71-36 E 42.42

V 5-20		199.1	201
V 7-15		205.2	206.8
V 18-40	704.3	200.7	211.9
V 9-17		131.0	132.9
V 4-00		93.6	93.9
V 6-16		221.4	222.7
V 5-25		107.9	108.4
V 13-25		70.0	72.0
V 20-55		140.0	149.9
V 12-45		145.6	149.3
		1814.5	
Δ		739.0	
		2553.5	
−		72.5	
+	watersedg. across lake	379.	

Reestab. S bdry corner: 96" Fir

N 44½ W. 2v. N 88-55 W. 111.1'

" " 12.5 S 2-25 W. 65.8

Δ thence N 89-25 E 76.8 75.6

-23.6 " V 40 Waters edge 110.0 109.23

" N 44½ W 287. 143.5

Δ thence N 44½ W 1114.7'

11 Went to Bridge N 70-26 E
Post N. 200.5
Went To Adkins S.E. cor
Thence W 20.38 = 13.45 W.
Measured, 13.372
Thence S 34-12 E feet 1459.25
to a E 174.1'
Thence 747.2 feet W 174
Line strikes S 119.2.
Set Corner on Bank of lake - 1½ iron pt
Fir 36" brs. N 53 W 83.5 = 87.3 ft
Elder 10". N 38-30 W. 33.8 Marked
N 22-15 W. 33.2 7.9 Back E.
Post

Length from A on line at 2356.4
Corner West + 450.0
+ 271.0
To West line + 2.6
Total to Line 223.3
15
238.3
Thence W. on line 1018.1'
This is 8.2 chains West of Whitney
BM N.S.W. ∠ Left 80-40 = N10-W 46.1' = 8.39
Angle at this ∠ Left 15-43-35 = S3W 291.5
Correction of this line is N — 15'
to W.C. W. 233.8
for W.C. set Stone 12 x 10 x 4
Balm 16" N 58-45 W 20.5'
ash 9" N 35-45 E 40.8'
Balm 20' S 78° E 57.0

110.
4. 27 6
2/3 27 6
130.3 2
20.3 4 6 8
1 2 2 2 8
1 2 2 2 8
5.0
134
233.8
1012.3
1009.7
178.5
63 400
31740
2335
447
3.394 2
100
1012.3 400
63
404.9 3 6
3 0 7
1012.3
370.5
1382.8
135
1382.5 41
63
1569.0
9.
3 1 4 9
5 5 4 8 2 9
6 0 2
2356.4 3
1753
8.3'
6.2'
4.9'
Time for Whitney
3½ days
1753.3
63 400
7 0 1 3 2
7 5 2 5 1 2
1 0 4
4 6
Line shortened back the WC = 233.8
Line shortened back on 8601
= 387 to N. to WC

12

N. 138.2 2.093
W. 210.4 +.6 3.196
S 141.5 2.143
E 209.6 3.175

For W. B. Small.
Area 6.7458 Chs.
.67 Acres.

W. B. Small.
1½ Hrs. 75¢ pd.