C.S. # 95

F.B. 2-40

#95

Survey of Nixon Place.

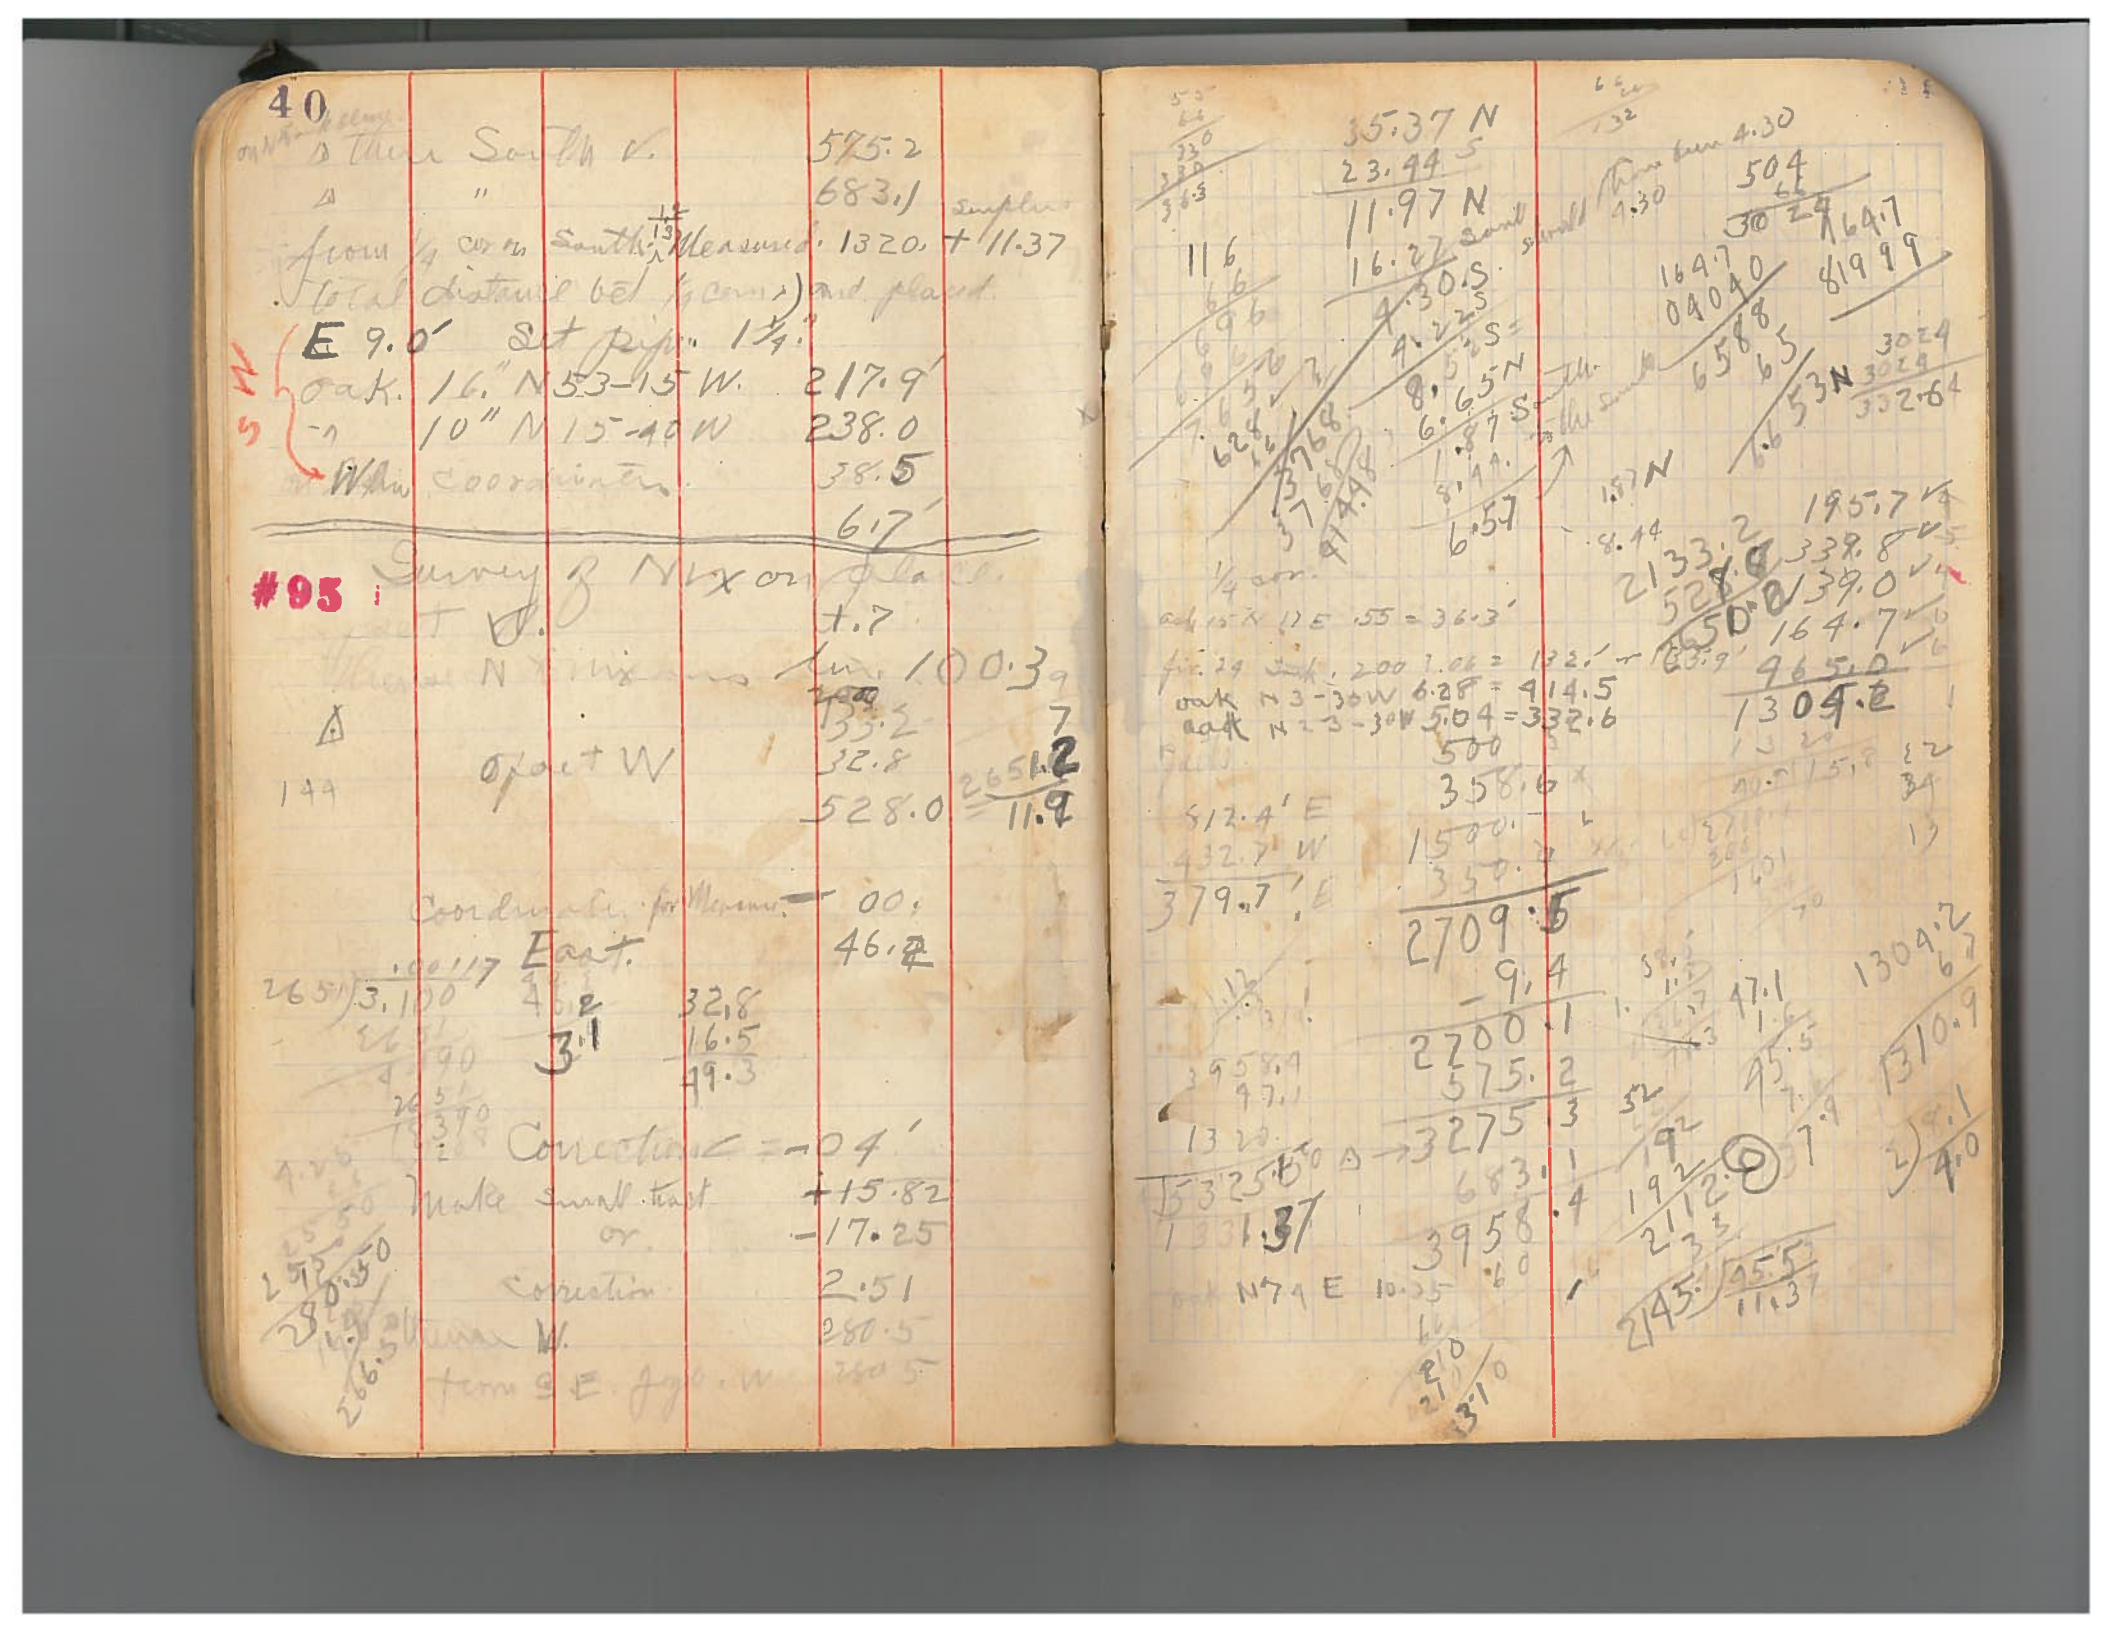

41

from SE Cor Sec 9 N on line
Pillow E
Set 15. Smith
(2115.0 + 68.7)
△ 11
went to ½ Cor 20 - Smith. Iron ¾" rod
Bearing: mkd fire 15" N3½-30E 31.
from ¼ Sec Cor. 1302.7 - 24.7 △
Set pt on line 32.9 from △ calculated
Correction angle to N - 28' to set on line
Set W.S. on Bent by Stone + Cedar stk.
dist. 30" S 64-30 W. 19.5
dist. 16" N 47-20 W. 60.8
Bearing & distance from
for Chas. Brown + Taylor
for Peter Brown ¾ deg.
Switch, ¾ + ½ + ½ + Maxim.
23-13-04
1-21.5
23-15-25.5
2-25.2
23-12-00-3
Sat.
45-36
1-09
49-27 Pat.
9.06
8.54
2115.0
68.7
2183.7
476.8
2660.5
40.31
Mag Var 21-50 E

= 13° 22'
.2375
20. 4.750
93.07
S 3-15 W. 12.1
2115.
68.7
2183.7
from ... S.W. to Sec 1349.8
1349.8
97271
13448
94136
26896
74136
10.32
100408
8.
2115.0 32.90
2115
.0150
2183.7 32.900
21800
11000
10985
181.2
315.6
315.8.0
105264
2631
10.795
1302.7
24.7
1278.0
1311.8
19279
121032
7415
268
121
1308.1
1278.
30.1
2.6
32.7
15
17.7
.005 = 28'
2183. 17.700
17464
4360
10.79
15
315.79
1 3/4 3/6.
5 3/4