C.S. # 96

F.B. 2-44, 3-13

44 #96 C.T. & Weir. Cl. 39 Cor. -7 T10-5

Resist Julien NE

Chain 981-45W 1 foot

" S 14.8

" S 00 377.8

3-30 214.3

= 340.7

7-00 242.4 1184.5

8-30 329.2 =2014.21

7-15 482.0

25.2

50.5 = + 2213.01 —

Utica South

+14.8

102.3

Sun Rises 27' 7-00 288.2

11-10 500

— 500

— 160.6

— 146.0 1701.2

-5-00 500

Stake + 21.2

— 511.7

4- 241.8

+11-40 217.5

+7-30 111.0

-5-30 234.8

+7-31 283.6

7-40 500

14.8
102.3
287.5
490.0
500.0
160.6
146.0
1701.2
498.1
2199.3

Survey # 29 #96

S 00 West 1.5

377.8 S 5° 45' W 142'

72099

34002 3.2

3400 7-00

7 247.4

2374.11 55.299

3-30 22266

214.3 19801 2226

31849 1184.5 49

19467 795.5 12

1946 1

172 1980 245.54

2 32

21589 8-30 13

329.2

0989

2628

2633

296

325.57

7- 4820

0299

13380

4388

56

7777

1987.8

2013

25.2

2199.3

511.7

2711.6

2640

1.71

374.12
215.90
349.70
245.56
325.59
478.14
1989.01
102.30
287.50
490.54
500.00
160.60
146.00
498.10
2185.04
511.70
241.21
213.01
110.05
233.72
281.17
495.53
4271.43

-.7

374.1

373.4

215.9

349.7

245.5

1184.5

325.8

477.7

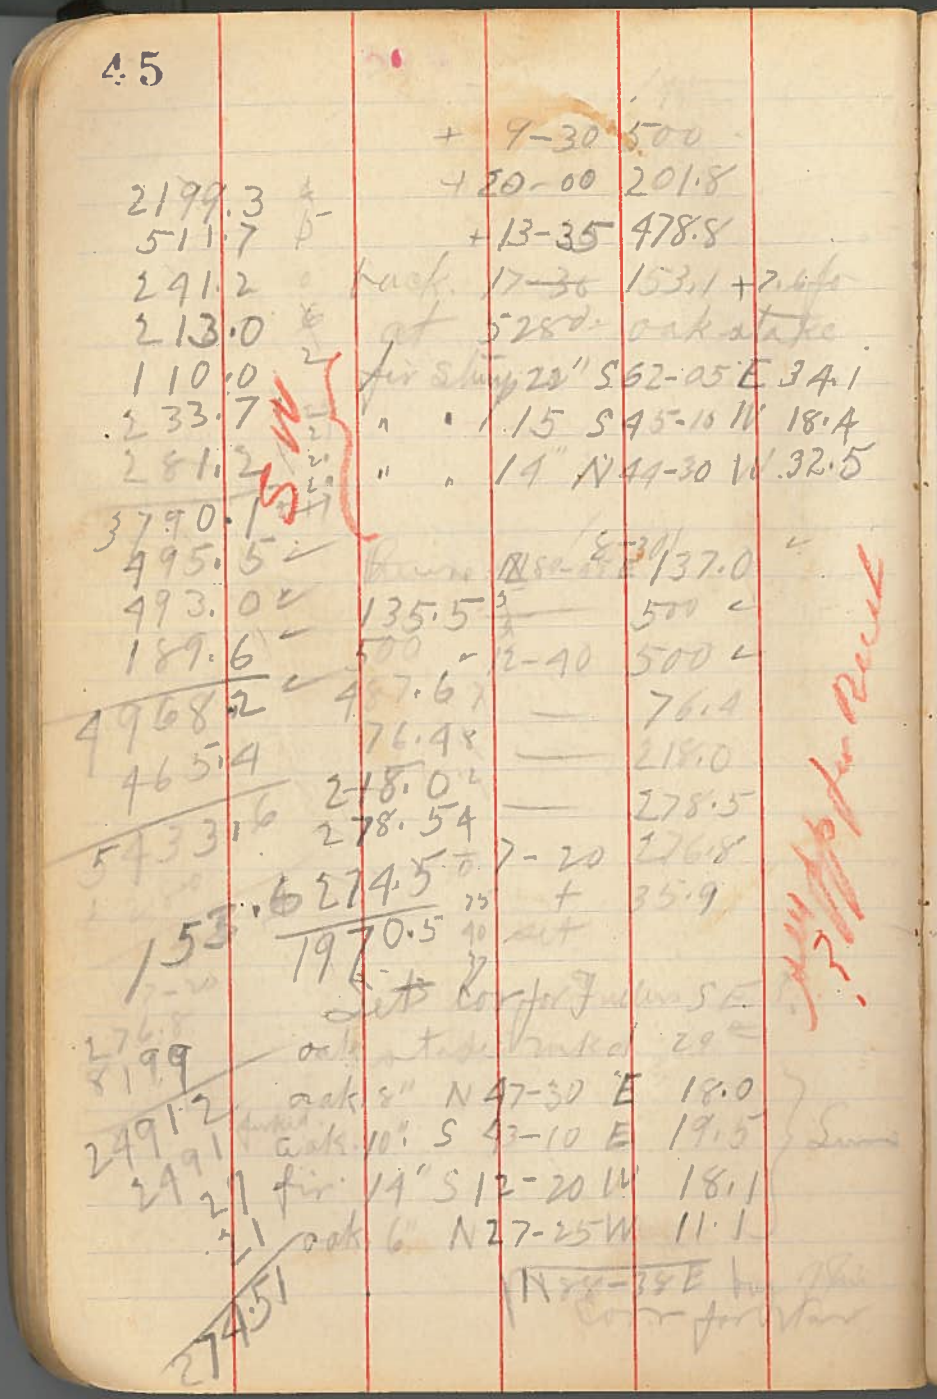

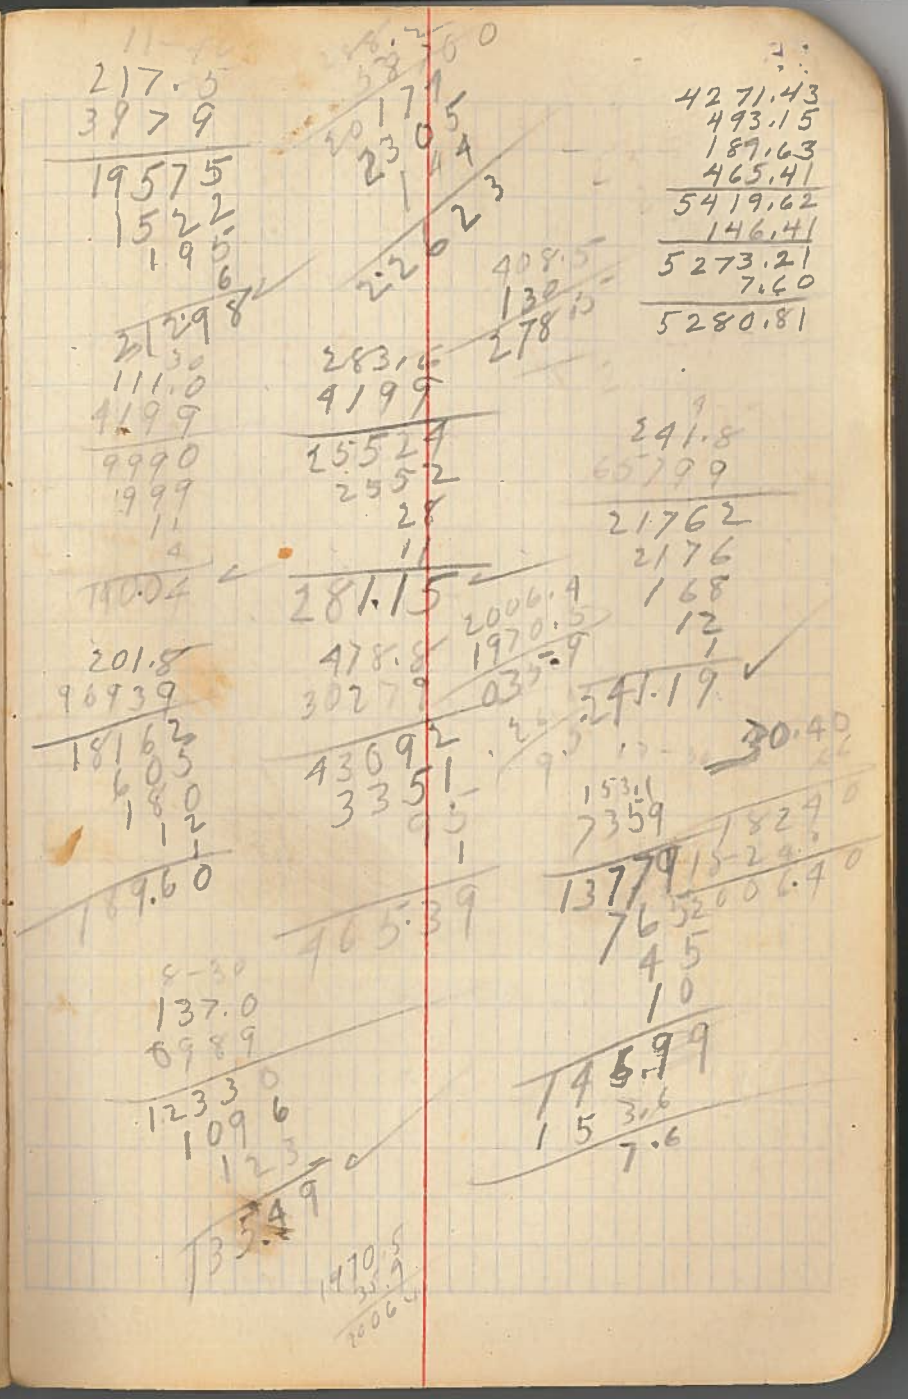

178.0
116.6
287.0
581.6

181.0
5379
1790
2167
905
57

Curve
Back tk
Sta. 10" S 85° E
Back tk N 82° W
Sta. Ahead

107.8
5789
9702
8627
751

40 Curve
Back tk
Sta. 12 S 7° W
Sta. 12 N 83° W
Back tk
Sta. E

234.9
176.5
106.4
134.5
652.3
450.2
7.7

5-81.6
78.9

∠ R 28°
11
II

∠ 2-53
II
∠ R 12 13'
II

+ 26.4
-5-30 239.0
-10-30 165.6
-11-10 211.5
-13-17 209.
-19-20 275.6
-5-40 167.3
-7-30 134.5
-15-12 202.7
500 2765

Chain back 766 ft or 20 rods

18.5
9.6
+ 178.0
116.6
257.0
780.6
22.0
27.7
-8-00 237.2
-12-13 121.0
-9-10 107.8
-9-36 139.3
Chain ahead 717
Back tk bk. 29.54 1-30 E
Sta. N 5 30 W

660
32.01
22.8

211.5
3979
19035
1480
190
6
207.1

80.0
95545
74.4360
7440
1.0 .00931

78.4
880 50
3920
6 2 6
3988

139.2
360 9
1253 2
835
83 4
134.54

27
39 36
17

20217
0569
18243
1216
101
195.60

207.1
198.1
166.8
166.6
132.9
13 93.6
197.0
1396.6
196.6
16.6

78.4
13
5 32

237.2
209 9
2134
21 34
234.8

26.4 8
235.7 8
163.0 1
197.0 8
207.1 7
198.1 1
166.8 4
166.6 1
132.9 4
36
53
49

195.6
137.9
333.5
99800
26080
1349
134
1755.4

Thence South

198.7
279.9
231.2
152.0
861.8
342.9
380.2
1584.9
104.1
176.6
335.4
266.0
163.2
168.9
2699.1
120.8
104.0
72.7

Left 9-00 / 13
5-00
+4-00
+12-
13-45
Left 2-40
22-45
10-35
12-00
-15-32
+12-35
-7-05
-9-30
10-20

198.7
279.9
231.2
152.0
3922.
381.7
104.1
176.6
335.3
272.0
167.0
71.8
104.0
72.7
122.9
101.8
104.1
108.0
191.3
192.8
461.0
370.0

From M.M.R. Savage to
2 1/4 days
2-1

2 1/4 @ 5 3 —
11.25
$17.25

Paid

Continued on Page 130 of FB No 3

347.2 1589.9
91330
2249
3 1248
3777
342
29
342.87
87300
10487 149.0
2400 3179
273 15130
1960 1169
16
4
163.19
122.9
97289
11061
983
24
11
120.79
79900
108711
9643
1077
19761
2699.1
104.0
72.7
120.8
99.6
100.3
105.4
179.8
190.1
452.5
4134.3

3 1199
3 353
3 335
228
3
38 0.19
E
1.30
3.21
4.51 E
1.19 W
3.32 E
3.17
1.02
0
8
43
55
21

336.3
5299
30267
3026
235
16
330.99
272.0
187
24980
1904
217
2
266.03
7.5
2229
6732
149
14
8.95
3.40
27580
4137
349
20
3208.1
62.64 obs