Plat of Survey No. 33 #102 Claim No. 44

Section 9, 10, 15 & 16 Township 14 S Range 5 W

Scale: 10 Chains to the Inch.

Field Notes recorded at page 40, Vol. 1, Record of Surveys.
Field Book 3 - p. 2

MADE FOR Johnson, Bryson & Reed.

BOOK No. 3

3

2

at + 54.1 Oak 68
at " " " L 85
at 41. Ange P. 25°
at 67 (to) Angle L 45°
Witness from corner 66.2'
to road bank direct. -14-
and from L plum Road, 188.3 set W.C.
" " a Crab 7" " S61-30E 46.1
" " a Hick 12" " S62-15W 107.2
+ + 42 edge creek.
+ 46 to centre.

W.C.

Time 3/4 da. Paid
Calculation 2/17/08.
For Andrew. 2.5

14-5

#102 Survey 33. 2/1.09

Beg at NW. cor. Stone lying on top of ground and West 21.1' 4 5.8
2570
313.1
500
E 20.6' 933.2 ½=2826 +E 16.2
2570
E 18.8 s.s. 339.1
-5.0
Sod Stone Planted. 5652.0 85.636
Corrected E-03' + thus E
-18.8

9.33
1616.2
544
227
1900.
1950
240

1000
18000
7109
8710
7604
10,060

1900.9
132
580
528
529
528
100
2/5652
2826.

2834.1
933.2
1900.9

Stone 18 x 14 x 6 24 — 9 1.

21.1 Stone
This stone = 5.25' to far E
20.6 Stone
28.801'
18 Stone

2818.9
2834.1
5652.0
528
372
330
420
396
240
198
420

85.636

2813.1
5.8
2818
178
132
469
10

18.8
2.6
21.4

Johnson, Bryson + Read.
good?

2834.1
5
2834.1

5652
49000
49868
2260
339
5.2467
2.62

18.8
2.6
16.2

5.8
2500.0
313.1
2818.9

18.8
21.1
39.9
19.95
2.6

2834.8
2818.9
7.1

2.3

Correction factor

Δ angle R 15 ← { − 331.5 = dist
230.3 12303
+ 183.1 +
207.7 +
217.6 +
149.4 +
397.4 + = 2305
120.4 +
494.9 + = dist N 34.67
889.5 +
173.7 +
182.4 +
500. +
253.1 +
1.1 = 4998.4 = dist N 52.60
52.6
1049.3

S .59 N
S .25
S .6N
S .6S
S 1.39 Plus + 15 Correction Term
3.5 5
9.1 S 41198
46.2
47.2
48.2

Correct line in S03' + maint.
South 52.6
Point S.E. on S. plow standard
S on anchor post 18.6
Fence E 9'.
Course N by fence
East 45'
Point
A
Off Down Cor. 322.2 +

331.5
2303
561.3
= dist 2.45 S 63400
2245200
1683
= dist 1.93 S 336
24471

Down all B.T.'s
and 20 N 60 30 E 5.00
and 9 S 82 E 3.50

1230.30 494.9
1831.4 50070
207.7 34643
217.6 24
149.4 34667
397.45 2.45
120.4 1.93
493.8 54.38
889.5
173.7
182.4
500.0
253.1
5818.3
4998.3
-19.9
4978.4 = 75.43

34.67
4.38
30.29

207.7
13900 .00931
186300
623
20
1.933

A5.0
1.1
A3.9

Correction = 19.1 S

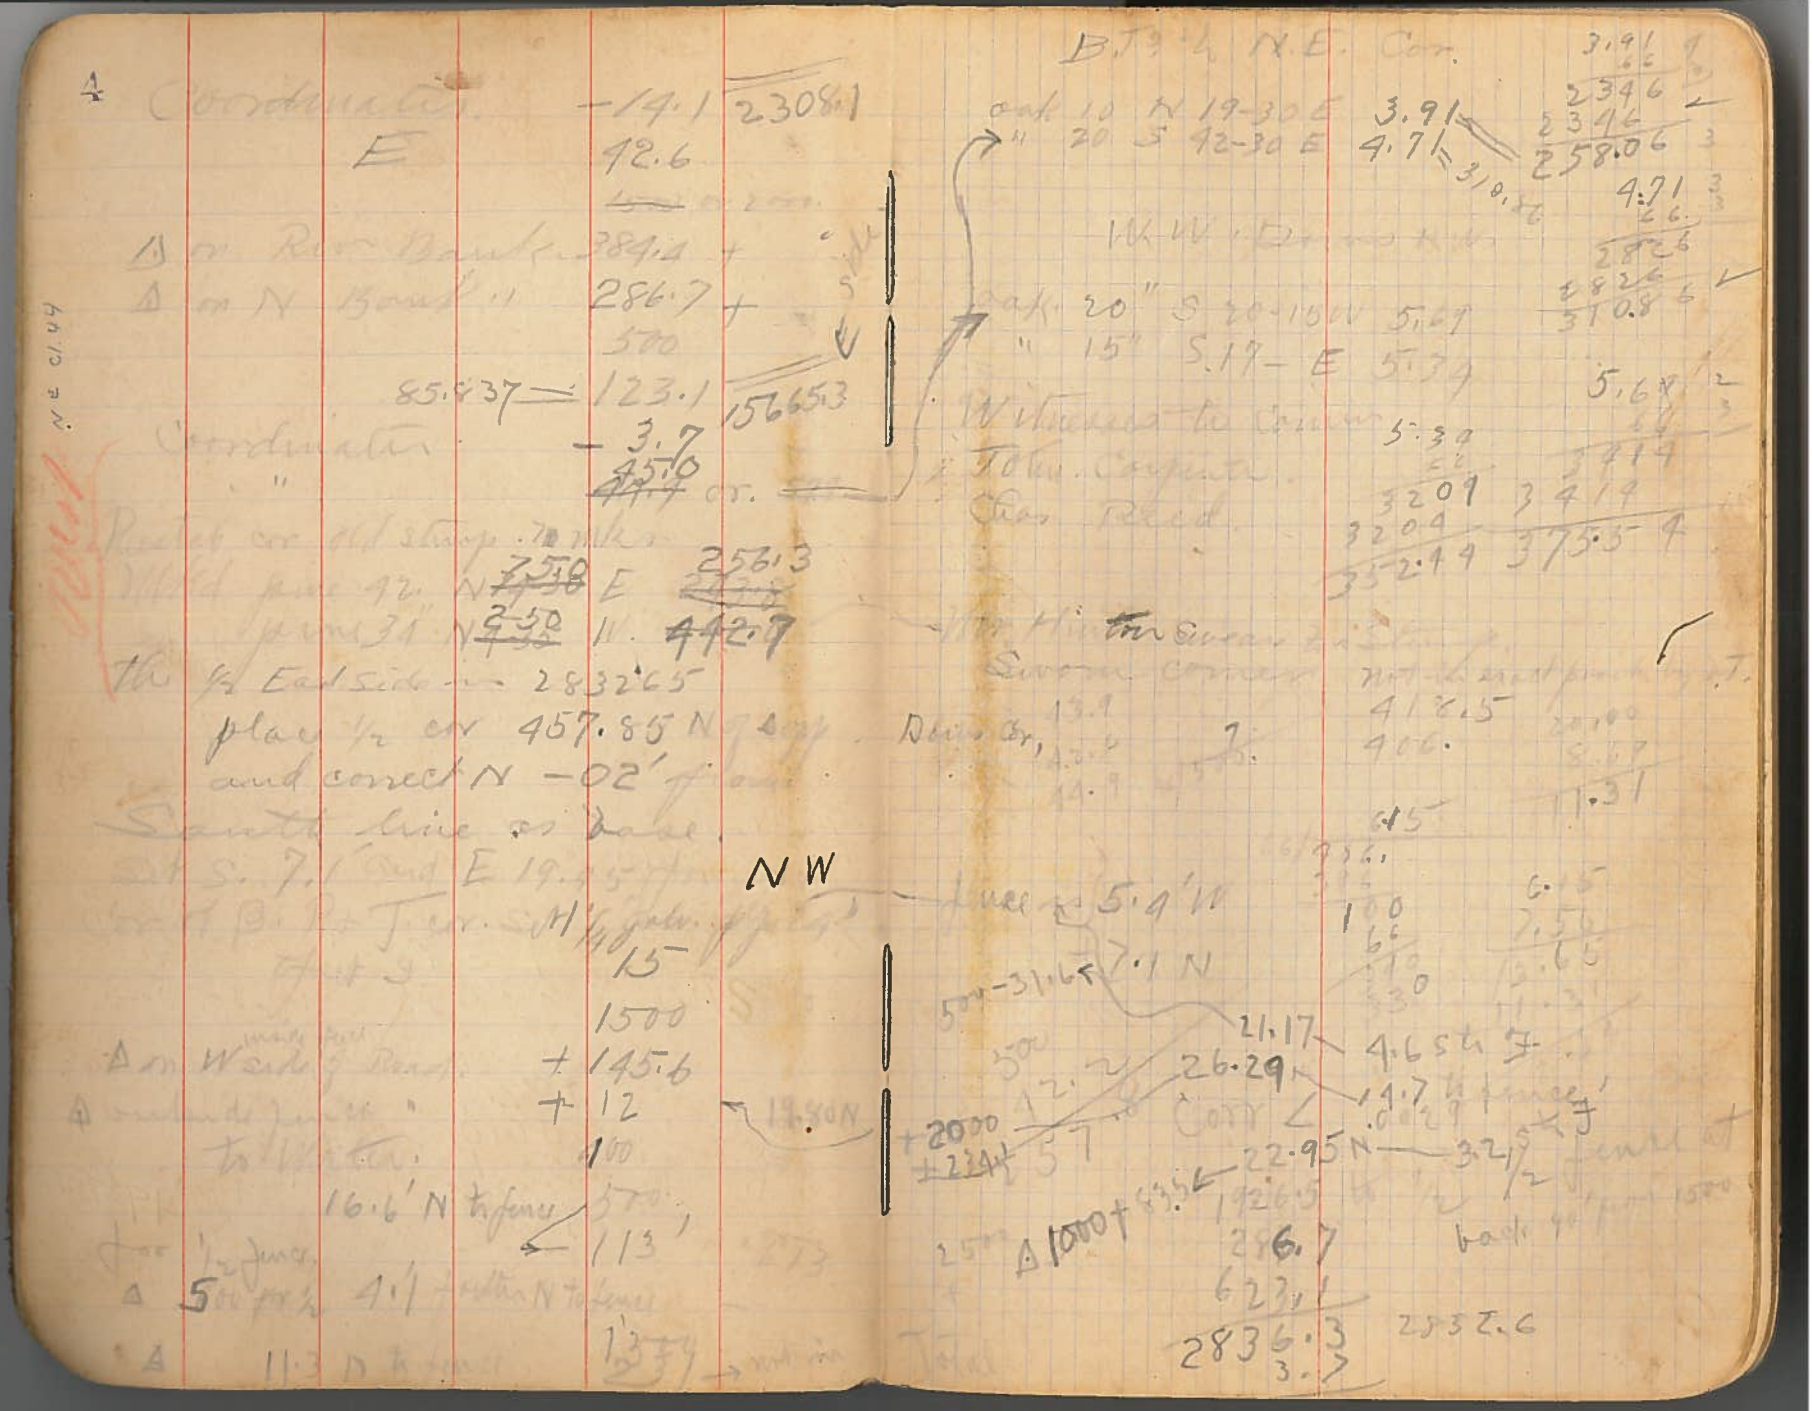

5

NE 1/4 5 1/2

Paid

Time stage

Road Survey

for 5 A. Mean N 5.71 ch.

= 376.86

382.67

Paid