RICE TRACTS

IN Chas. Johnson Cl. No. 40, T. 12 S., R. 5 W.

103

Scale 1" = 300 Chs

C. & E. R.R.

Philomath Road

S. Line Chas. Johnson Cl. No. 40

S.E. Cor. Cl. 40

E. Line Cl. 40

Mary E. Dunn 54-235 3.00 A

Michael Stuber 59-81 N½ 54-135 2.94

Mary F. Lowell 54-135 400-2.99 A 2.00 A

Leo Stahl 52-406 1-A.

Robert Leder 54-237 1.44 A

Gustave Leder 52-460 1-A

John Stahl 52-405 1.5 A.

Wm. + E. Wegner 57-64 - 4 A

Adolph Leder 52-600 2 A 8.60

Fritz Beck Sr. 54-140 5.00 A

Wm. Park Joseph 52-385 2 A

Fritz Beck Jr. Cont.

O.S. Norton 54-364 Part of 9.273

O.E. Trout 59-281 -

R.H. Stoner 54-390

N. Tartar 52-427

G.M. Beeler 52-435 less 54-438 " 52-609

Hattie Wilson

C.F. Noakes 54-438 1¼ A

E. Norton Cont.

M+L. Bartholomew Cont

Rorick Cont.

Fred Naller 52-404

H. Holmes 54-602 S½ of E. 1.00 A 2 A

A.A. Wirsing

W.H. Homersley 54-587

Anna Stahl 52-419 W. 1.147 A. of 52-404 1.147 A.

A. St

B. St

F.A. Dann 57-601

C. Van Hine 60-167

O.E. Trout 59-281 3.00 A

W. Koenig 59-612 1.22 A.

J.M. Conner 4.50 A Contract.

E.H. Meier 57-606 1.00 A.

F.W. Strong 2.675 A. Contract

W.S. Alcorn Cont. 5.00 A.

O.J. Blackledge

Pipe

71

BOOK No 3

6

#103

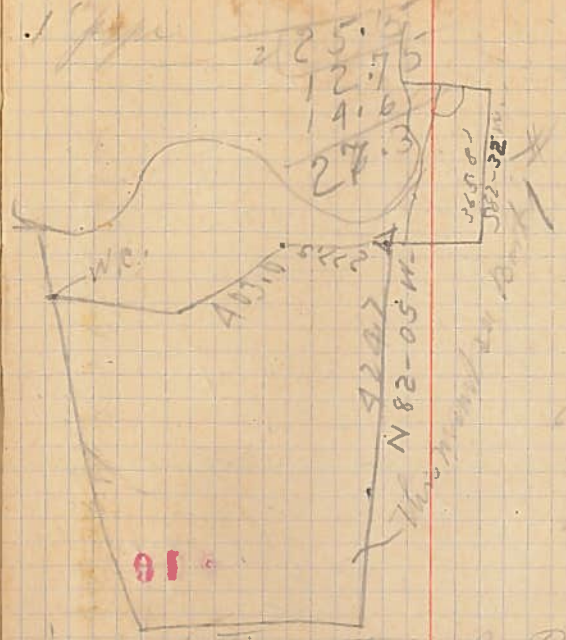

7

+43.8 Fnd R. 28.0 18.0

Thence S 15-38 W 205.3' to W.C.

A Cat + 52.0 Quail R. Co. R

Cat + 148.0 9.0 25

+ 19.6 23.3 Cu 16.

+ 47.7' 27.0 18.

for Point of Beg. see other page.

Thence N 54-13 E 705.1 to Alpha

Time 6 hrs.

Plat 306 Rec'd

Portion of Boundary. # 26

#104

From N.W. Cor. of Hedges

Thence S 63- 30 W. 30.

N 41. 297.5 = 4.507

" N 36-41 E 446.7'

" -2-30 500

" " 112.8

" " + 23.7 = 16.403

From N 29-30 E 1-40 500

to plum Road. 140.9 = 9.683

Time 1/2 @ 500 2.50 Paid

Paid.

8-00 8.60 4.81 4.89

3.19 1.388 4.55 4.53

4.81 9.388 9.36 9.39

456

5.265

16.

705.1

451

396

550

5-28

2-30

446.7' 3

- 499.5 0

+ 112.7 2

- 23.7 3

1082.6

4-40

500

498.2

140.9

639 9.683

574

451

342

550

52

2.40

2.94

3.15

6.51

5.537

.057

11.079

456

11,537

3.092

8.68

21.65

31.53

15.76

49 71

1576

1103.6

4626 .545

30.0

269

340

330

30

5.533 Sand.

1.072 Stabl.

3.46

15

.311

23.69

19.000000

16 0390

296100

240585

355150

481170

739800

4.507

33.7

297.5

264

330

330

550

16.403

1082.16

66

422

396

266

264

200

16.403

4.507

20.910

83.64

Pond

459.2

117.60

15946

13184

7943

28

+3.3

2.907

10.99

10.219

.22

8.00

2.219

10.219

CS103

RICE TRACTS

IN Chas. Johnson Cl. No. 40, T. 12 S., R. 5 W.

Scale 1" = 300 Chs

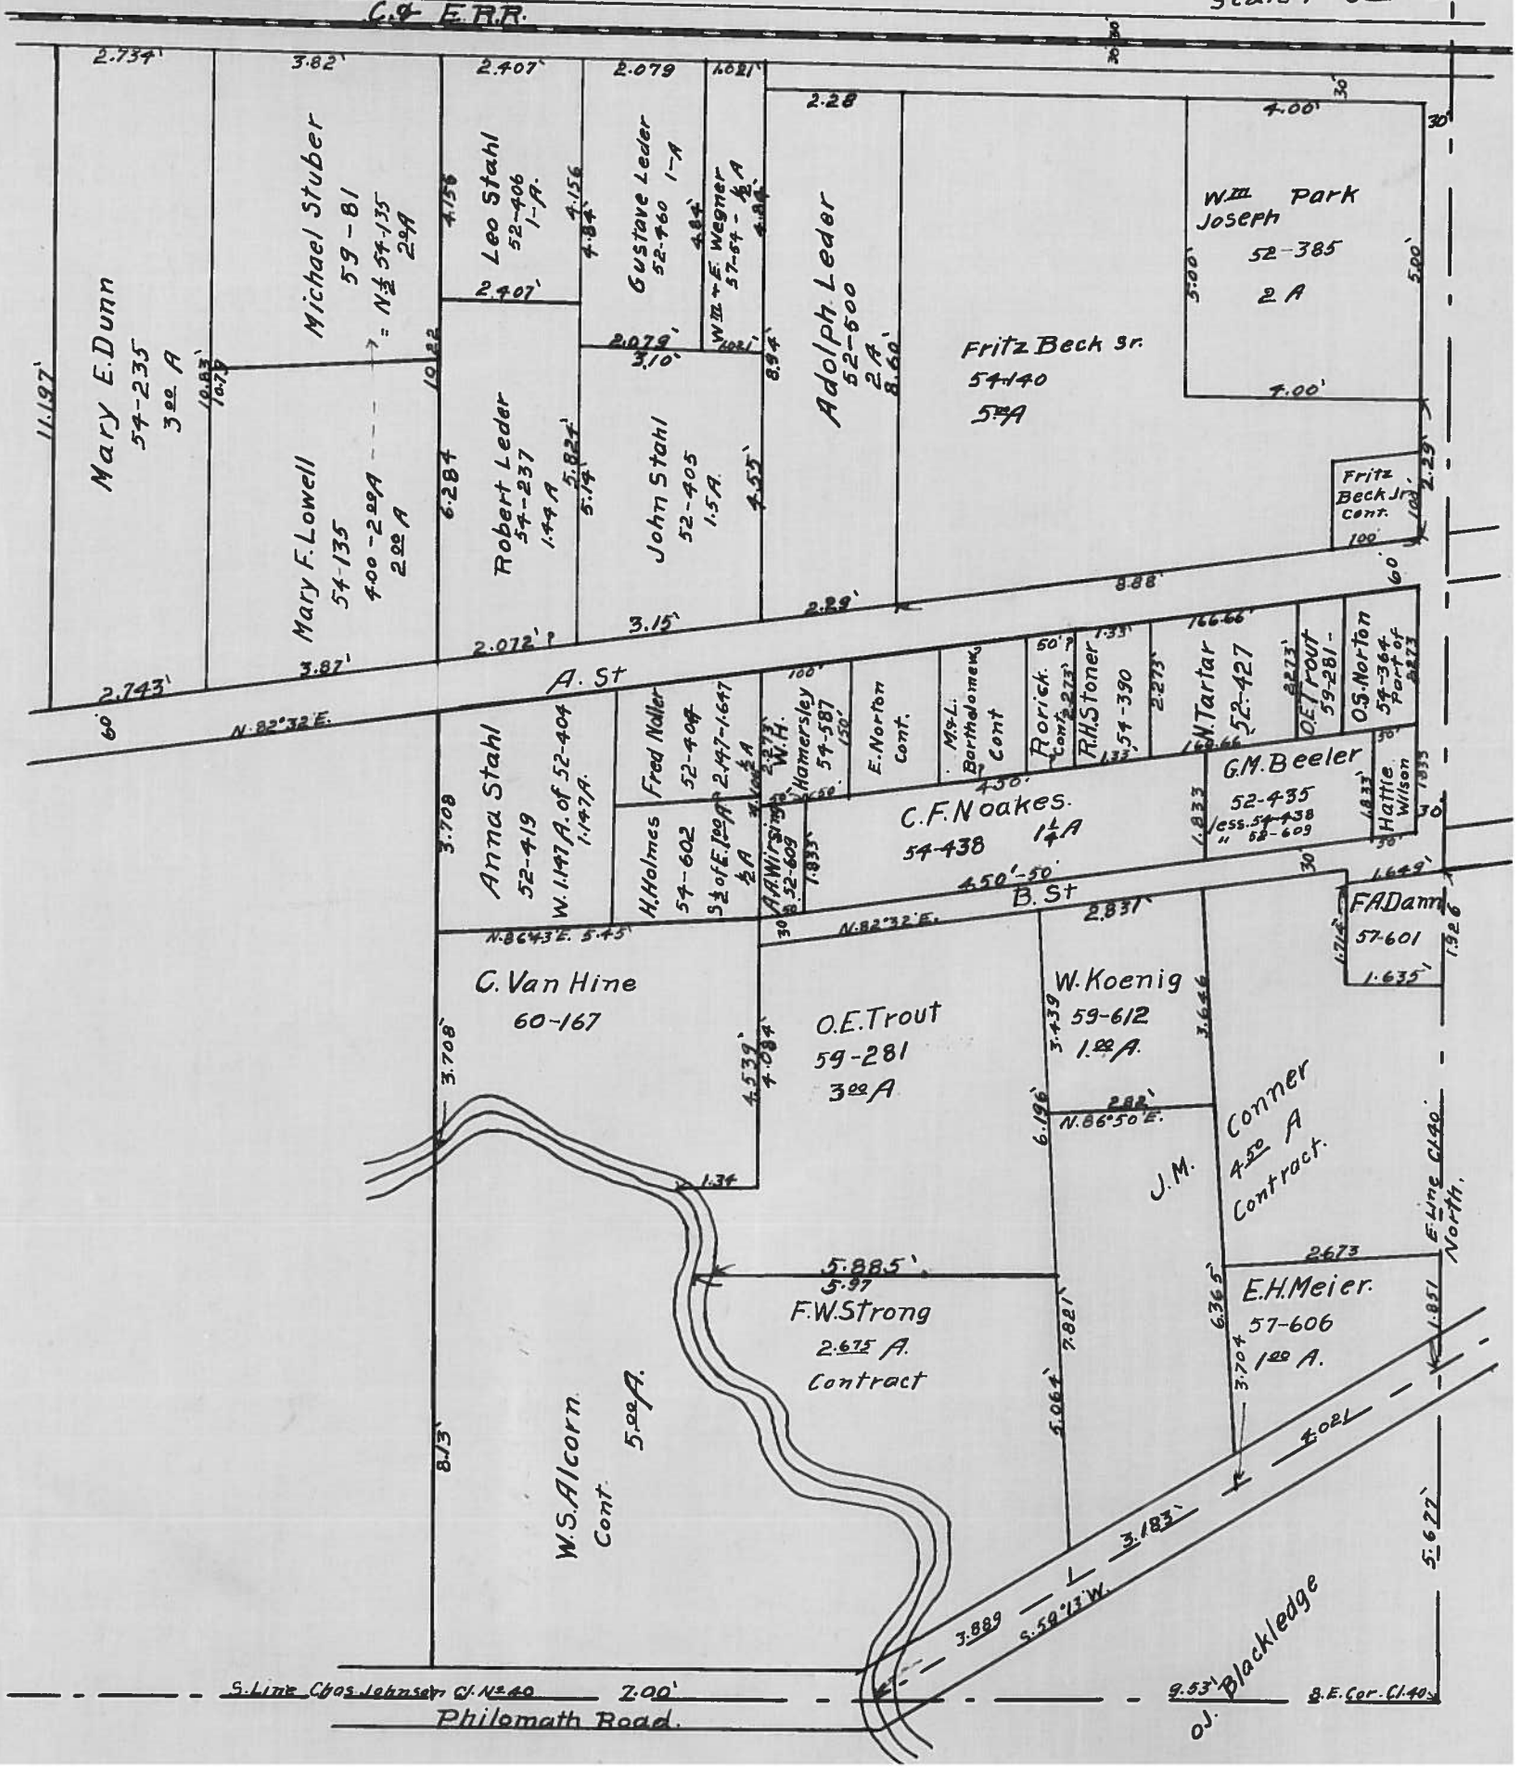

RICE TRACTS IN Chas. Johnson Cl. No. 40, T. 12 S., R. 5 W.

103

Scale 1" = 300 Chs

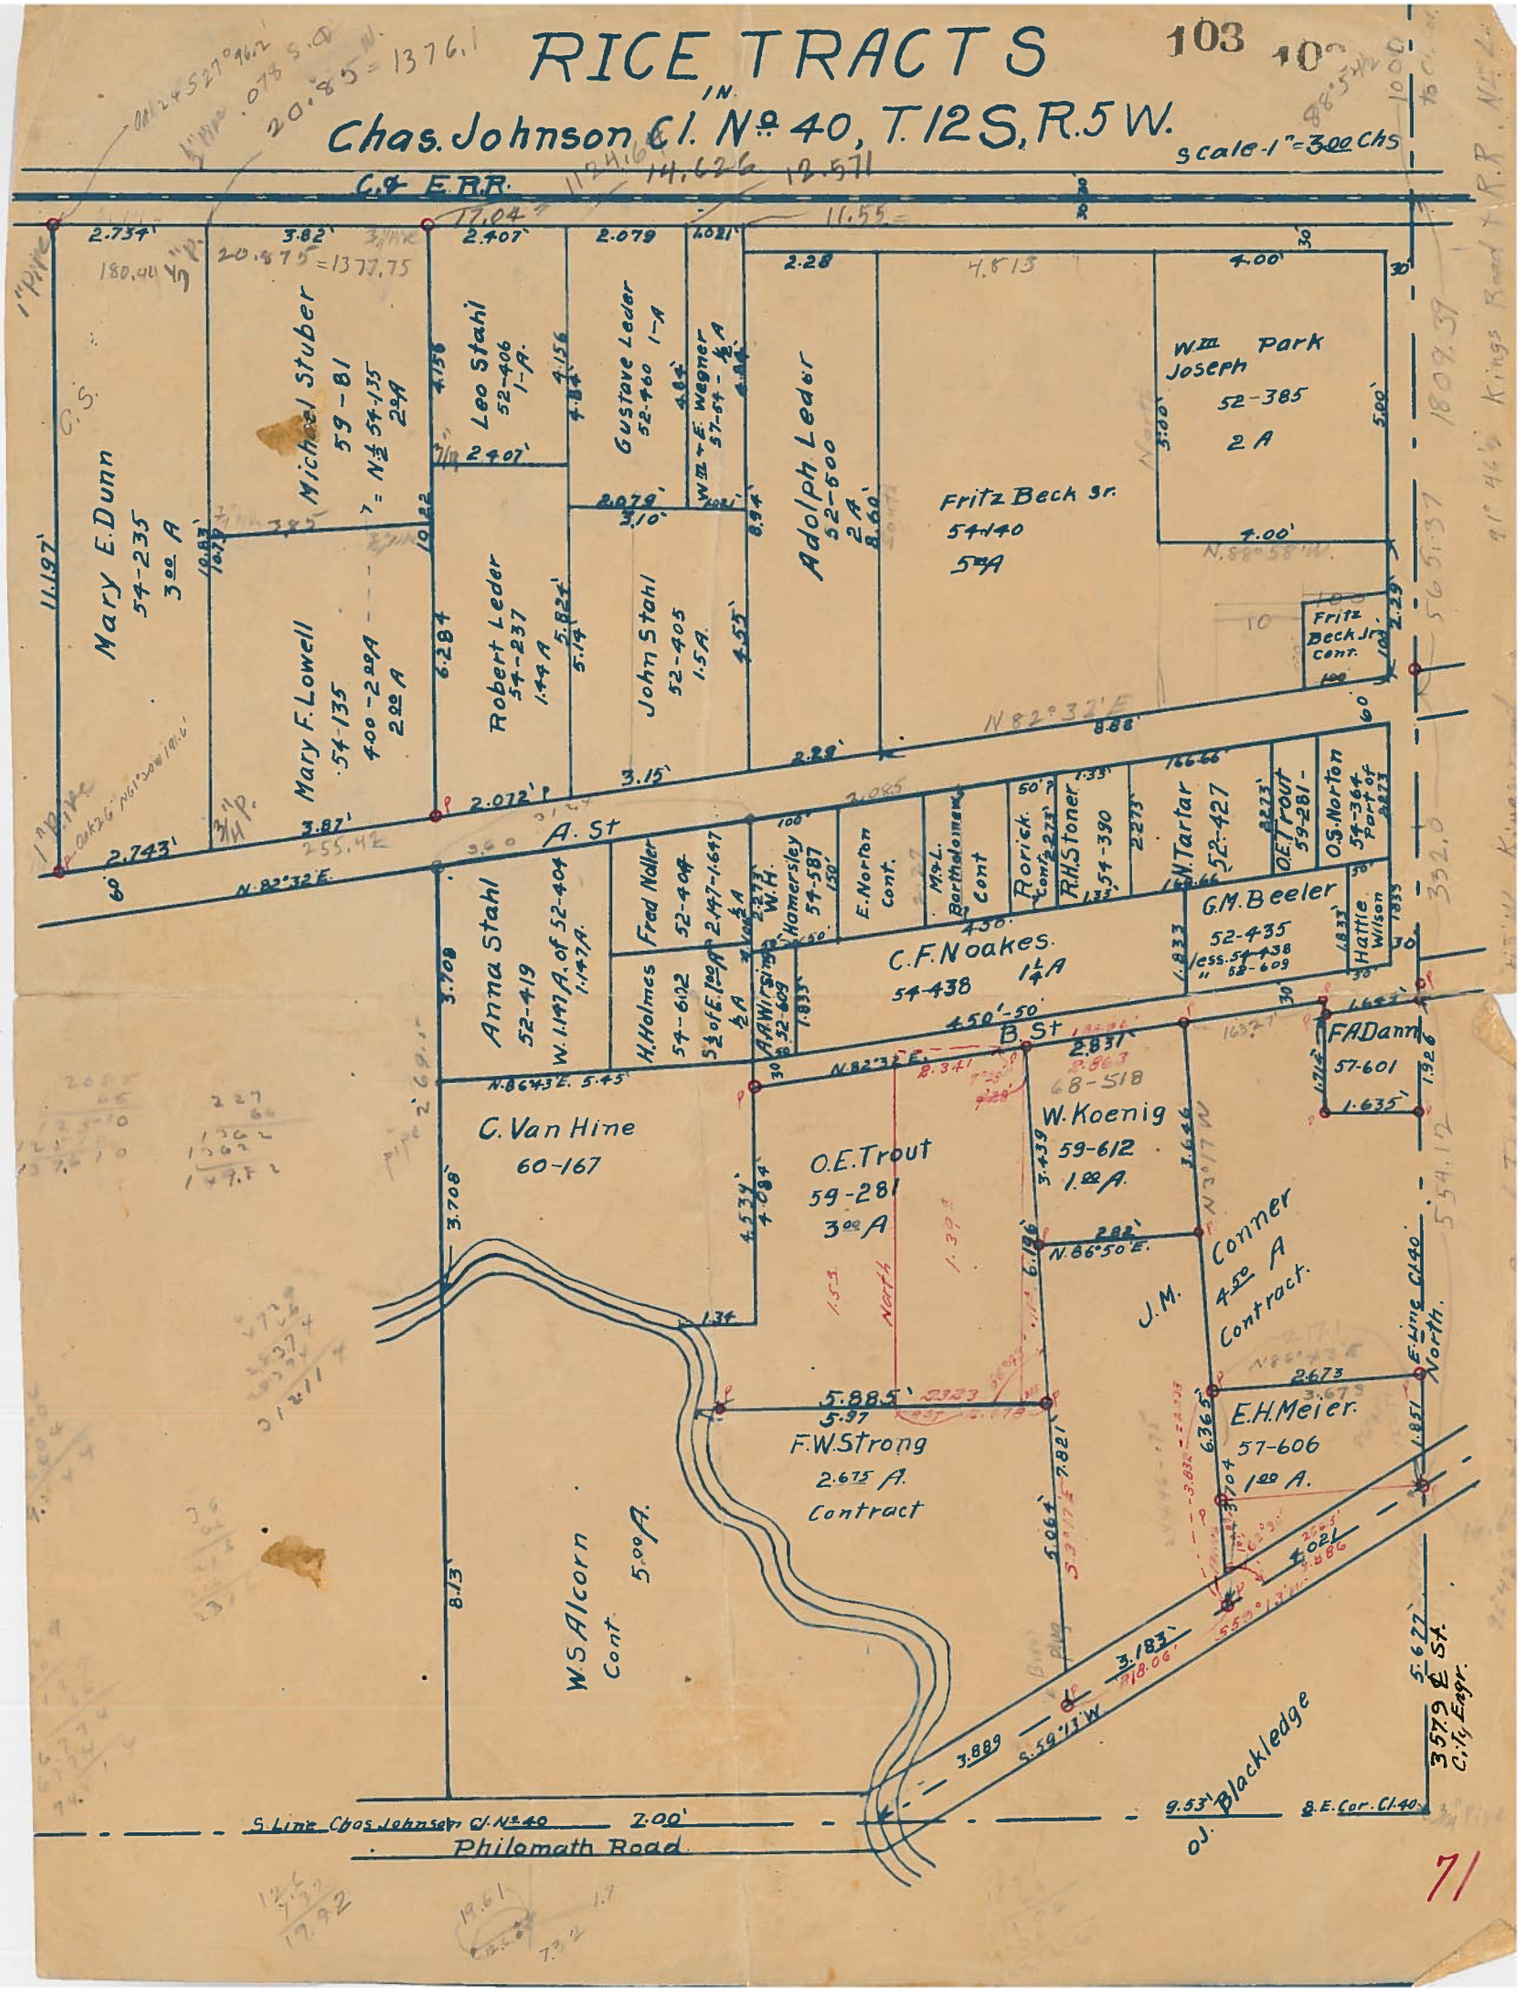

71