Plat of Survey No. 37. #110 Claim No. 47

Section 1 & 2 Township 12 Range 6

Scale: 5 Chains to the Inch.

Field Notes recorded at page ....., Vol. ....., Record of Surveys.

F. B. 3 — p 30.

MADE FOR C.C. Bell et all

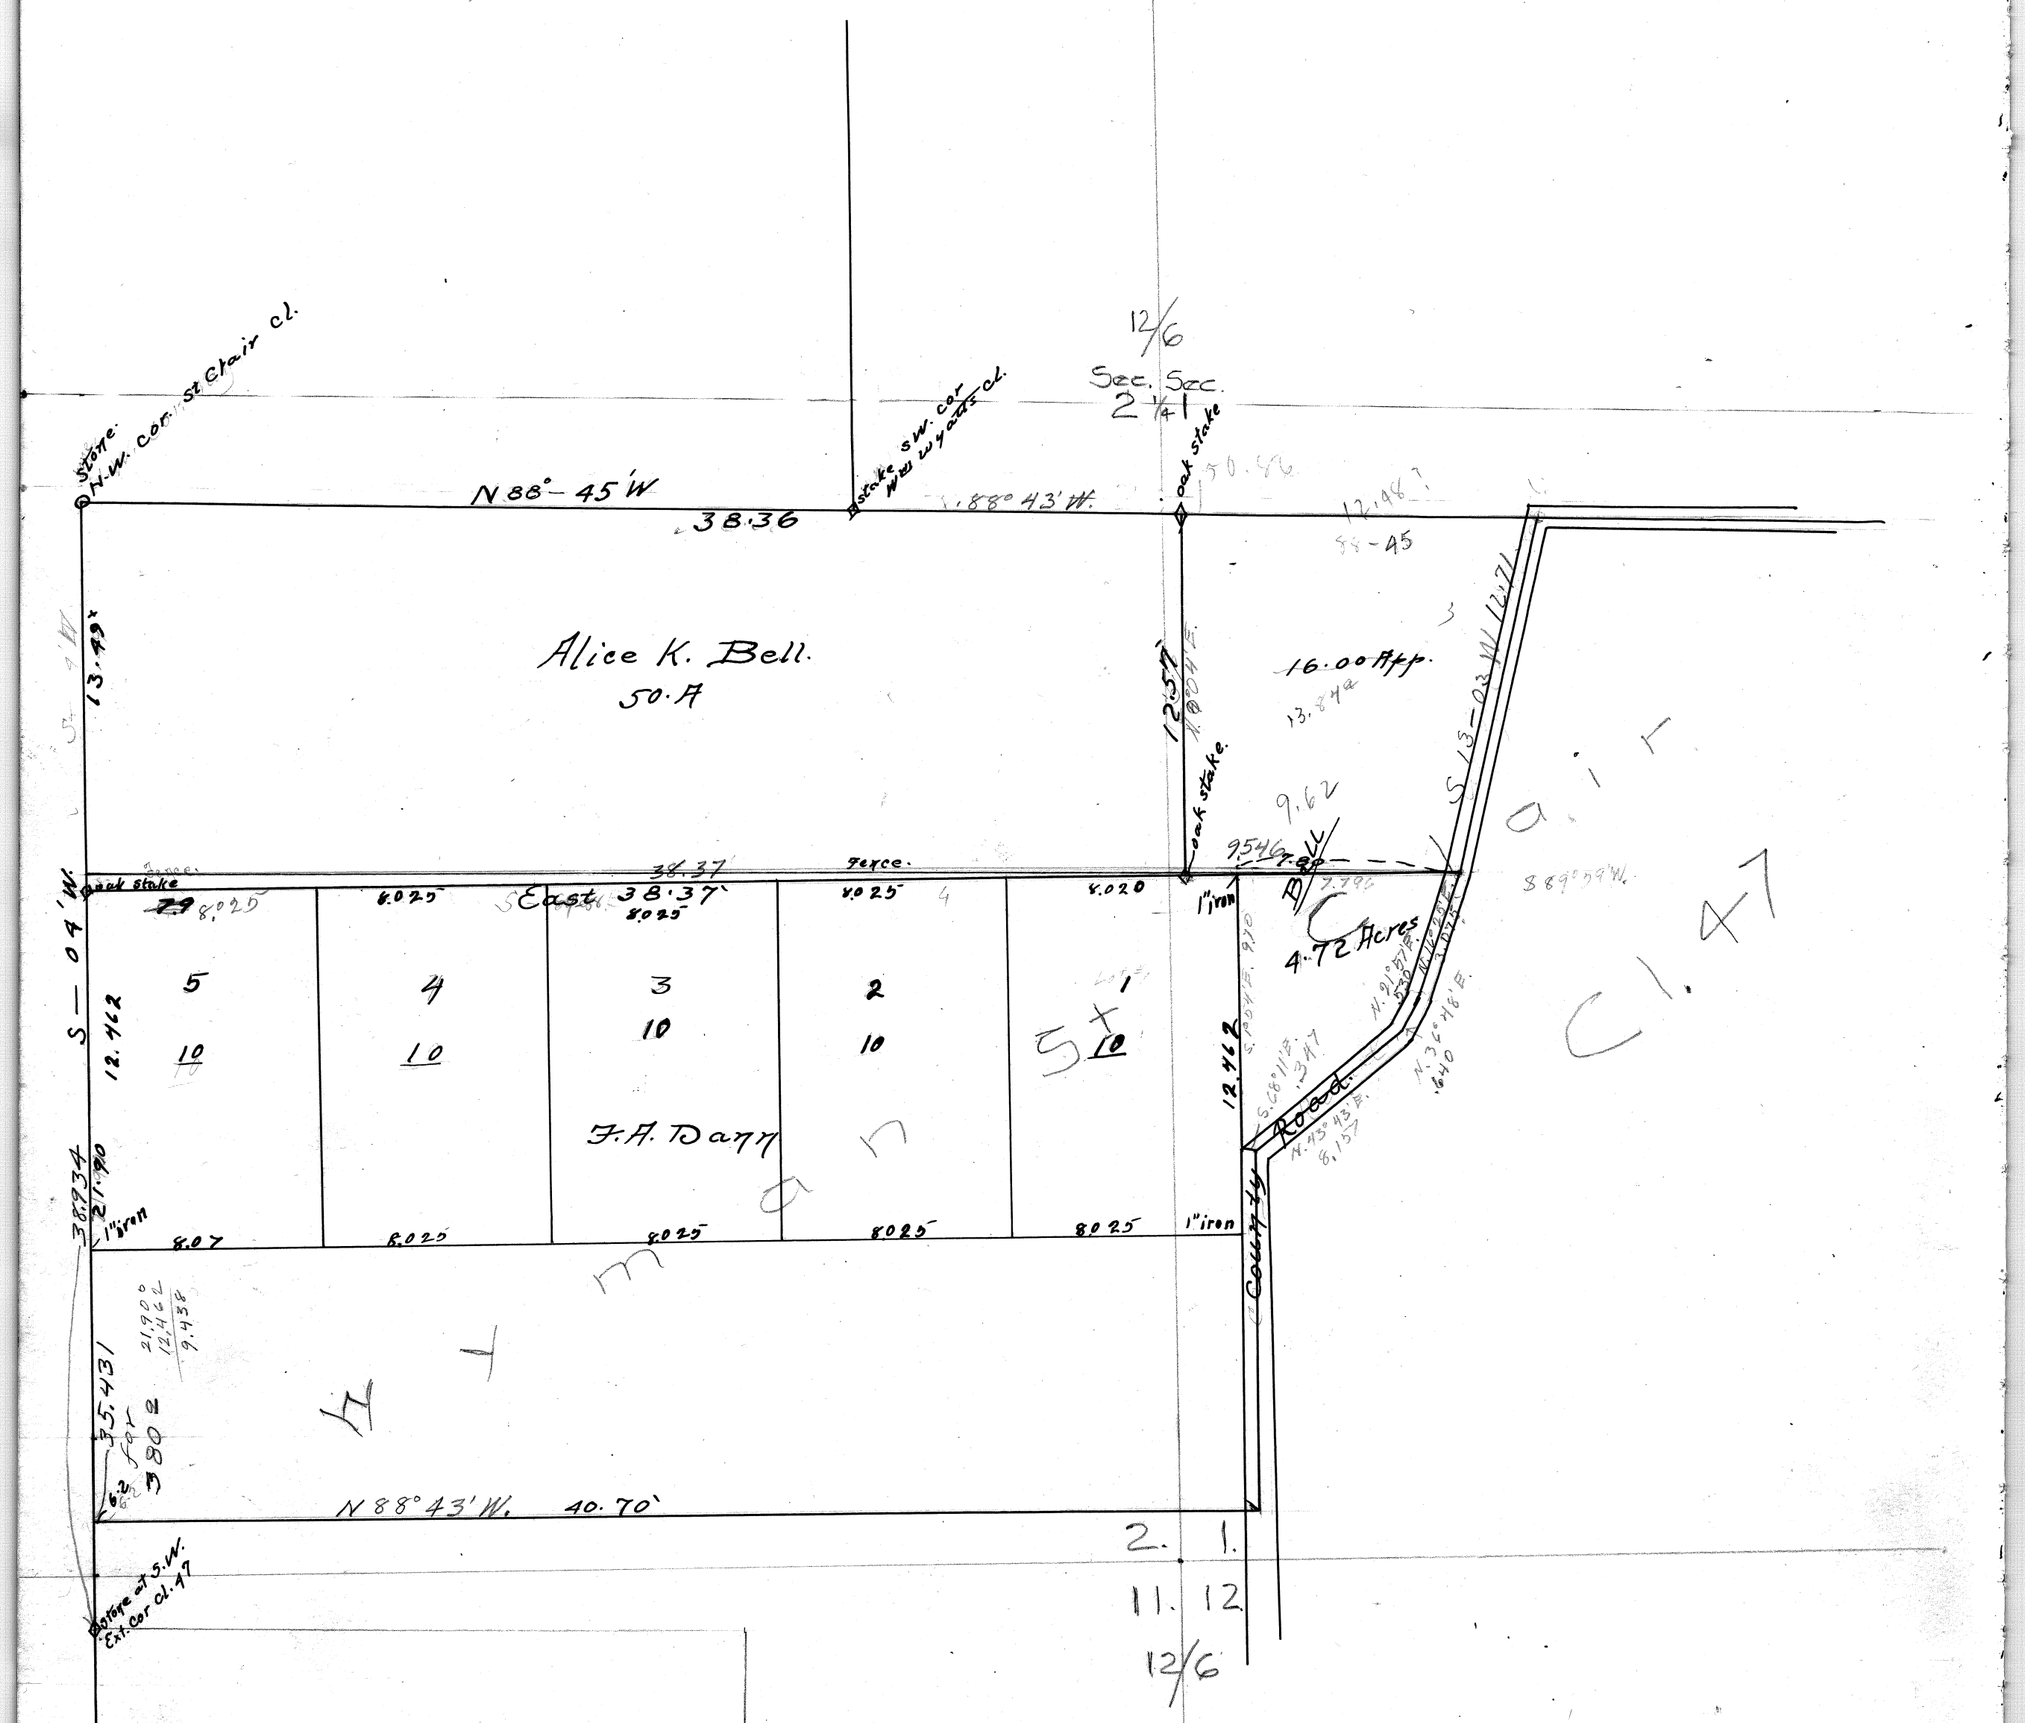

30 #110 Survey 37 1/2-6

Recast

Rectat. St. Claire Nine Mile Hy

Stone 10" x 8" x 1'

Oak 9" S 66-30 W 217.9

Stone South of fence +0.6

4.0

115.1

+ 6 —

+ 4-50 106.5

+ 3-50 (157.5)

+ 5-20

1-50

1-30 322.4

1.8

+2 2.8

Stone 4' (S 89°40½'E 1784.08)

8-10 209.6

2-30 426.6

+ 2-20 334.5

22.5 (1.6)

2-20 414.2

Dam's

Wyatt Cor.

Stone South

113.7

210

+ 80.1

0.6

115.1

477.4

106.4

157.1

856.6

699.5

447.6

396.8

317.6

386.5

2249.4

321.0

2570.4 = 38.945

2249.1

2329.5

3037.5

3037

200.00

4.00

140.00

450.00

141.80

207.47

426.19

334.22

1775.68

1.60

1784.08

27.031

13.49

8099

5571

5990.3

5587

5593.7

477.36

45[1].6

7599

48674

4063

425

449.64

209.6

9988

18867

1675

1

2074

320.99

8703

35200

780

2670

267

2073

474.1

335.1

09.

(.00129 = 44.2

20.2

1.1

24.

178-1.08

43 chains

24.8

22.5

2.3

4.2

3.5

3.1

3.6

3.7

3.9






A

38.29

3E

Drucks — 4' South — 6-50 — 346.0

— 11-35 — 26819

Caulked Mound




Set 3X3 oak Stake.

oak 11" S 61-30 W — 14.7

" 10" N 52° E — 46.4

Thence East — 2-20 — 329.1

— 5-10 — 400.9

1 — 2-10 — 465.6

— 4-10 — 300.0

— 3-20 — 480.0

+5-20 — 131.4

+ — 56.9

6-30 — 380.1

— 2.0

From Stanchfield Dist — 99.5

+3-15 — 475.0

6-50 — 337.5

Set 3X3X16

S 70° E 35.6

S 34° W 80.0

S.W. Cor

N.E. Cor

Twin

Bird

24346

1.9

2432.6

4.55

2.562

2.EN

890.3

28.1

862.2

13.06

38.28

2974

2292

2527.1

1306

500,000

39181

10820

948.

3720

2212

7080

10948

5320

38.28

6031

3825

1148

22

19.8

19.088

1259.79 =

1,60

53,80

480,00

4 13,86

3 43,54

2 66,99

1259.79

1904

1190

3.0

1.9

4.9

13

5.26

6399

31209

3920

114

165

180

Twin 6'

3164.2

5.7

31692

23,580

2494

20,800

55136

047400

2527.1

2432.

94.5

2434.5

1.9

2432.6

353.3

336.4

299.2

131.4

243.5

377.9

1631.69

4.9

3169.