C.S. # 120

F.B. 3-50

120

Survey 2 J.O. Walker
Jan 26/12/5 for Stake

50 Trees both sides 1/4 pine
oak 13" N 38-50 E 359.8'
oak 22" S 66-10 W 238.9 N8° 54' E
thence S 89° 27' W to N-E Cor by Survey

Δ 739.1
Δ Near River bank (3-20) 405.7
Δ Near Norris Fence 288.7 1432.8
Δ Stone Stake 2.12N 525.5
Δ 2.48N 339.9
Angle South R. 2.97N 441.2 = 1.03 and
Δ 4.15 3.42N 424.1 ½ = 2665.3
Δ 4.08N 613.9 Δ = 83.1
Δ on N Bank Wil. River 4.52N 411.1 +2.99 Nat
Δ Across " " → 406.6
0 — → + 2' 406.
4155
299.7
+ 2.9
6.8
Striking South. 5312.6
Tab. Cor on stk. 1 tree 5 Stone stakes
Tie 10" S 25-15 W 31.2'
Back to Δ Near fence thence North. 5366.8
— 7.9
Striking East Cor. 8.2
Thence South 294.1
Q. R 90 acres 5 188.3 + 4.0
Thence S 30 W 400

1.08 = Tan 04'

Dec 1 to Apr 27-09

Lat 14° 28' 28"
Dep 441.2
33200
8824
1323
132
1.0279

7.8
2.97
1.03
4.00
7.9
1158.9
6.80
1.03
5.77

4.08
1.03
5.11
4.52
1.03
5.5
5

5312.6
5.1700
531127
45,7300
1158.9
294.1
1453.0

Apr 27-09

41.17
3590
3542
3890
47.96
5.2
95.92
239804
1249.37
2.9
738.1
405.0
288.7
1432.8
525.5
339.9
441.2
424.1
613.9
411.1
406.0
4514.5
415.5
5010.0
299.7
5309.7
2.9
5312.6
2656.3

51

293.3 +E
1.0+

Δ ... < Left 14 → 261.9
" left 69-34 205.2
Cond = +71.6
+ Tank 11 192.3

Swing line East 1.97
Set stone N 1.54 + East .93
Set 3/4x16" Hub pipe at Stk.
Pine 30" S 61-05E 216.9
Ash 26" S 6-45E 62.7
Hard Ash 8" S 58-1 + set N 3.22 1" x 16" Hub
Maple 26" N 40-25E 52.3
Ash 11" S 31-40 W 22.5

N.E. SW. Cor. #1

Time 1½ days 1.35
7.50
Paid by 3.75 Wilson Record.

For Frank McGee Acct. #16 Cont.

#121

Swing line to Wall 2.15
+2.75 on 14th Instr.

From Alex on 55-30 Main. Pine R

	at		
	147.1	220.0	
	131.0	257.	213
	102.9	234	236
	116.9	207.	235
	100.	171	245
	77.	159.	198
	81.6		
	+37.		6
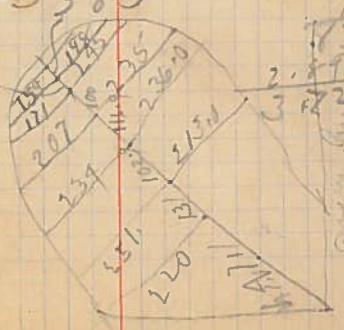
Pt A
Bend
in Creek