C.S. # 126

F.B. 3-61

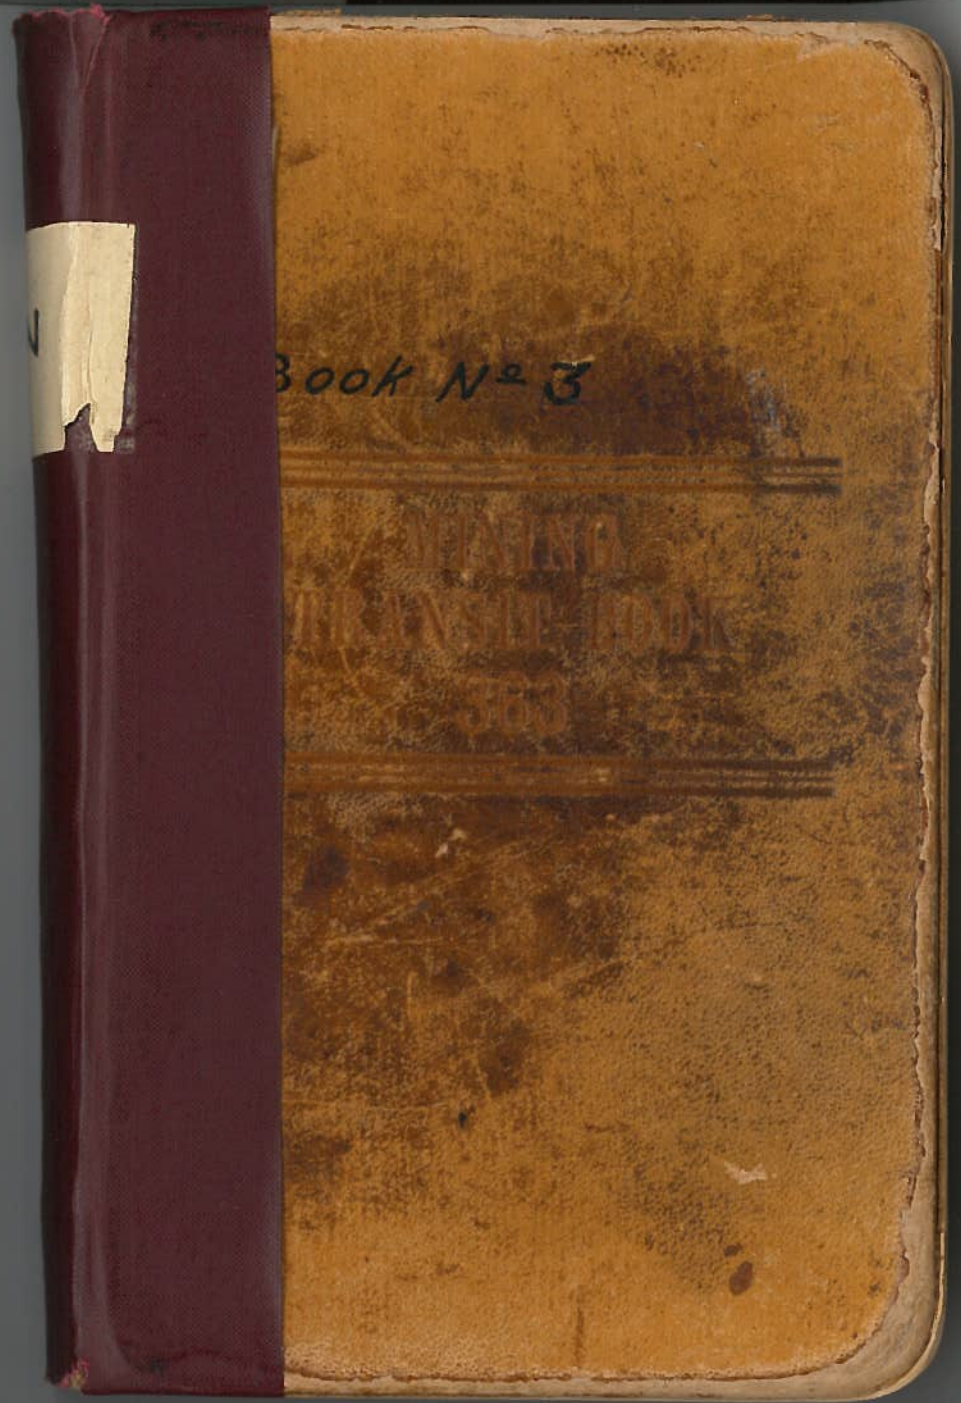
Book No 3

61

Tyrone Wilkerson NW

Tree · N 70° – 30' W 15.630 Harrison

Stump N 49° – 08' W 5.973

Set □ Hit at ⊿ +.928 – 5.005 down 16 chains

Oak 11" N 20 – 25 W 3.471

Cotton Wood S 16 – 20 E 3.403

Time 4 days

Stage 2.0 Rainfall

#12 *126 126

For Joe Bailey – Bill Carpenter

Rear at Spade Handle on

Run S 89 – 05 E on Iron. 4.567 ||

E 3.391 |

Oak L 94' 6.571

W Right 5 – 46 ||

Right – 32' – ⊿ 3.711 ||

+.118

Stake – North. .170

back to Spade Stone – South. 10.093

Set 1" black pipe

White Fir. 20" S 17 – 30 E .436

" 14" S 86° W .161

Set 1" pipe

White Fir. 14" S 88 – 15 E .907

" 14" N 6° – W .1616

⊿ S 88 – 30 E 28' 3.573

6.320

20.649
20.059
.590
Hall.

16.000
9.567
2.965
6.538
16.000
8.000
3.711
.118
57.899

16.000
4.567
8.000
2.965
6.538
16.000
3.711
.118
57.899

62

Set 1.52 + .027 S. of 1" Galv. pipe

Thence South 5.091

Back + Cont. S 89-30 E.

1.22

+ .873

N.C. Set 1/4 Galv pipe.
Willow S 8-45 E 1.917
Ash 18" S 87— W. 1.929

Thence S 89°-30 E
V.C. 3.448
Water Edge + 1.250
Access. dist. + =111.5 feet.

Set 1" Pk pipe.
Ash, 15" S 82-50 W 1.420
Time 1 day

Paid $6.50


82-11-5

Survey # Denied

127

For H. Mechlin

W. .261
Beg. N. 1/4 Corner S.E. +.470
Thence S 89°-W 2.003
thence North. 17.533
Set 3/4 x 30" Galv Pipe N. 89-10 E +.19 W of the line.
Thence North 9.93

10.093
9.220
.873

10.59
9.29
20.3

757
50.0
462
380
330
50

+ 1.220
46.89
111.5
453
376
590
528
620

3.1

10.673
5663
32019
6403
69633.72
5311.4
3911548
372
372
42408

23° 24' 26.4"
42.9
23-25-08.8
+ 40.0
23-25-48.8

Lat. 99-33-49

17.80
2.22
20.03

Time 18—09. Rec'd Recd.