C.S. # 134

Hardcopy City Plat 16B

also see notes in file

F. B. 4-3

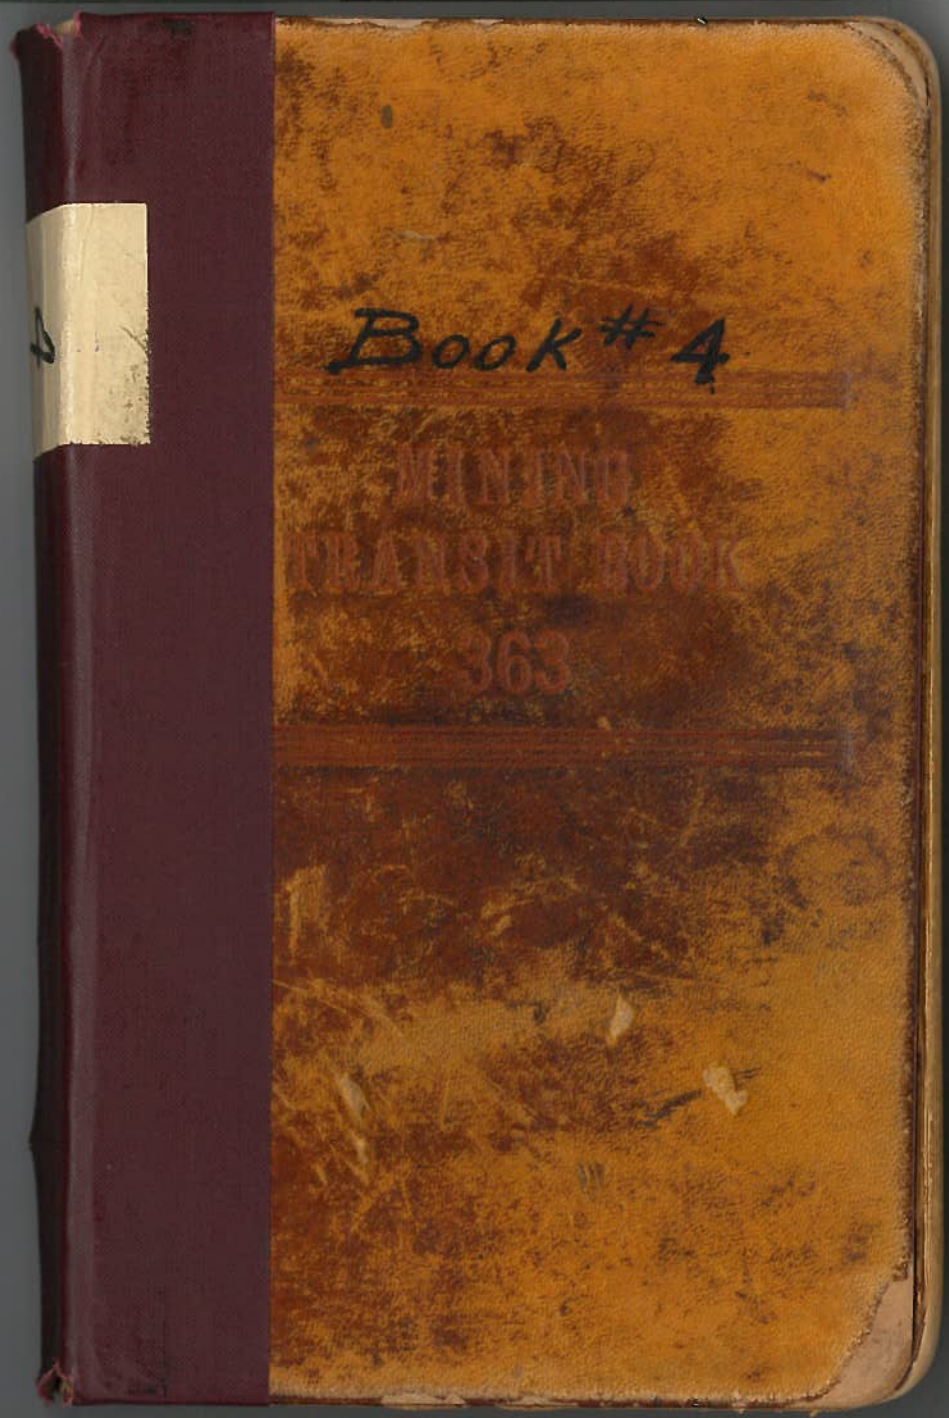
Book #4
363

S 30-11 E 3.095 Cr. L 1.03

N 67-33 E not within 2.910 Cr. L .35

Δ N 4 Cr. L .93 4.710 Cr. R. 1.12

N 5° E, 3.20 h course

Δ S 34-54 E. 2.595 L .50

S 85-24 E Bearings N.E. 1.707 L .70

separate Calcs. R.

N 78-18 E L 2.294 L 1.30

not within L .99 1.69 R. 1.92

Δ N 21° E .83 3.183 1.30

Δ N 35-05 E. 1.54 2.095 1.22

Δ N 64-32 E. 2.10 1.789 1.93

N 65° To Curb. 2.20

Back 1.25 1.00 1.25

Back to S.W. cor. .133

Set Sinker Stake

Conf FEB 14 Pg 11

#134 For D.R. P.T. Stake

Rig at Tobacco E. Jct W. .179

34/11/5 +.081

Thence N 51° 45' E 7.978

Δ Meaker Orch 6.194

Δ Middle Creek Jct 9.581

Δ Creek Left 12-11 5.356

Δ Near Buildings S.W. 10.729

S/ +.103

Stake, West .299

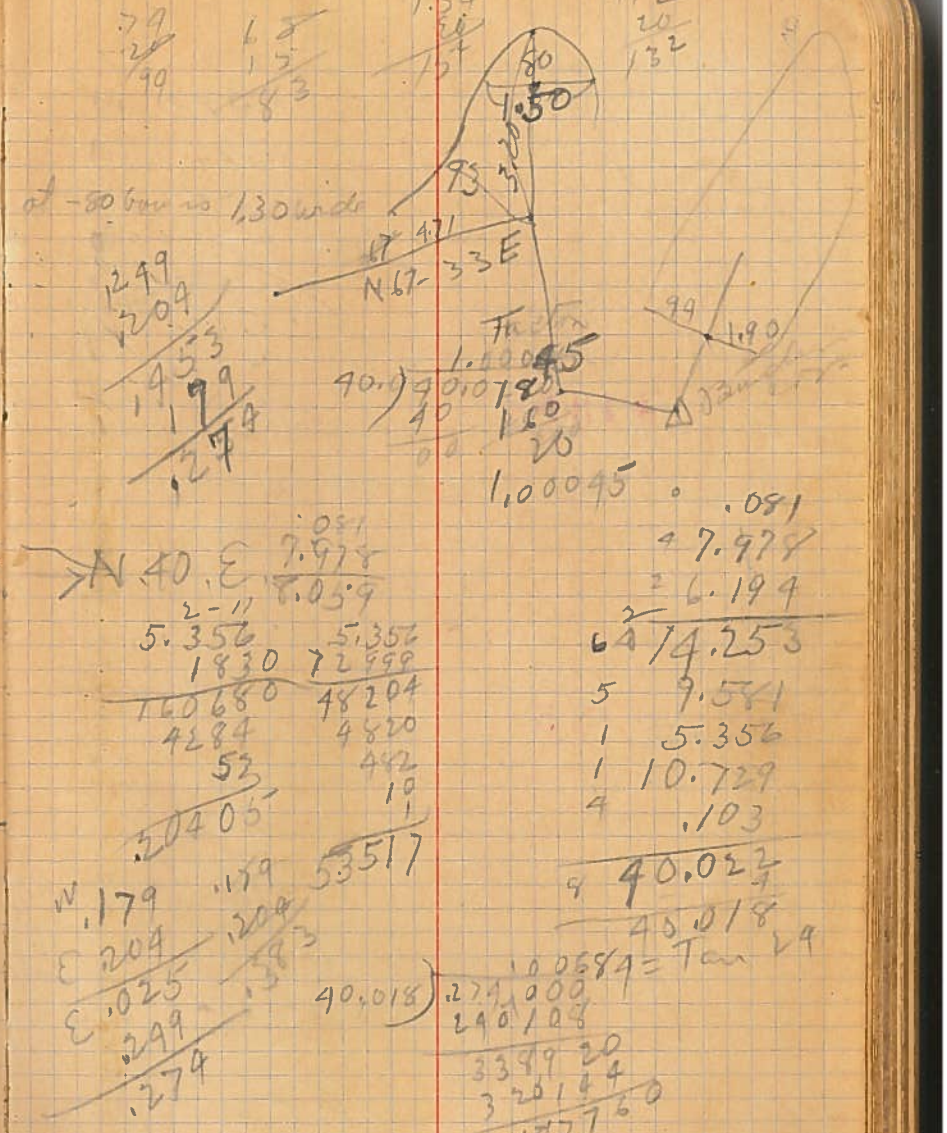

4

for Ex. stamp plan Cond. Δ² + 1.484 + 2.826

Time S 73-3/4 E 4.593

" N-53 W. Set 7.75 Set Stk.

Set S. W. Cor. 3/4" pipe.

Time 1-day

Paid plat. 5.00 25¢

#134

Survey #46 Original Survey

July 29 00

Beg at S Cor Lot Sec 31 + 32 T 1A-5.

Δ¹ Run East +1-30 3.793

Δ² Run North 3— 6.559

Δ³ West 4-10 4.063

Δ⁴ Run East 6— X

Δ⁵ " South 2-15 5.472

Δ⁶ " East 4-30 X

2-10 X

Δ⁷ Run West & North 2-10 X

#135

Run East +.43

" East +2.55

Run East +.505

" East 1.456

" East 1.002








Hill fence 1.67 to fence

+1.22 fence
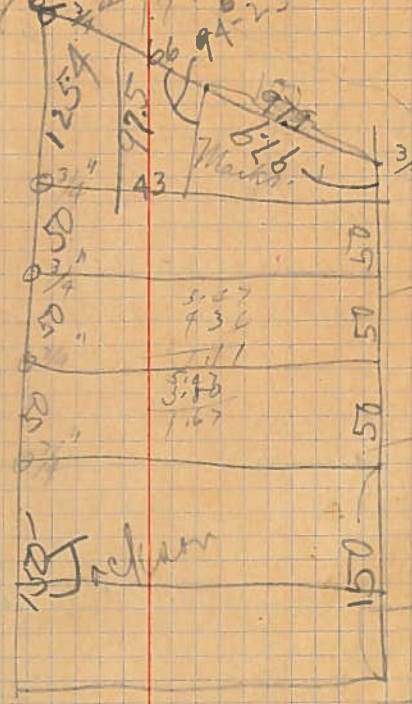
5.05