C.S. # 139

F.B. 7-10

10 Tommy Brinkley T. 10-5

Beg at	S.E. cor. Wrightsman Cl. 50		+.074	
	N 5°40' W	#139	9.423	for beg.
thence	N 5°40' W		23.993	
			+.033	ought to be +.074 +W.075
		Striking	W.089	
thence	East		8.000	
			5.963	
2		LR 10'	4.071	S.013
3		LR 1°45'	3.815	S.116
4			8.000	
		+ 3°-55'	8.000	
		+ 8°-20'	1.890	.3732
			-6.200	
5			3.592	
6		+ 18°-35'	1.225	
7		+ 8°-30'	1.102	
8		+ 3°-30'	+.148	
thence	South ~~Striking~~	+ 19°-30'	1.162	
9		+ 11°-50'	1.662	
10		+ 2°-30'	2.772	
11		- 5°-15'	2.962	
12		- 11°-05'	8.000	
		- 8°-20'	8.000	
		- 12°-10'	1.250	
thence	West	- 8°-30'	8.000	

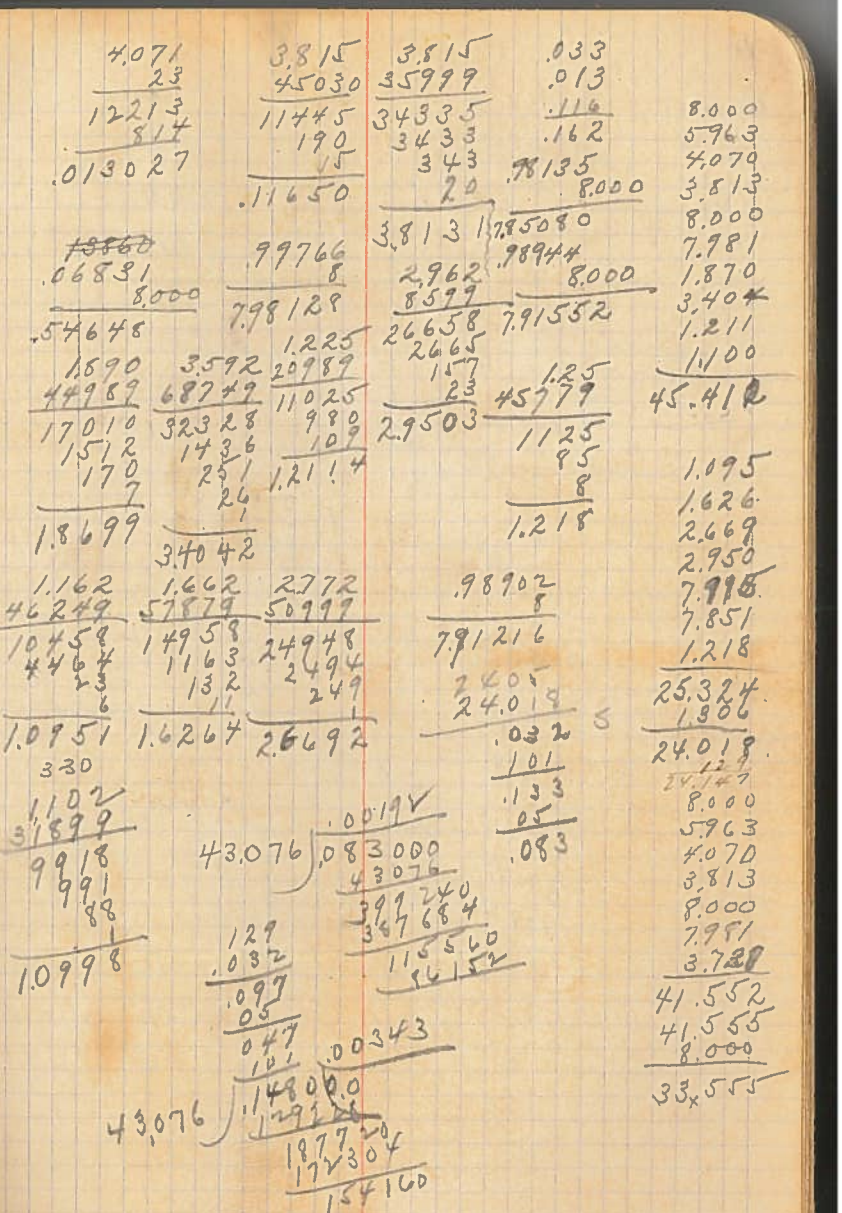

11 N89°25'W

thence West

		8.000	
		.298	
18	R27'	6.448	N.050
74		8.000	
		3.275	
	LL 38'	8.000	
		1.144	S.101
	LL 10'		
	LL 55'		
	LL 06'		

.162 N
.109 W

.08 N
.109 W

27

6.448 — 6.448
.567 — .29999
5136 — 58032
5158 — 5903
322 — 560
.050616 — 58
6.4477

9.144 — 9.144
.5011 — .49999
9144 — 82296
914 — 8229
45 — 822
.10103 — 82
3
9.1432

.162
.05
.212
.00
.112

26

26.866) .213000 (.00792
.162 — 188062
.101 — 249380
.263 — 27794
.05 — 7586O
.213

42.876) .213000 (.00496
171504
414960
385984
29076O

17
11
52

6.448
8.000
3.275
7.143
26.866
8.000
.298
7.912
42876
43.076