C.S. # 143

F.B. 4-17

Survey #148 12-6

17 Station 0+00 Stone 16x12

#143

Thence N 89-42 (N. 89° 37½ E.)

Correction N. 4½

#143

Angle Left 18°

New Curve Sec.

Angle Right 2°-21

" " "

Correct N 0°99

" = -04-30 = 0°99

" = .00125

Taking Walks.

Point on

2+07-10	2.236	
+6-	1.783	
+4-	1.947	
+3-	2.533	
+12-	1.925	5.005
+4-20	2.216	
+9-30	5.813	2.614
+2-30	4.310	
+6-50	5.377	
+6-10	6.775	38.187
+10-	4.557	+1.319
+7-30	6.649	N. .054
" " +7-40	5.602	N. .793
+7-40	1.841	
+5-	X	
+10-20	1.209	
+16-10	2.696	
-10-30	1.023	
-33-55	3.206	
11-	4.571	
+6-40	1.836	
-2-	4.017	
+15-30	.875	
-	.003	
	.394	
+ 1.303	N. .054	
	1.357	

18 Station

6-35	41.1	.925			
9-	34.9	42 5.00			
6-34	6.2	45 25			
		181			
6-26	55.2	36			
Left 44° 31-30		50474			
		1			
2-10	6-	4-	3-		
2.236	1.783	1.947	2.533		2.218
2299	5499	6799	68.99		1.773
20124	16047	17523	22797		1.9427
2012	1604	1752	2279		2.529
44	71	135	202		905
2	8	11	15		2.209
22184	1.7739	1.9421	25293		5.732
1.2	4-20	9-30	2.30		4.306
.926	2.216	5.813	4.310		.614
2879	1799	3689	1999		21
8325	19944	52317	38790		5.339
447	1994	4650	3879		6.736
73	159	348	3873		53.689
1	2	17	4		21.614
9046	22099	57322	43060		5.339
6-35	6-40	10-	7-30	7-40	6.736
5.377	6.775	4.557	6.649	5.602	4.488
7277	2447	9982	9147	1193	3
48393	60997	41013	57796	30418	8.177
4839	6099	3645	5779	5041	6.587
107	270	182	66	55	5.552
9	12	36	7	5	1.132
53357	67355	44876	65847	35520	1.184
10-20	10-20	16-10		10-30	2.559
1.209	1.209	2.696		1.023	1.000
1199	8389	64869		3397	2.981
14569	10881	2621		7207	4.489
1455	967	1617		818	1.423
18	36	10		39	4.015
1	1893	65892		10054	246
15274	6-40	2-	15-30		7.970
11-	1.836	4.017	.875	79.69	78.99
4.571	2399	4949	6367	75.96	63
61241	16529	36153	7902	3.73	5
41139	1652	3715	526		78.992
3656	55	361	54		1065
45	3	16			2) 78.981
44967	18254	4.0145			39.490
					78.98

Sta 1900 -

Thence N 62° 1-09 — 7-10 — 3.886 — offset .077

— — 1.603

+ 4-50 — 2.791 — offset .023 W 1.20 / .054 E

Angle L — 50' — + 4- — 1.616

— 12-20 — 4.607

Near Cor. Δ .057 W — — 13-10 — 3.079

Course .057 W — Tan — 5 W — = 100.43 — — 3- — 3.396

— — 2.746

— 3-40 — 3.131 — West .037 W. .017 E

Angle Left — 35° — + 5-30 — 3.736 — offset .002 E.

" " .02' — + 14-40 — 3.340

12-50 — 2.686

— 1.696

Angle Left 3-20 — 9-10 — 1.345 — offset .077 W.

" " 2-55 — 19-15 — 1.439 — offset .069 W.

+ .005

Striking W. — .070

Reestab Stone .18 x 10 x 8"

for 56" 55-30 E Slope .445

Ranged Trans. Stone Out +

Striking W 1.7

Place 1/4 1/4 Cor at 4.204 + W .098

Cent Section Set out Stk.

Hogan's Fd. West

Fd. Stump 24" N. 1.233

Spine Phill. Coll. 55-55 Oak 12 S 24 + 10 E .853

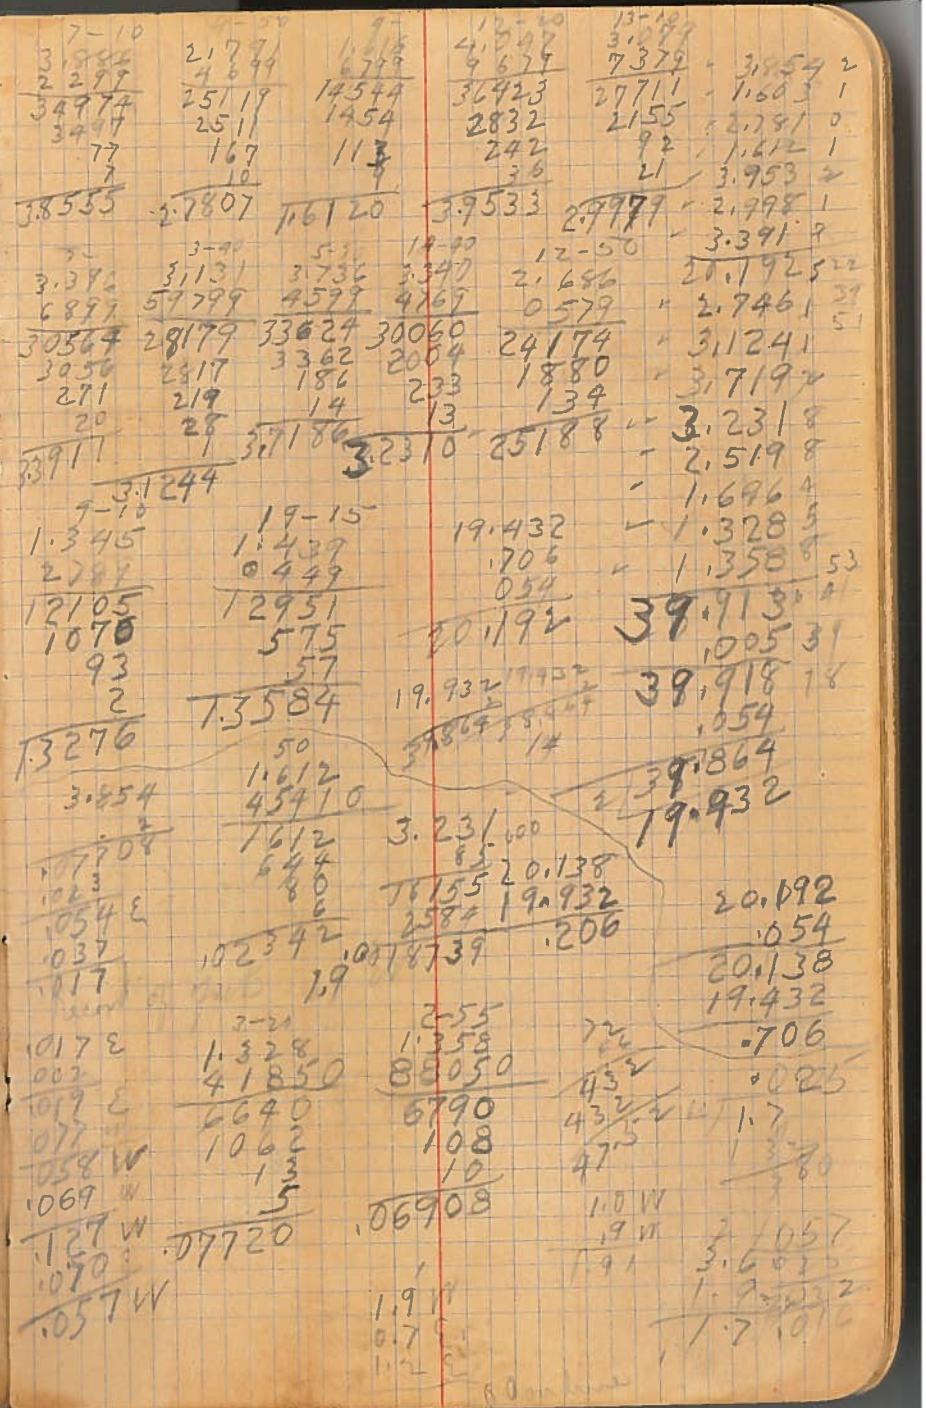

19

Back to 4"
thence N
" W
from Sta. -1.28 N 51 E
thence North — 0.0 N 5-50 3.195
correction W. 5'
Cl. line and
for sec. line + 15 — 1.283
6-30 1.439 = W.011
Cor. Left 26
5-10 8.000
Near ½ pt. Δ
+ 6-40 2.373 — .327 = W.008
Cor. R. 35 + 4-30 1.576 = E.005
+ 5-50 4.463
— .192
.031
Set oak stk. Reset with w. cor. Set
Centered N-1 oak
+ 12-20 6.496
11-50 4.940
9 — 1.816
72
to Sec. Cor
Reset. Oak stk.
Oak 15" N 22° W. .132
Set Cor at Δ — 32.7 + W. 1.008 Oak stub
Oak 11" N 32-15 E .640
Fir 14" N 43-45 W .660
Turn N 89-44 W + 39.505
+ 6-30 6.640
4.231

5-50 15— 1.0 2.218
3.195 1.283 2.060
8497 9569 .158
28755 10547 19.576 3.1781
2875 769 327 3.406 4
127 64 19.251 1.239 —
24 11 5-30 1.430 8
3.1781 1.2391 4.4213 7.968 3
6-30 8497 2.357 5
1.939 2.373 1.576 40167 1.571 6
6397 — 399 9499 4016 3
12931 21357 14184 178 4.470
1295 2135 1418 35 25.589 3
43 71 94 4.396 .192
8 4 13 25.397
14297 23567 15709
12-20 11-50 9— 19
4.463 4.940 1.816 2.218 25.00 12.618 6.346 1
9671 7879 7787 4.25.00 5.7709 4.839 4
38469 44460 16344 1530 123282 1.793 2
4547 3458 1452 41 12328 .720
389 435 126 8 1232
58 34 12 9 123 13.698 11
63458 48387 17934 .615 6 25.589 26
13.6971 39.287
3.308 25.589 of rods 736
4.0 (4) 6.011 for cl. line 40.023
4.440 19.578 .011 W. 2.060 W. — .016
1.571 .016 .005 E. .011 W. 40.007
6.011 736 .006 W. 2.071 W. .007
20.330 .031 W. .005 E.
20.003 .037 W. 2.066 W.
.327 .000146 = 5'
25.397 .037000
6.640 25397
6399 116030
39750 101588
5976 1444.20
99
39
65974
39.505
37.488
2.017

20

Cyp Right - 26'

Striking South

Time 3½ das 11.50

Paid 11.50

Survey of 49 Klondike Town

Beg at Blake Cor Sandline.

Bearing & Blake N Lin S 70-45 W

North Sum)

#144

Place Cor at - 121 + E 129

Striking West

Back to Blake N E

Water S. by Sum