Plat of Survey No. 55 #158 Claim No. .....

Section ..... Township 14 S Range 8 W.

Scale: ..... Chains to the Inch.

Field Notes recorded at page ..... , Vol. ..... , Record of Surveys.

Field Book 4 - p 53 - 55
" " 12 - " 13

MADE FOR Mary Wilkes. Eyre. Hammerly
Hilby. Hammerly & Geo Fleck.
and Henry Robinson.

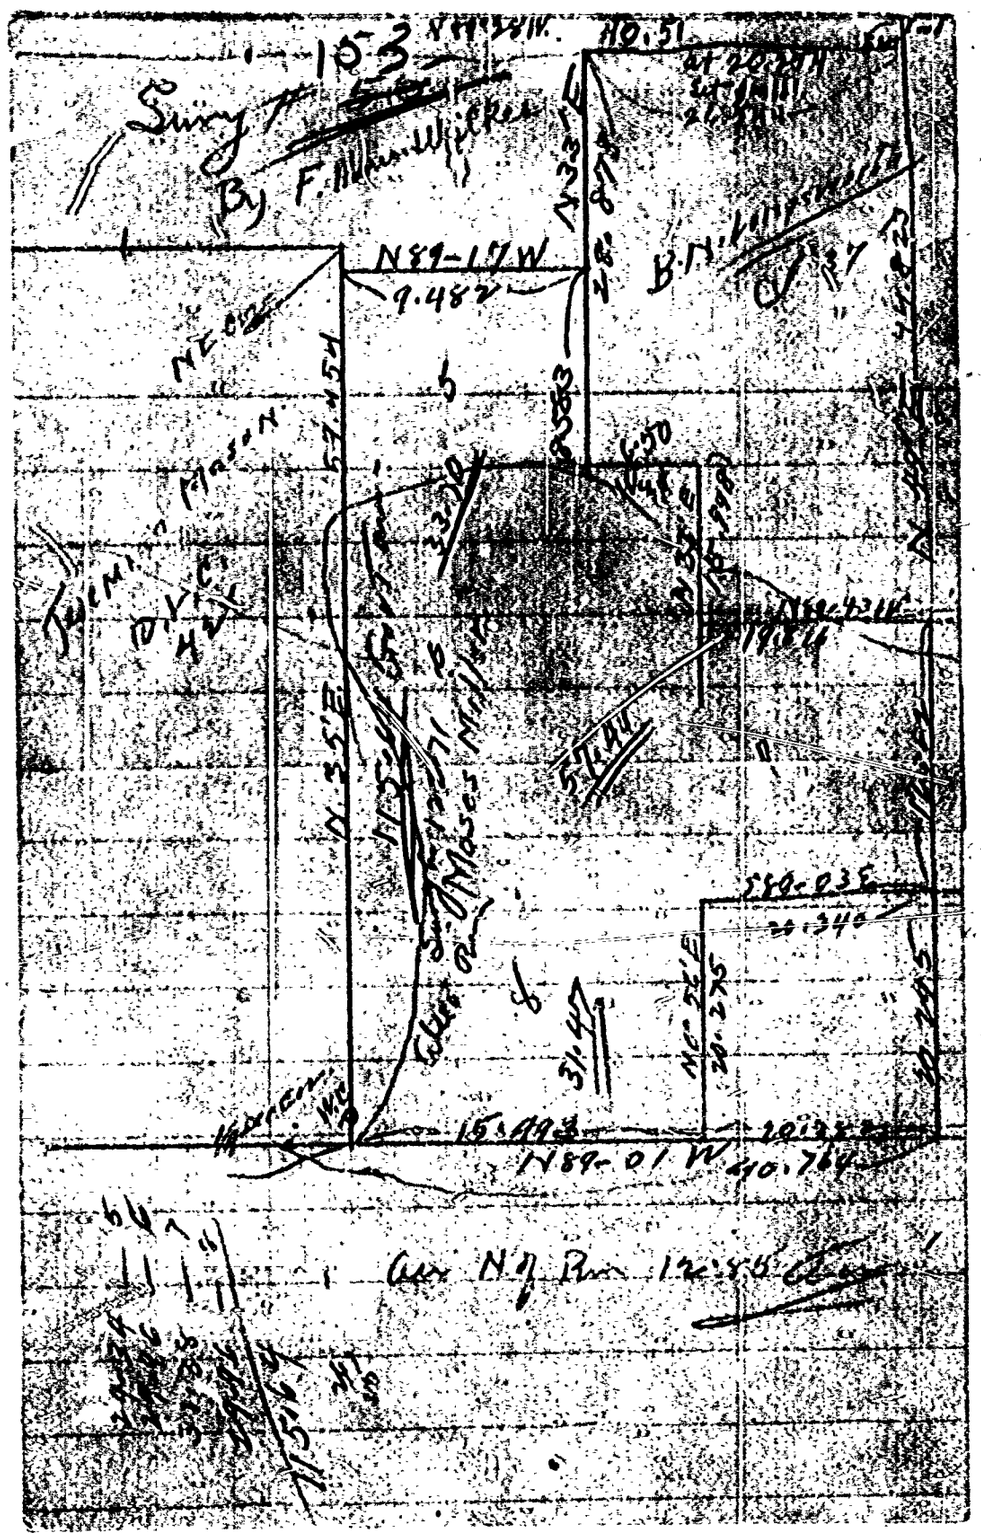

53

correction S, 12' = (S. 89° 24' E 40.003)

12/7 North of cor. .142

continued on page C F B

Paid $8.00

55

#153

Nov. 15 '09

54

1.157

+ 25-42 .830

+ 23-55 1.609

+ 10-40 1.026

+ 12-40 1.900

— 2 — 5.281

+ 23-42 4.970

17-20 1.360

N 80° — 02 E 20 — 1.170

Reestab. 4/3/10 at two bolts in rock

oak N N 34-45 E .772

yir 26" S 43-15 E .862

fir 24" S 60 — W .921

Back to Sta. turn E 0°10'

12.637

— .018

.056

S.E. of Cl. 51

Reestab Corner

apple 20" S 2-50 W 1.748

[illegible] 11 N 85-45 W .699

S.W. of Longworth

8.208

10.741

Reestab Corner

fir 38" N 6° W .661

Felch 8×8×

Felch 10×10×6

.392

31.960

55

Inverness South

Factor — .01376

Angle Left 44° 22' — 1548

Thence N 18° East

Stake Set

Thence S

Thence N 85° E





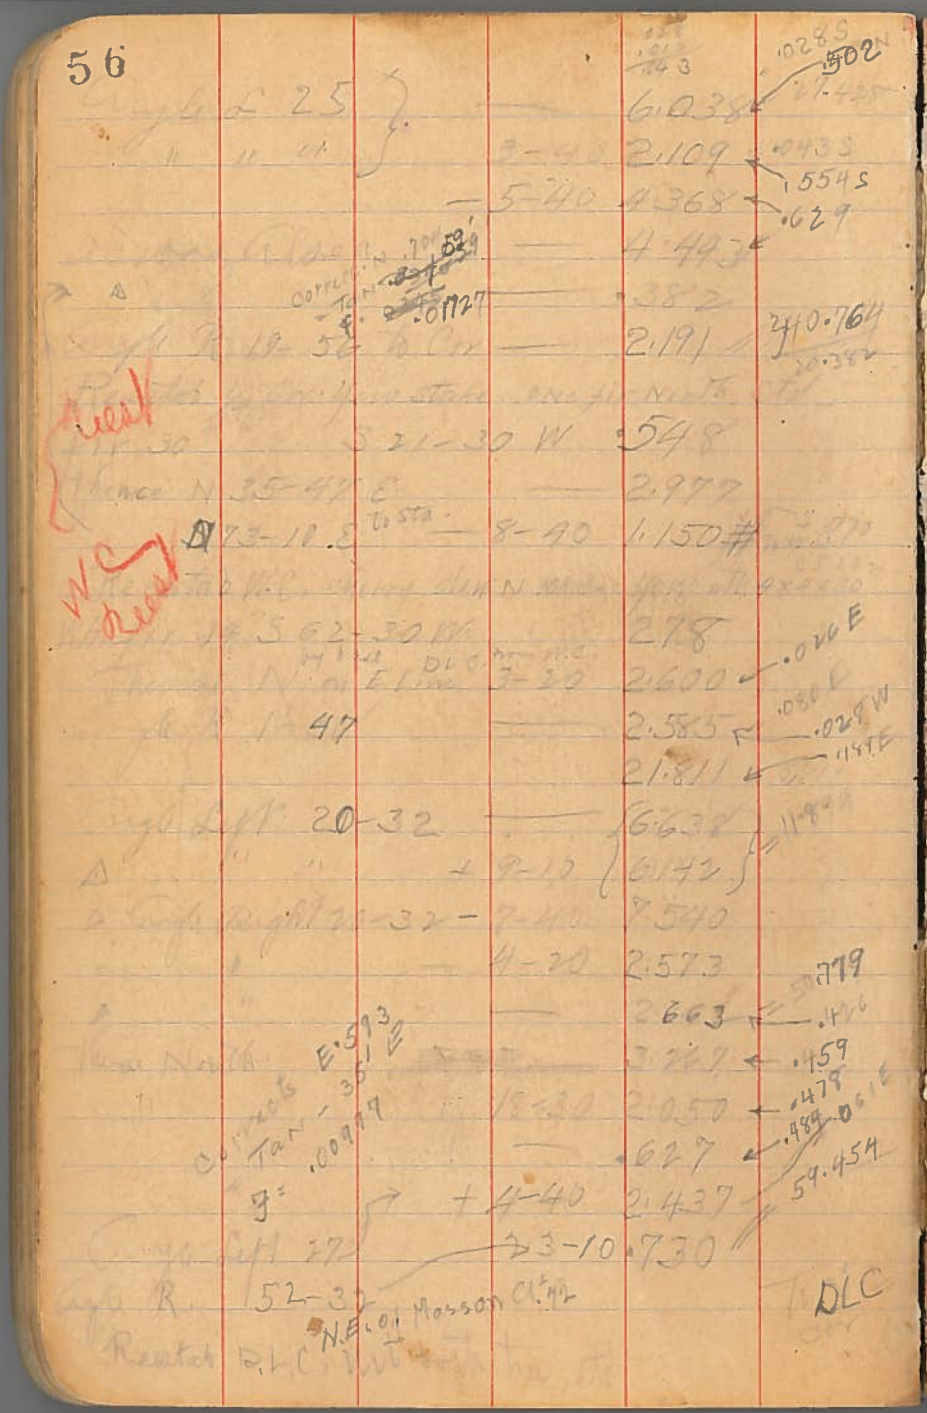

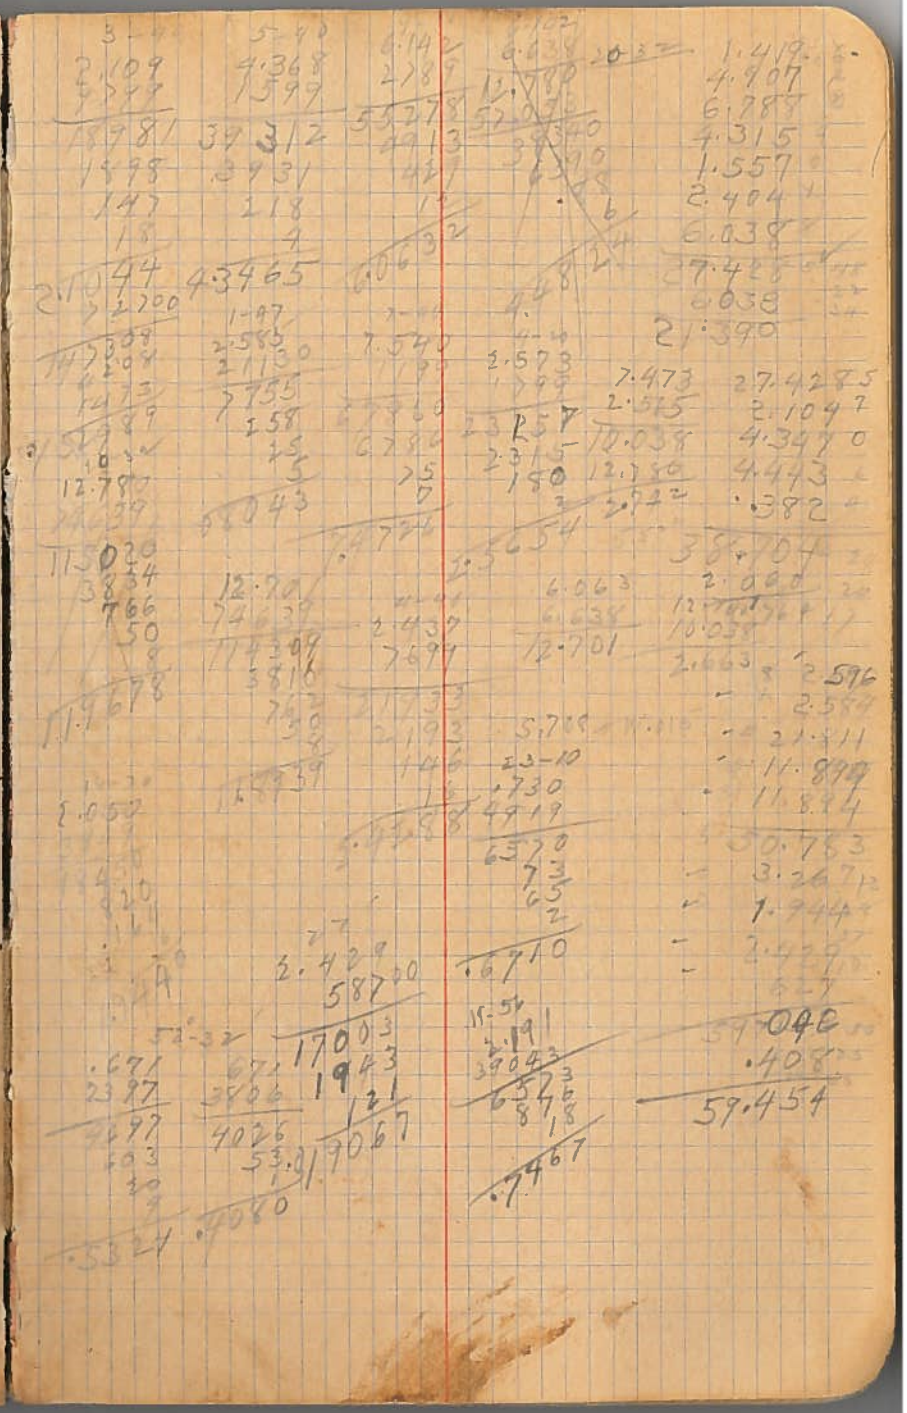

57

Set NE cor Lot 5 at Sta 112 — 2.20 — E 0.64

Set cutting stk.

Fir 15" N 44-05 E .258

Fir 12" S 19-30 E .490

N 89-17 W 14-10 2.068

1.501

— 14-30 1.158

— 20-20 4.086

+ 28-47 .426 9.482

+ 30-30 .427

Set cor. adj Lot 3 Thence —

to Lot 5 cor N — 6-10 .910

Fir 10" S 21-15 W .49

Sta 50.779 Thence S 35 W ∠R 1-59 3.646

Elev .552

+ 2.50

to Sta 51.3 — 100.8 — N .33 E

Oak 10" S 77 — E .290

W. Fir 13" N 22-30 W .224

Thence N 45° E + 4-40 X

+ 4-40 5.403

+ 11-40 2.162

+ 6-30 1.451

2.379

Set 4" Iron Pipe

Thence N 45° W 50 stk.

Oak 8" S 56-15 E .288 Edge

Fir 5" N 73 W .403

1.5 SW

SECTION




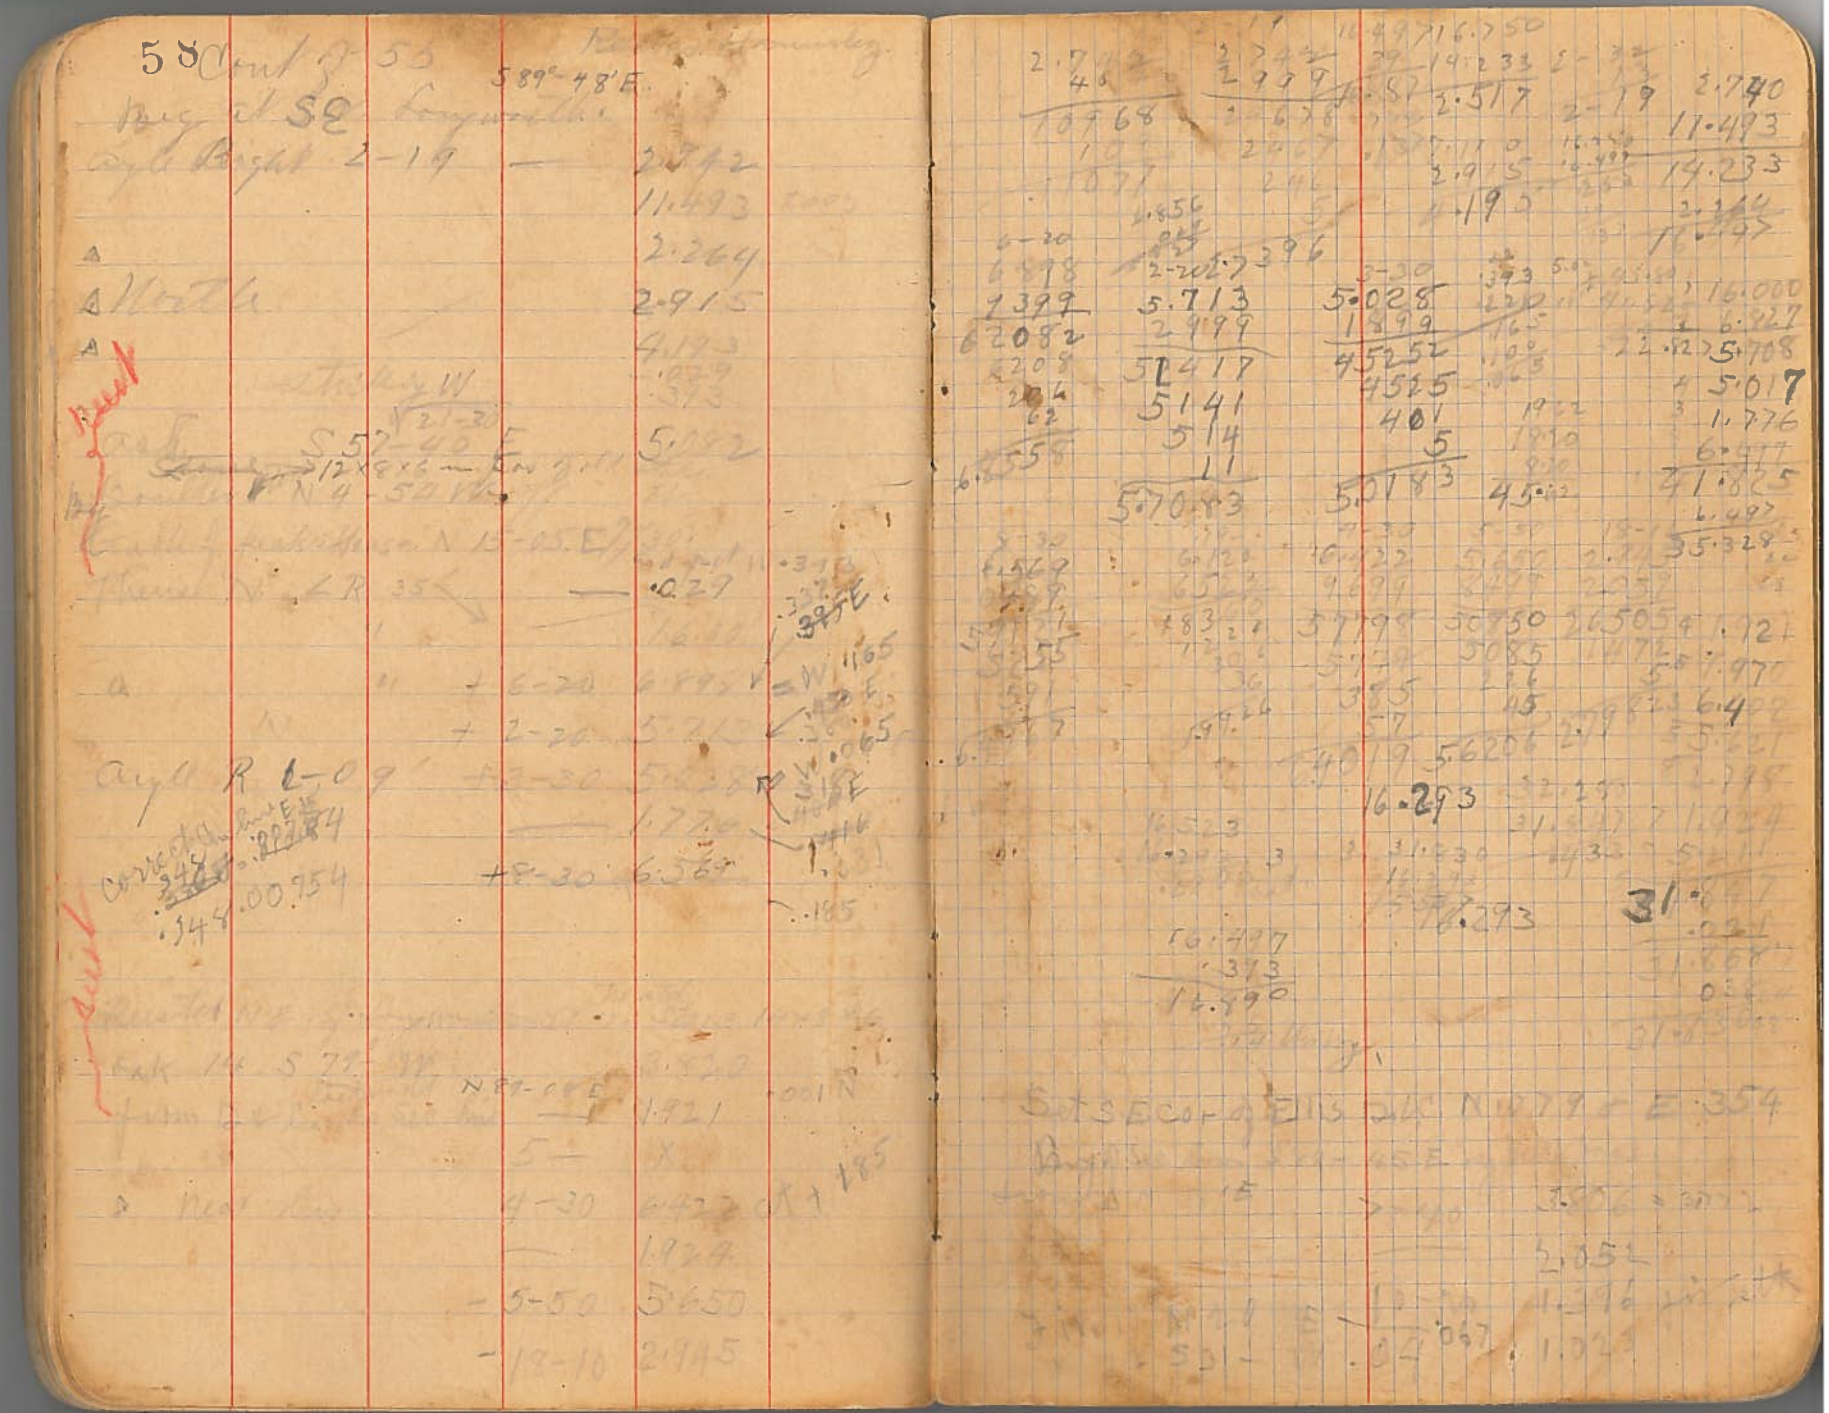

54

Robinson

4/3 N 0° 45' E.
9/10 correction W. 15½'
(N. 0° 29½' E. 40.388)

Stone 12"x8x7
Fire 13" N. 10-15
" 16" S. 65

E. .178
E. .117