C.S. # 154

Hardcopy 11-7 # 3

also see notes in file

F. B. 4-60

60

#154 11/7

Resist

Survey + 56-
Fenestal 45 set 1¼" Pipe
S.0°07'E.
Correction W. 7=
(South 80.474)

Angle Left	51	— 7 —	4.969
"	"	— 9-10	1.394
"	"	— 3-30	7.841
"	"	+ 4-10	2.015
"	"	+ ——	7.673
"	"	+ 6-30	3.000
		——	7.573
Angle Left	Setting Stone	+ 4-50	2.118
"	"	+ 16-40	1.822
		——	.690
Angle Left	24'	— 6-30	3.688
"	"	— 5-30	3.132
		——	3.066
Angle R	20'	— ——	7.300
		——	1.947
Angle R	1° 29'	——	2.160
"	38'	+ 2-40	4.215
		+ 2-50	3.020
Angle Left	29'	+ 7 —	5.977
"	"	+ 6 —	3.254
		—	.100
			.360
Back	Stone	East	
N 88° 21' W		+ 4-10	7.804
Correction S. 2°09'			
(S. 89°15' W. 40.276)		+11-30	7.026

E. 2.49
37.381
40.045
W. 1.63
7'
.00204
West 5.394
+W.011

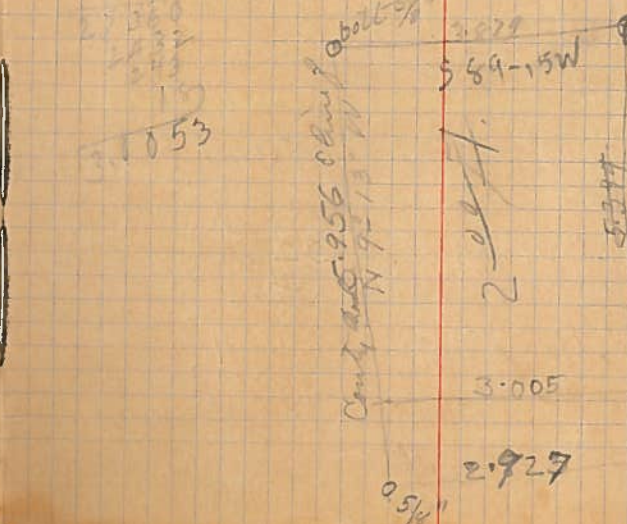

61

Road Survey #282

Beg at 5"x5"x30" Cedar Stk.

Tan 13" N39-30 E 1.164

Tan 12" N14-50 W .870

Curve ℄ 13' E

N 8 10' E