Plat of Survey No. 65 #168 Claim No. 77

Section 13, 14, 23 + 24 Township 12 S. Range 5 W.

Scale: 10 Chains to the Inch.

Field Notes recorded at page ..... , Vol. ..... , Record of Surveys.

Field book 5 Page 25. See special plat Island Acres

MADE FOR Dick Kiger Road survey

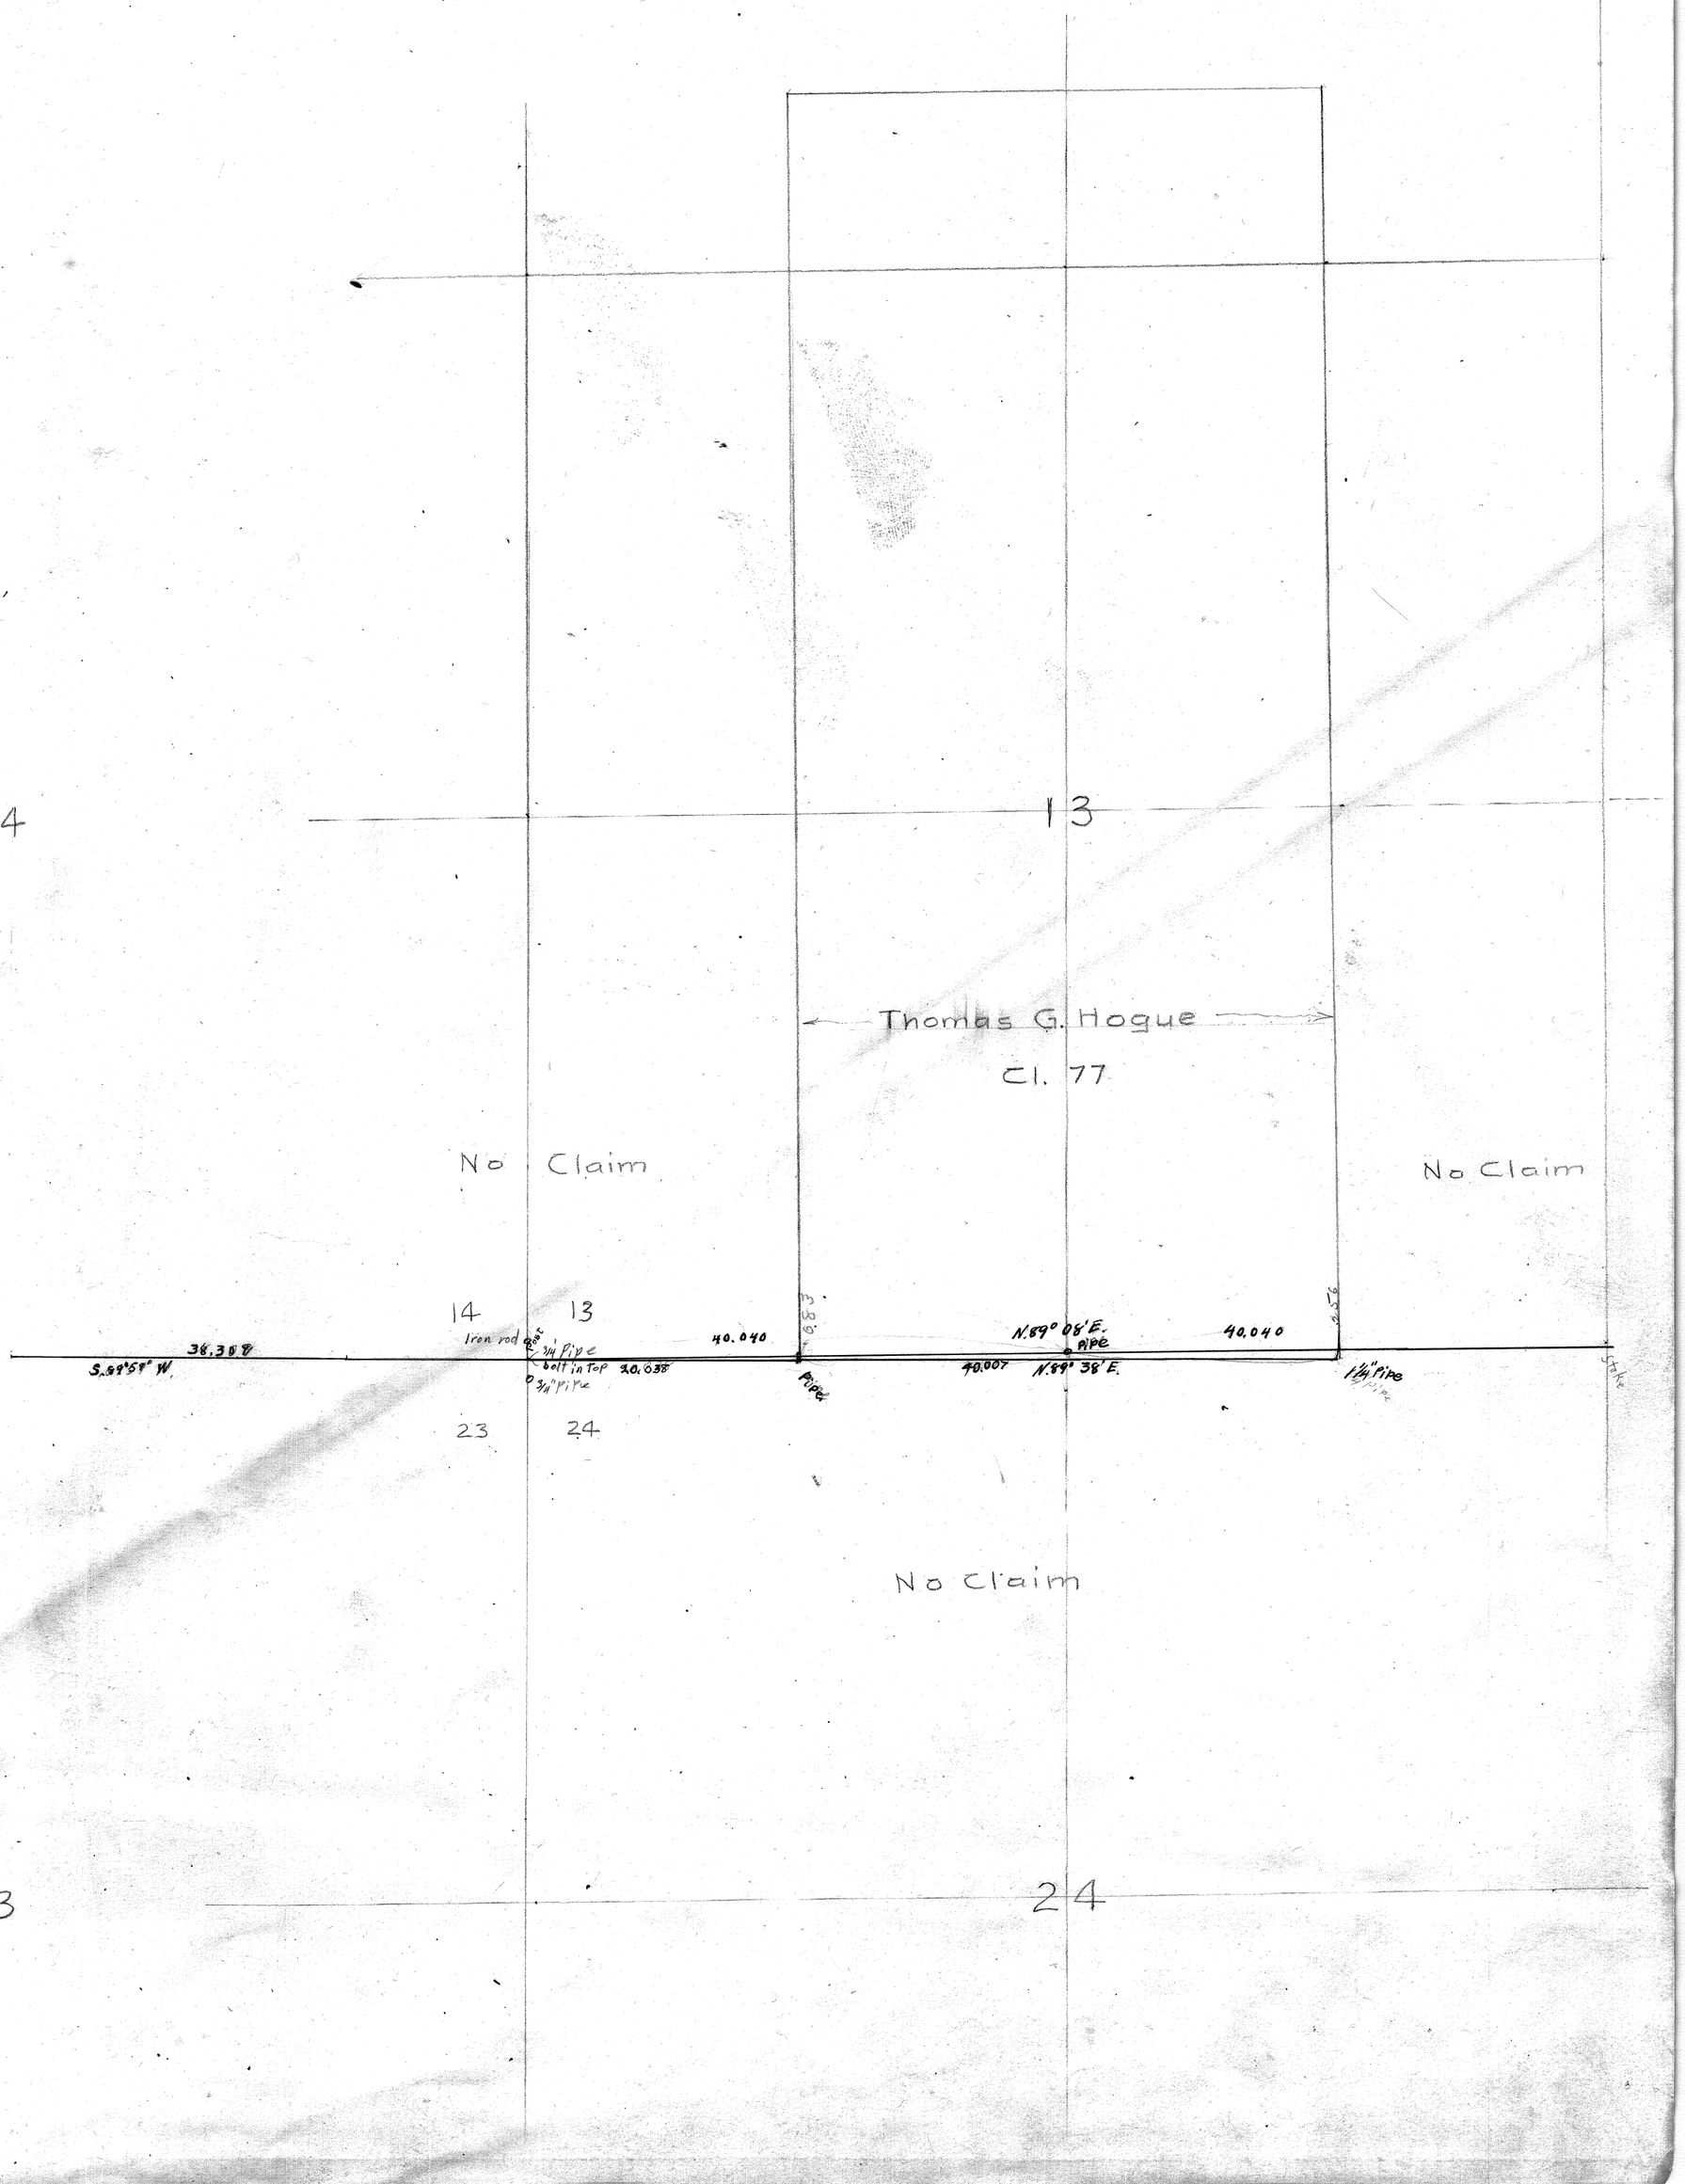

25

Survey No. #164 T. 12 S. R. 5 W.

Dick Higer

Beginning at Sec. cor. 13, 14, 23, 24

Sta.	Brg.	Vert. ∠	Ch.	
	West		0.000	
1	∠ Right 24'	1°	11.710	offset .033 N. from true bet east
2	Correction S. 10 ∠ = 2° on 2 = 1"		9.109	
3			3.263	
4			7.068	
5			7.484	
6			5.640	
		14 no 1.342		
	To cor.	+13° 30'	1.014 = 38.309	
	Stake at point of cor.		.044	
	back to R. Turned off on Line Set Stk.			
	Maple 16" N 17-50 E		1.402	
	" 30" N 21° long. W		1.63	
	Back to 14/13 23/24 thence East.			
7			8.000	
8			6.799	20.054
9	Correction 11 links N. Struck S. .082 to D.L.C. cor. from Sec. cor.		5.255	−.016
10	Sec. line cor. section. 33½' N.		8.000	
11	∠ Right 26'		12.116	= H0.170
12	∠ Left to cor. 11" 58'		5.906	
13			9.735	= H.294
	Correction 11 S. between		7.9	13.256 N. of D.L.C. cor.

Correction N. Vert. D.L.C. cor. 91' 4 links = 1 S. 1 W. D.L.C. 33

H.709 1.342 1.014
896 247 77277
2620 1207 9124
4238 805 709
376 93 20
37.032868 5 3
2 .9858
H.709 1 .27 R 1
H.7091 55H7 5
2773
.0H9 .033 .000 H2 .033 .044 .037 .0000 .0660 .0550 .212 .34 .56772 72°
15 3 2 36 67 46 20.054 .016 −.038
38.309 (H 27°30 W.)
.016 8.000 12.116 5.906 9.735 4.294 40.067
5506 657 H13 H2 2923 354 .044 H9
H0.170 40.040 .130
H0.170 5C9 361530 2H102 2008 387640
H.709 9.157 13.868 2H 55H7 5 2773 .9858 .9582H5
H.709 9.109 3.263 7.068 2H.144 7H8H 5.640 37323 .986 38.309 8.000 6.799 5.255 20.054 8.000 12.116 H0.170 5.906 46.076 9.735 55.811 7.929 63.740

Rest

SW. cor of D.L.C.
Maple 20" N. 2° 20' E. .351 ch.
Ash 30" S. 40° W. .420 "

19/24 ¼ Sec. cor.
Ash 12" N. 57° 57 E. .489 ch.
Maple 18" S. 46° 32' E. .193 "

SE. S.E. cor. of T.G. Hogue.
Set ¼" Pipe
Dogwood 5" N. 08' E. .516 ch.
Oak 7" N 68° 12' W. 1.417 "

8.000 12.116 9.735 7.929 H.294 H2.014

26 correction N. 33" From Sec. cor. to 6 cor. cor. 7.980

15 10.451

(Cor. North ∠ 21° 20' 2.250)

13/24 19 Reest. -2.096 = 80.080

Striking south of cor .818

Ash 30" N. 88° E. 10 Ch.

" 8" S. 19° 48' E. .305

" 6" S. 88° 30' W. .31 "

" 12" N. 70° W. .6H "

16 ∠ Left 90° 6.09 offset .609

17 ∠ Left 11° 23' 3.074 offset .607

18 ∠ Right 39° 18' .963 offset .610

19 ∠ Right 12° 55' 6.985 offset 1.361

N. 89° 27' E. 7.220

4.367

3.607

3.980

∠ Left 10' 6.645 offset .017 N.

Set 1½" galv. pipe + .42 to Triv.

Balm 15" N. 77° E. .075

2.194

1.806

.878

2.674

7.767

10.451

2.250

9.343

6750

1350

67

15

2

.8184

.0445

.009765 = 33'

80.080 / 773000

720720

522800

480480

423200

400400

3.074

23791

3074

9766

215

9

2

.6066

4.485

07479

62865

4889

279

48

6.8081

6.985

35322

13970

1397

209

34

2

1.9612

265

011

276

.221

.256

.260

.01378 = 47'

.276 / 20035

756 00

60105

155 450

140245

15205-0

63.740

7.985

71.725

1°.451

82.176

2.096

2 | 80.080

40.040

2.096

3.013

.745

6.808

12.662

7.220

4.367

3.607

3.980

6.645

26.019