C.S. # 168

Hardcopy 11-5 # 8

also see notes in file

F. B. 4-77

COUNTY SURVEY #168

 

77

Location of Mon. for M. A. Bauer
June 5th 10

0 East. Southerly

#168

	— 1-40	3.849	
Δ1	— 9 —	4.433	
Δ2	— 8-20	3.794	
3	— 3-40	8.000	
	+ 3-50	3.780	
	—	1.359	
4	— 6-20	2.000	
	— 6-45	8.000	
5	—	5.518	


6	Angle Left 3-30	5.570	Offset .340
	—	8.000	
Correct + 1-16			
= 3.0048	+ 1-30	8.000	
	+ 3-50	7.000	
7	+ 3 —	5.170	
8	Mon. R.L.C. line	6.657	
	—	.038	
	Striking N Stone of stone	.003	
	place mark .169 S. of pt on line	5.6535	
		5.305	5.643

29.49 / 3 = 9.83

29.1200
5.1181
29.1200
291.2
291.
145.
1.4548

Set Stone at 5.305 at 6.643 S & N of way

Paid

1-40	7	8-20	3-50
3.849	4.433	3.794	3.780
8599	5523	4397	3797
34641	37897	34146	34020
3464	3789	3035	3402
346	88	341	302
19	22	14	11
2	2	1	
3.8472	4.3998	3.7537	3.7735

3.847			
4.400			
3.754			
7.984			
3.772			
1.359			
1.988			
7.945			
5.518			
40.567			

6-20	9930		
2.000	19878		
9 399			
1.9999			
1.999			
3-30		3-50	3-
5.570	5.570	9.9776	5.170
0160	31899	2	36599
33420	50130	6.9843	46530
557	5013		4653
38990	445		413
003	5		30
.390	1		5.1627
003			
.393	5.5594		

1.0115

80.927		2880	
80		51101	
12900		2880	
80000		28	
1290000		2	
80000		1	
80		29.11	
1031416			

5.559			
8.000			
7.997			
6.984			
5.163			
6.657			
40.360			
032	50		
40.328	50		

Jan 16 29.11

.0148

80.927		40.128	.390
393000		4	2
323716		18512	1
69284		3292	1.69
5615	03	214	.1
1403	70		

40.567			
40.360			
80.927			
40.567			
5.559			
46.128			
40.360			
40.328			
29.11			
11.217			