178 - F.B. 5-70

C.S. 178

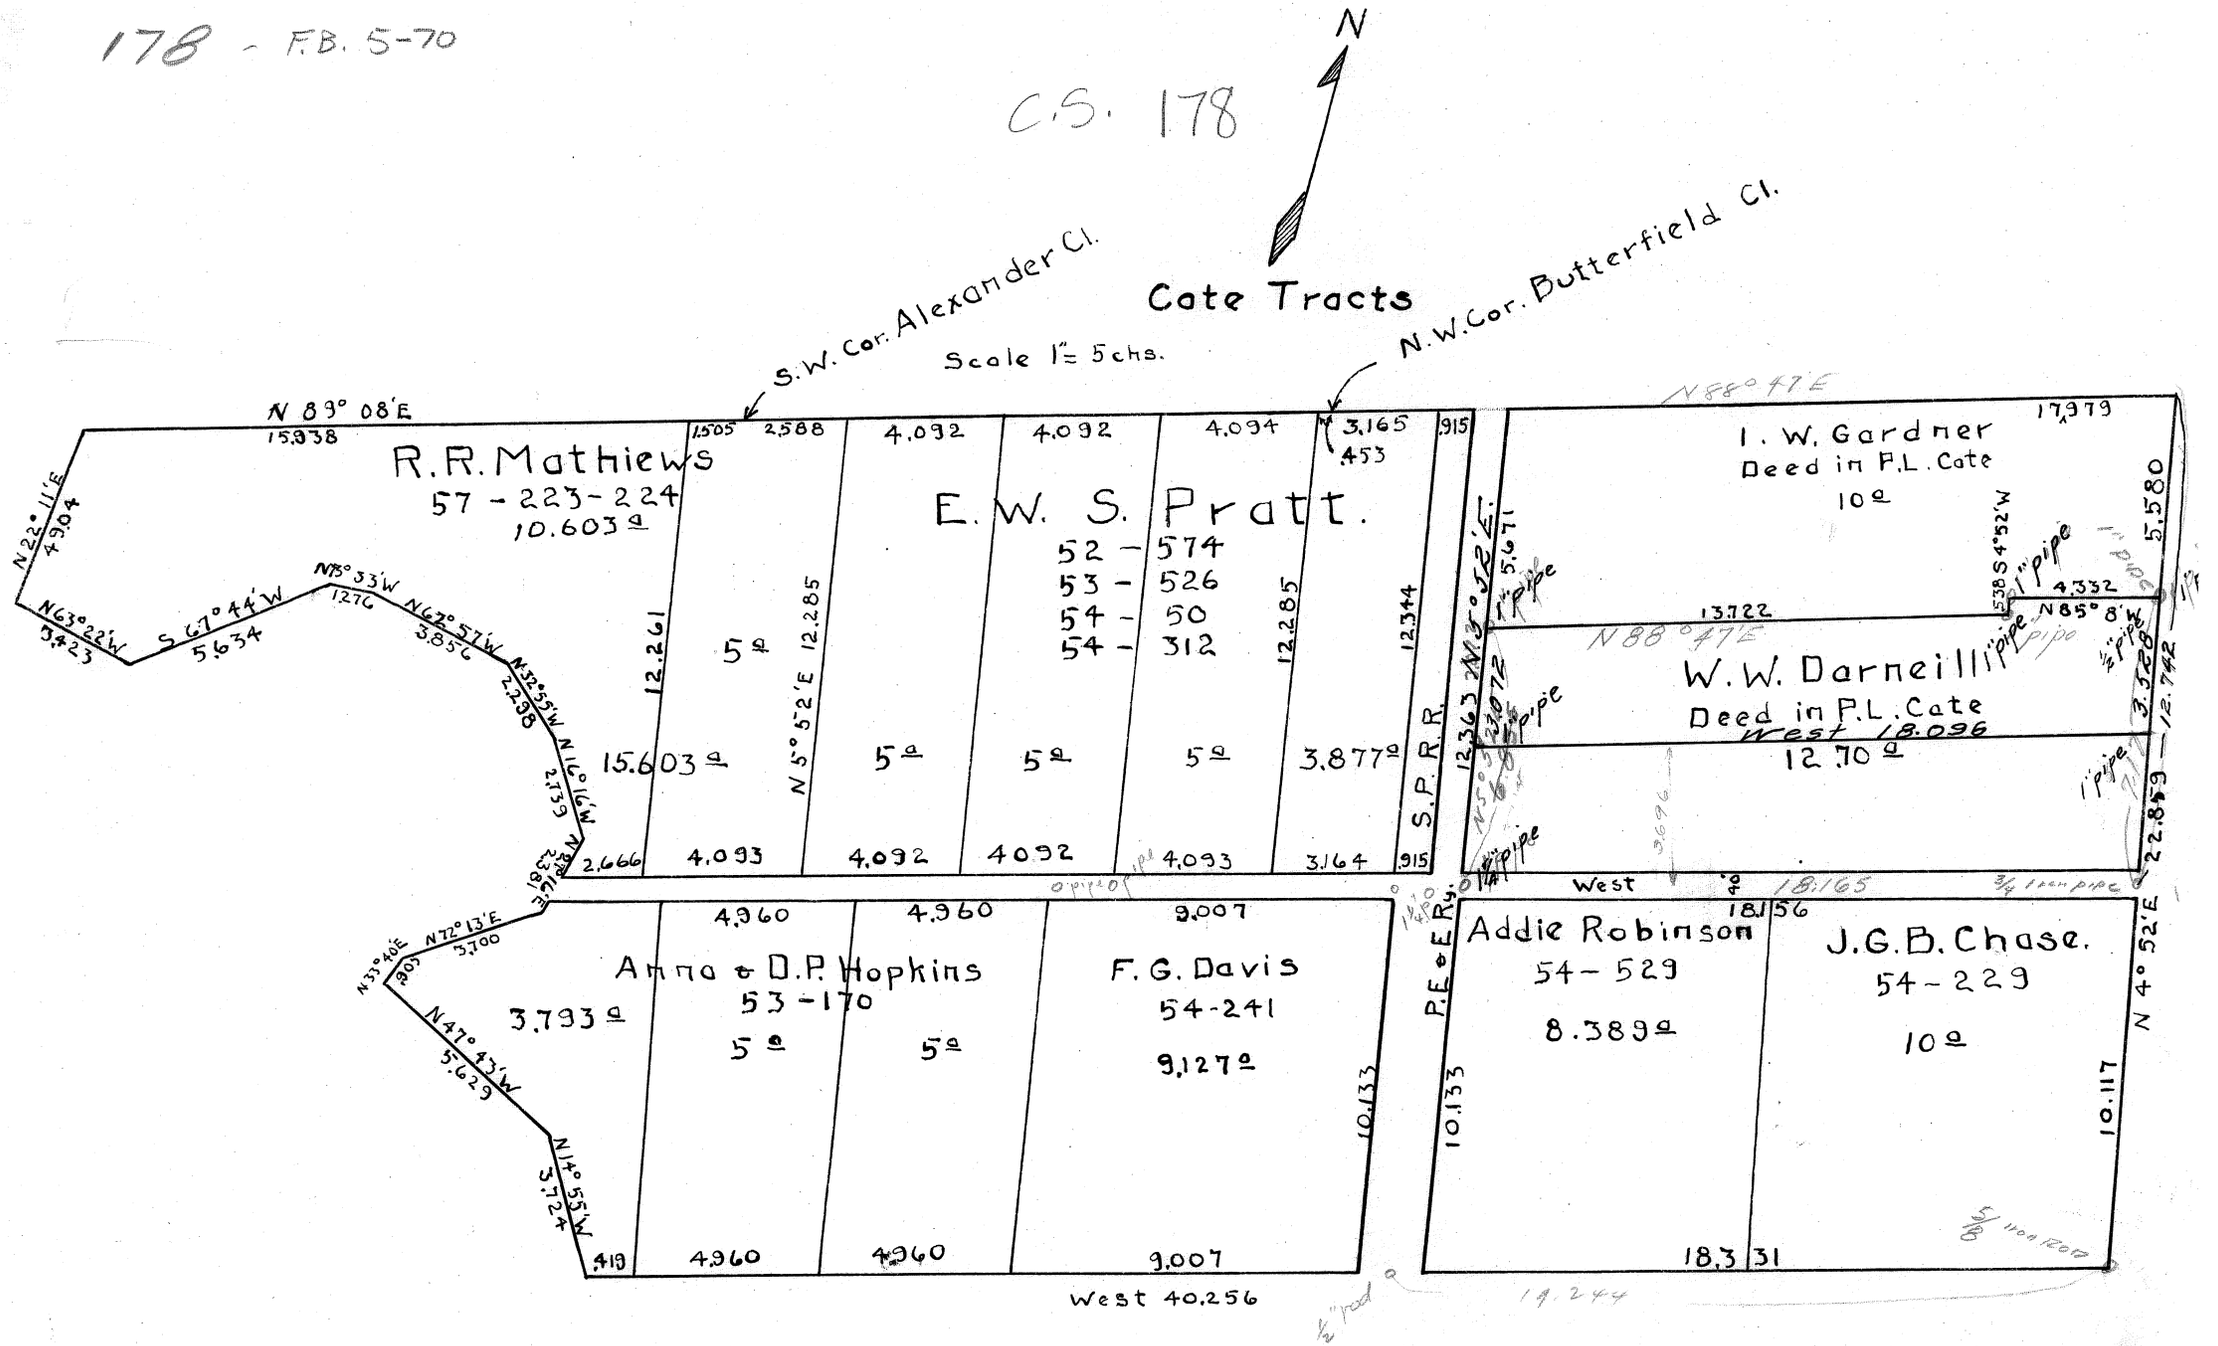

58

#178

Plat of Survey No. 75 Claim No. ~~45~~ 47 + 48

Section ..... Township 12 S. Range 5 W.

Scale: 5 Chains to the Inch.

Field Notes recorded at page 70, Vol. 5 field book, Record of Surveys.

MADE FOR W.B. Cate

James A Bennett
DLC 45

Joseph C Alexander
DLC 46

10 — 10 — 11

Lot cor. is .048 E. of W.C. cor.
1.119
1.167 = 77.0

Thomas P Adams
D.L.C. 48

David Butterfield
DLC 47

Sec 10 Sec 11

Sec 15 Sec 14

15

17,18-11/4

70 Fence line between Messrs
E.E. Reber & John Unger. #177
Beginning at a post near West
side of place. Took fence for line
East

| | | | | |
|---|---|---|---|---|
| | | | 8.000 | |
| | | 1°40' | 8.000 | |
| | | | 1.214 | |
| 1 | | | 11.318 | in R.R. |
| 2 | | | 10.656 | |
| 3 | | 3°10' | 8.000 | |
| | | | 8.026 | |
| 4 | | | 9.035 | |
| 5 | | | 10.149 | |
| 6 | ∠Right 14°43' | | 7.608 | offset 1.933 |
| 7 | | | 6.838 | |
| 8 | ∠Left 62° | | 2.189 | offset 1.933 Set ¾" Pipe |
| 9 | back to Δ 3 | | 4.846 | |
| 10 | S. | | 1.500 | |
| 11 | E. | | 4.573 | |

#178 Survey No. 75 For W.B. Cate
D. Butterfield, I.A. Bennett and Thos. Adams' D.L.Co.
T.12 S. R.5 W. Ports of X
Beg at ¾" pipe in cen of road and chuny

| | | | | |
|---|---|---|---|---|
| 1 | S.89°32' W. Corrections S. 45' Correction S. 15' for 37.832 | | 18.406 | cen. of RR. |

Length of road thro place is 40.933
− 2.211 to 14th P.C.

2.189
193300
176590
16710
7886
7060
816
7.997
1.214
17.211
11.318
7.988
36.517

39.185
10.656
28.529

8.000
7.997
1.214
11.318
10.656
7.988
8.026
9.035
10.149
7.358
6.838
1.028
89.607

2.189
5964
8756
1313
197
10
1.0276

39.185
4.846
34.339

37.832
15.317
22.515

71 X.

2 Rod set 1" pipe
Ch tem 8°N. 75° 45' E. 69 ft.
3 " 3" N. 35 W. 268"

3 S. 89 32' W.
correction N. 28'
Striking N. of cor.

4 S. 89 32' W.
correction S. 24'

5

Striking N. of cor. already set
Oak 10" N. 23' E. 899.
" 10" S. 89° 33' E. 1.554
" 30" N. 30° W. 033
Back to △ 0.

6 S. 44° 52' W.

7

West

8

Bus of R.F. S. 5° 52' W.

9

10

Initial

4.988 / 36 left.
+.021 Dr. Pickerel Mk.
S. .293 = 22.515
22.222

15.338 = 15.317
.168
7.985
8.628
16.765
+.152 to W.C. on N. bank to con. of Mary's River
+.678
.28 H 17 H 3 Set Oak Stake
.01 H to face of tree
set 32 3/4 x 1 iron rod

12.742
9.816
+.301 = 22.859
set 1/2 rod
N. .081
E. .107

18.788
+.463 19.2 H
set 1/2 rod

5.335
5.062 9.921
-.013 to cor. in fract. S.W. set 1/2 x 18 rod
.080

37.832
7.985
8.628
54.445

.477
22.859
22.770
199278
2849 20
199278
856420
7971 2
5930 80
4981 95
948850

22.859
22.558
.301

22.859
14 2872
9143
1824
91
19393 H

5.062 9.921
5.049 4.972
.013 5.049

2 19.921
4.960
.961
4.947
3.773
4.331

.100
.193
.293

18.466
4.322
22.788
15.338
37.832
7.985
8.628
54.445

.463
18.788
.007
18.781
.463
19.244
-.463
18.781
5.335
5.062
29.178

.284
.168 .00492 = 2 H
.116000
100512
15488
13412 0
19980
1 6220
1 3210

72

| | | | |
|---|---|---|---|
| 11 | | 3.713 | +1.234 |
| 12 | | 4.963 | |
| 13 | Witness cor. | 1.683 | |
| | Oak 15" S. 24° 45' W. .569 ch. | +1.119 | |
| | " 8" N. 19 36' W. .202 " | S.080 | |
| 14 | N. 15° 14' W. | 3.641 | |
| 15 | ~~N. 51° 14' W.~~ ∠ Right 18° 31' N. 47 43 W. | 5.629 | |
| 16 | N. 33° 40' E. | .750 | |
| 17 | N. 72° 13' E. | 3.700 | |
| 18 | N. 27° 16' E. | 2.381 | |
| 19 | N. 16° 16' W. | 2.739 | |
| 20 | N. 32° 55' W. | 2.298 | |
| 21 | N. 62° 57' W. | 3.856 | |
| 22 | N. 73° 33' W. | 1.276 | |
| 23 | S. 67° ~~44'~~ W. | 5.634 | |
| 24 | N. 63° 22' W. | 3.473 | |
| 25 | N. 22° 11 E. | 4.865 | |
| | | +.048 | |
| | Beg. at Δ C | | Set 1/2 Pipe on E. side of R.R. |
| | West to West side of R.R. | | Set 1/2" Pipe |
| | Not in Table | 8.172 | Set 1/2 x 1 1/2 in. |
| | for 5 A. lot on S. of road | 9.921 | Set 1/2" x 1 1/2 in. |
| | | +.496 | Set 1/2" Pipe |
| | Width of Second lot on N. side of road | 8.188 | Set ~~1/2~~ Pipe |
| | For 5 A. Tract on N. side of road | 14.093 | Set 1/2" Pipe |
| | | 5.440 | To Tree 15 in. |
| | | +.464 | To Pipe 14 in. W. of line |
| | Striking Mon stone at | 5.904 | |

1.119 = 40.256

22.731
W. side of R.R. to Cen of R.R.