Plat of Survey No. 80 #180 Claim No. 44

Section 16-21 Township 10 Range 4

Scale: 10 Chains to the Inch.

Field Notes recorded at page ....., Vol. ....., Record of Surveys.

Field Book 6-42-64

8

MADE FOR Chas. Vanderpool, E. M. Craddock

Chas. Tomlinson and John Tomlinson

9

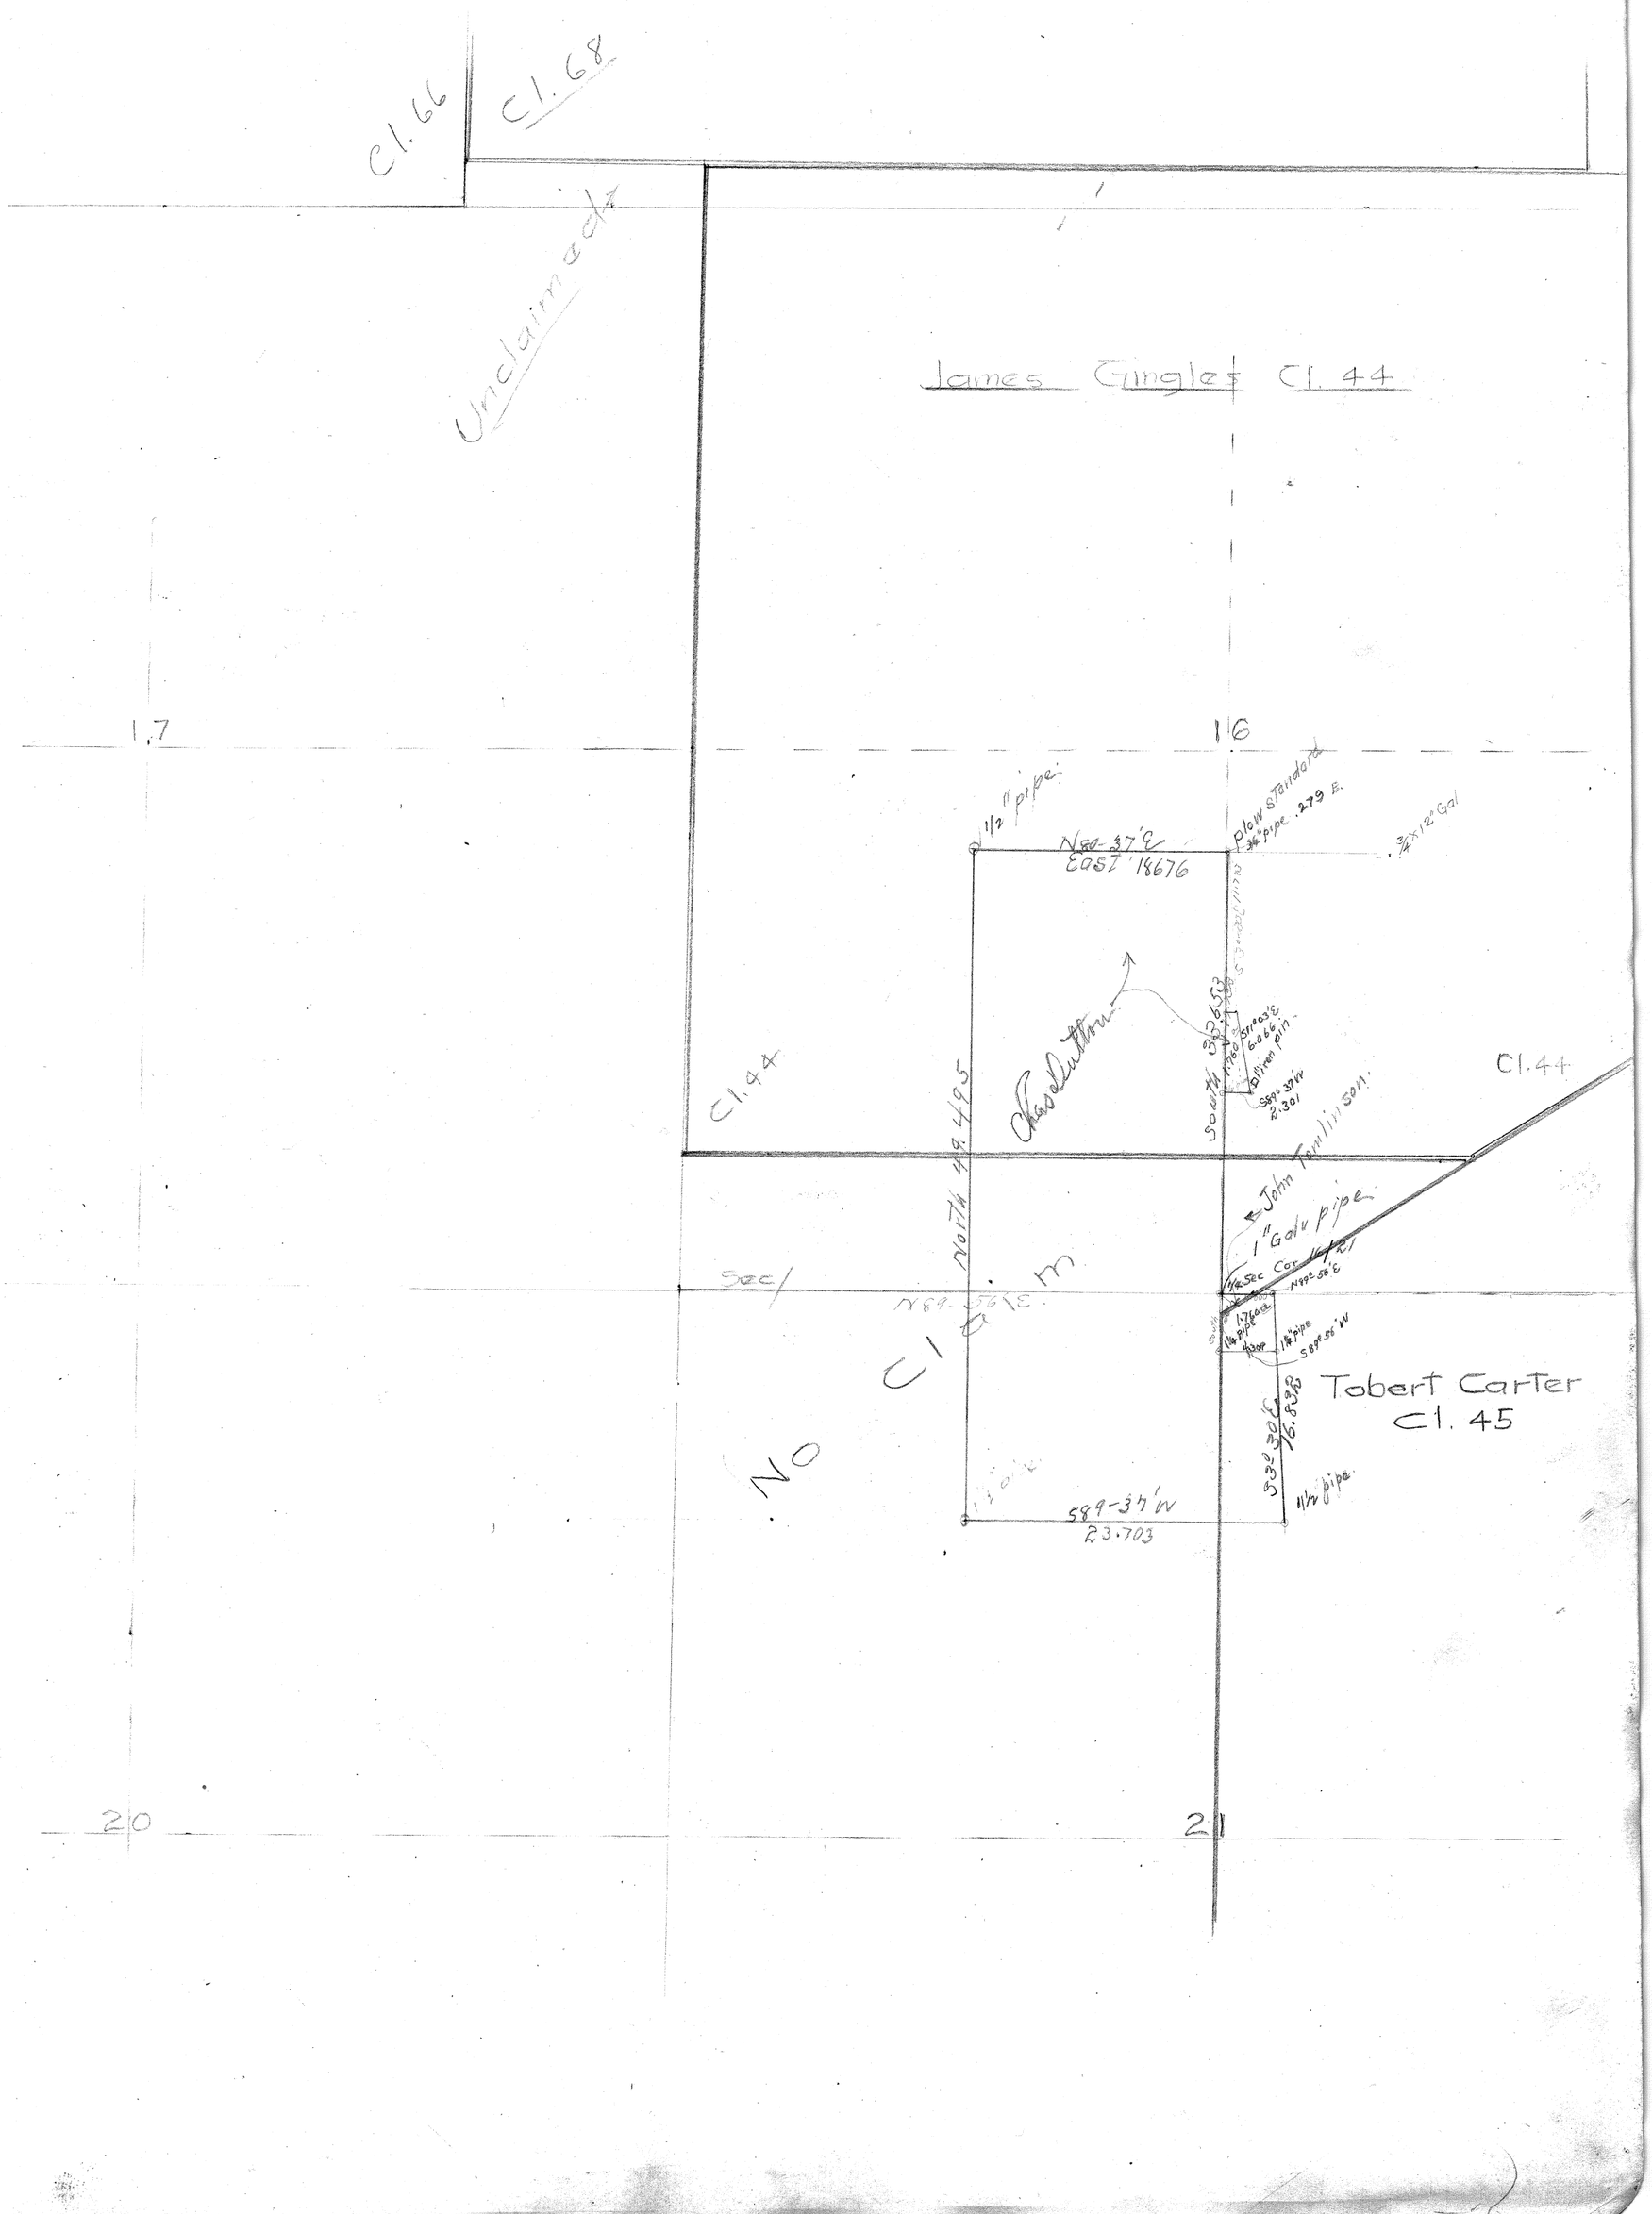

2

South — 1°30 8.000
Abut L From Twenty + 2-28 7.689
Δ⁵ +24' + -45' 1.525
— 2-10' 1.784
Δ S74° 26' E — 23' 3.265
Δ " " — 2-16 7.127
Δ S 24-56 E — 1-30 3.382
Δ " " — 7-19 2.303
Δ S 14-59 E — — 23' 13.697
Δ N " — .54 + .583
Δ S 2° — 14' W + 1-23 4.890
Δ " " + — 49' 3.130
Δ S 14-48 W — — 35' 10.993
North — — — .065 Gate post.
Terminus

Willow 5" S55½E 1.360
Apple 4" S S64-45W 1.962

Transit Tu. + 10.43'
+3.5 [illegible]
+ [illegible]
+ 7' [illegible]
+8- [illegible]
+1- [illegible]
+3 [illegible]
+ 4.30 Sketch
+6.25-
[illegible]

Survey #80. E.M. Brodie + Van Duyne Tail —

#180 Reset 8/9 Reestab. N.E. & S.E. Std. Oak stk 4x4 x RH
Beg 17.16
Oak 7" S 73-50 W .152
" N" N 1° W 1.076
Thence N [illegible] correction 8' W 3.35
-.033
+E .008

Reestab. I Cor Tas Tingeo Oak stk 1"x5"x24"

Z-30

2.303
8199
20727
2072
23
18
23840

Wall Flag
E & W. — 3 Tubes adj.
Alternate dia 13'

8.0008
7.6893
1.5254
1.784
18.998

Tulg C-10'

72-03 15-54 C-14"

.00241 = 8'
3,317 80000
CC34
13640
13248
3920

3.350
033
3,317

3

Back to 89 17/16 Cent S. 1152 W 6.354

" " S 72° E Face .310 W 5.787

" " S 72° E Face .517 8.128

" " Right R. 1° 36' .488 12.045

" " " " " .440 11.900

" " " " " .440 8.000

Corrected to Sec Cor .402 16.024

+ Left line S. .384 N 7.536

Corrects E 09 to ... .374 4.207

Sec Cor N 17 E ... 7.677

" " " 3.992

" " " 3.920

+ .003

striking East on Cem Angle pipe .286

angle R. 6° 0' 3.629

" Right 35' 3.461

" " 7.998

" " 9.518

" " " - 1.138

striking West 2 on 1413

See Envy. 44

Rec'd [illegible] with two std.

Back to 17/16 ; N 89-56 E 17.376

" " N 66-54 E 17.385

angle Left 22-00 10.097

" R 10° — 10.179

" " " 7.023

523-04 E = L R. + .448

Striking North .009

Object 6789 N

Object .354 E

Ties S.

W.C.

6.354
5.787
8.128
20.269 = 20.269
29720
40538
14188
1823
40
36589
3
7.536
75.766
4.206
379 70.972 .035
20 90.007 79.172
587 7.677
113 3.992
576 3.920
979 3.609
582 99.173
392 3
95.561
16.003 99.173
10.097 3.461
10.179 7.997
36.279 9.518
120.011 120.149
50.007 130
40.004 130.011
15.995 120.011
10.097 99.178
10.179 20.838
36271
7023
819
21069
3
515

4 Setup Course 28X 18X 16 for
Back ℄ 21/15 set W.374 S.035
Line corrected to E .00496 = Tan 17° 8' South
" To North W.00239 = " 8' W. Base
Back ℄ 5 Reds 32 W.46 Set
" oak post on Rodeo Face
Back ℄ 21/15 Hence N-L 1°-36' Left.
Right 1°-36' Comm E .042 E 3.349
" " .098 E 4.543
" " .160 E 4.923
" " .223 E 5.030
Angle R 1°-36' 3.997
18.952
12.338
13.356
3.847
2.490
1.862
4.459
.938
14.215
7.470 = 3.145 DLC cor.
7.940
— .000
.115
Set 1/4" iron Pipe.
Placed Vandergoot's Cor at .255 N + E .223
ash 11" N 58-15 E 1.118
ash .311
ash 24" S 38-15 W 1.475

Correction E 1.003 East
for
Back R — 28' — 3-30
Direction Sun July 9-10 Time
1 { 70-23 Tan N 13-37 4-27 m
70-10. 13-25
2 { 70-30 13-43 6-29
70-18 13-31
N 89° - 53 W
Comm of Angles on Back Lines

17.845
27720
35690
18491
1605
35
49821
478
02
478

17.845
160605
16060
1606
106
1
17.83778
3-30
2.490
6899
22410
2241
199
14
24864
4180
19912
2486
2994
020239

7.500
39.810
28.86
1.970
26.17
7.470
3.145
4.325
14.215
18.540
48.000
1.440
46.560
39.81
7.50
47.31
.478 W
41.75
.53 diff

62.249
29920
1244980
43574
5601
124
173797

6.78
40
46.78
19.61
27.17

1.738 E
1020 E
1.758 E
.255
1.003 E

29.615
28.86
1.233
80.094
17.845
62.249

.0125
Time 3 1/2 hrs 80.094
1.003.000
80094
202060
1.00188
18720
Paid

3.349
4.543
4.923
5.030
17.845
3.997
18.952
12.338
53.132
13.356
3.847
2.490
1.862
4.459
11.075
79.156
80.094
1.15
28.86
14.215
7.470
7.930
29.615
29.86
.755
29.615
28.860
.755
Tan 43' 1
3.75
1.75
1.93

Continued on Pa 21