Plat of Survey No. 82 #152 Claim No. 57

Section ..... Township 14 S Range 6 W.

Scale: 20 Chains to the Inch.

Field Notes recorded at page 21, Vol. 12 (fieldbook), Record of Surveys.

Field book 6 - p 10

See Co Survey Plat 82 on page 97 this book

MADE FOR Dick Riger

See W.R. Standruf on page 97

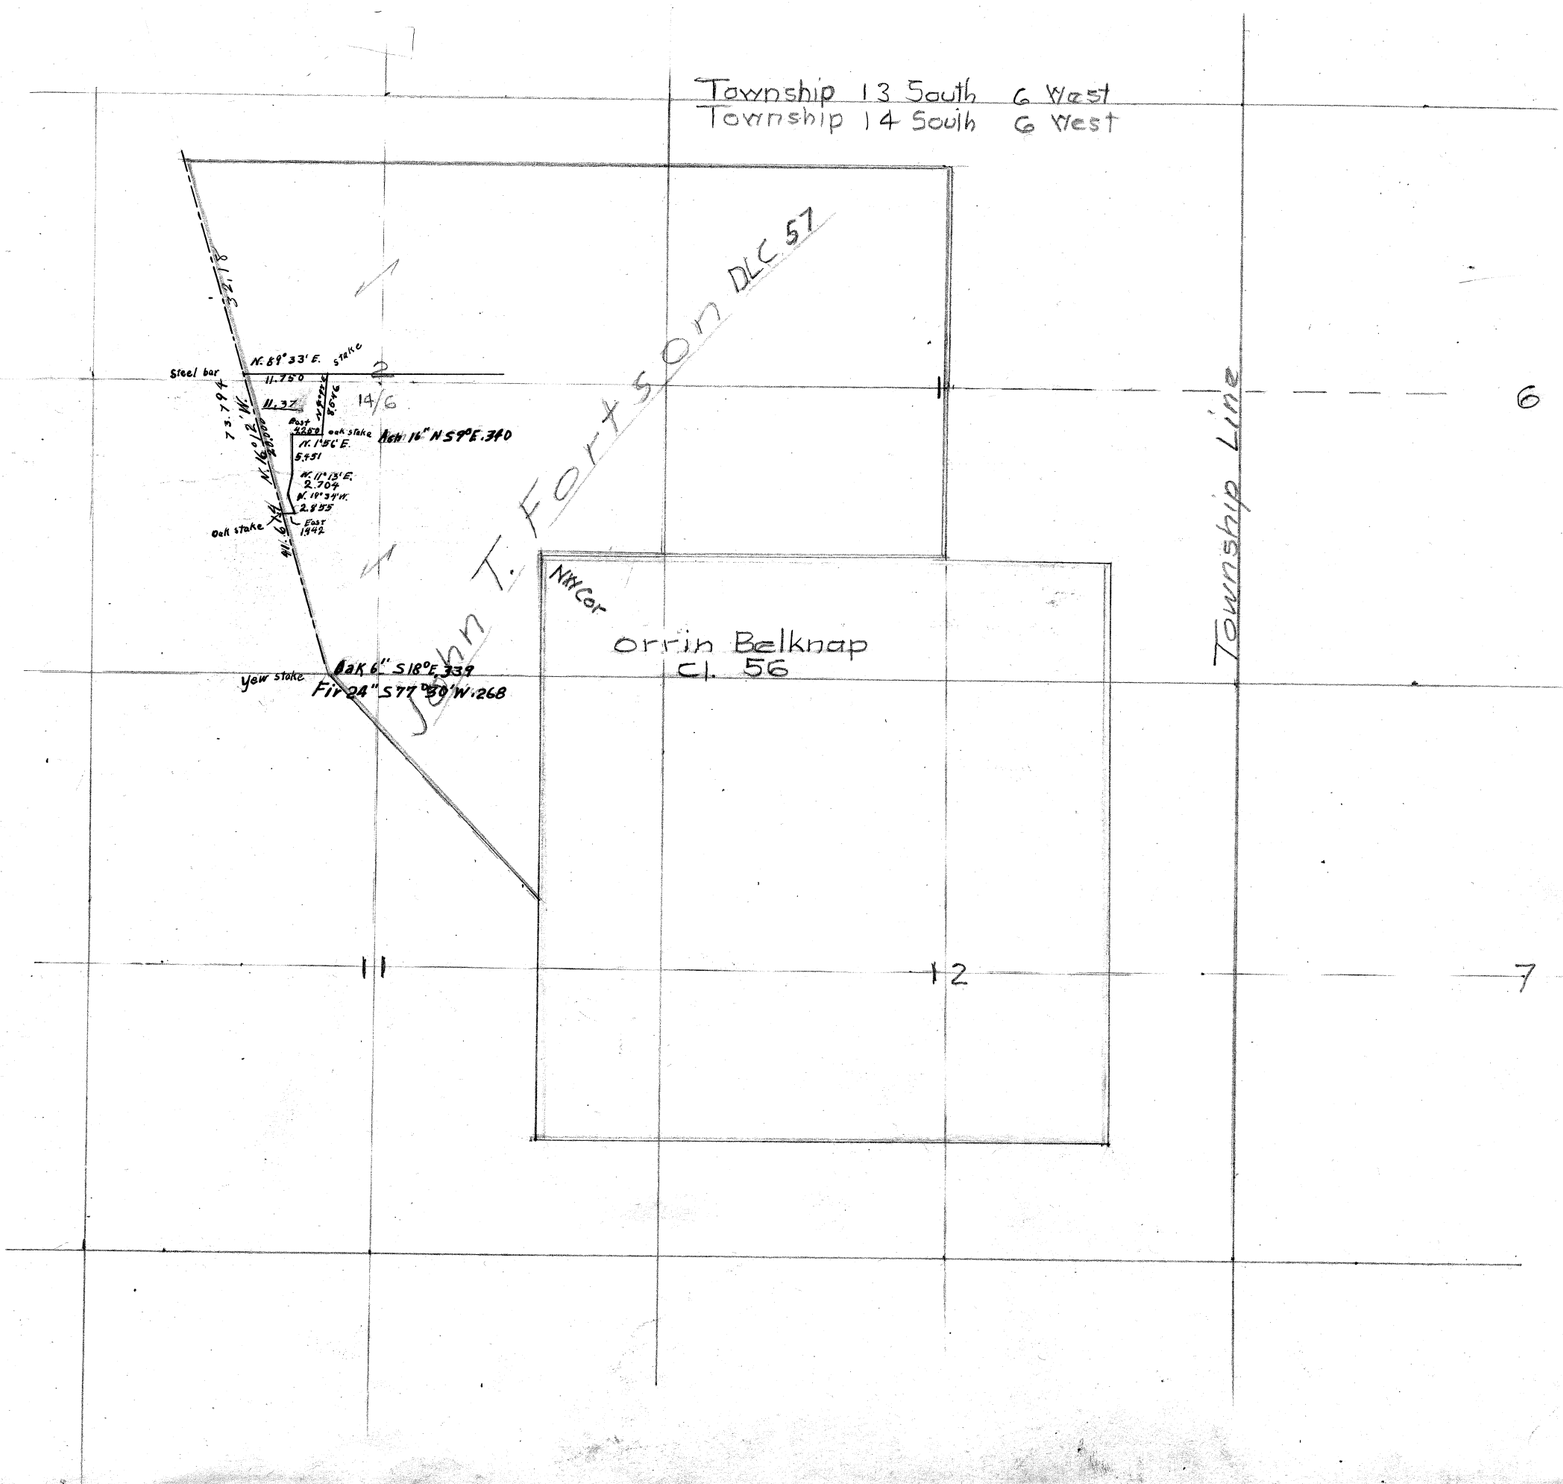

#182

Survey No 82

Traverse 2000

Reset Stone Corner Belknap Lake No. 1 Co.

Pine 10" N 15-30 E .910

Oak 14" S 59-30 E 1.710

" 20" S 28-45 W 1.260

Thence East. — 5.007

Tree Burg S 89-56 E 52.176 to a Pine N 89-37 E 23.494'

Angle R — 22½" 1-30 8.090

" R — 1°-17' — 6.641

" R — 16' — 7.081

1-15 7.779

Angle Left 4°-09' +2-10 6.839

-2-20 .726

Pointed Stone 36" long Mark +1" N 6-45 E Oak 14" S 15° E Stone 24" long Mark N 37-32 W

Stake N- Tie 4.756 2.337

5-21'S = Station Ended Crossed From 1 Cor O. Belknap.

Thence North Cor N-4.5' +3-10 8.000

+6-55 8.000

Tree Dgd N 66° W 35.858 +7— 2.971

8— 2.416 8.000

Near Sloped Cor. 1.689

Angle Left 2° to Cor. Capped Cor. 3.898

1-30 8.000

1.924

1.309 Near Top Pine

Set Cor and Stake at N 1.44 & .045 E

Fir 7" N 60°45' E .304

" 15" N 68° W .931

Thence E. to Tp Cor. +3-10 3.908

-4-20 3.041

Dick Kiger et al. July 21-10

J. H. Gardner

W. S. Hopkins

Start 2 Pm.

at Mill Run

8.040

	Direct Obs et Sun. Hor. ∠	Vert ∠	Time	Scale
1	77° 34'	16° 51'		4.380
2	77° 23'	16° 38'	6.01	7.996
1	77° 46'	16° 58'		.542
2	77° 38'	16° 50'	6h 3M	7.995
1	76° 47'	16° 00'		.565
2	76° 41'	15° 54'	6h. 5M.	8.087
1	77° 09'	16° 21'		6.640
2	77° 00'	16° 10'	6h 7M	7.081
1	76° 14'	15° 18'		7.779
2	75° 58'	15° 08'	6h 10	6.831
1	76° 26'	15° 34'		7.993
2	76° 22'	15° 30'	6 11	.726
				79.614
				79.596

Azimuth is 4.5° W of North.

2-40	6.831	6.831	8.087		6.641
6.839	43 799	73270	11600		04220
7 899					
61551	61479	40817	48522		13282
6155	6147	1366	808		1328
546	478	204	80		265
61	20	49	10		14875
6.831 3	6.8128	4934	.04910		
		2325 N			
		.262	.0495		79.596
7.081	6.62		.1495		.091
56400	3999		.1985		
28324	5958		.0333		79.687
4248	595		.2315		Ff .9
354	59				
.032926	6613				

Time

			Water				
3-10	4-20	3-20	1/2	1/2	2	17.896
7.908	3.040	3.850	1	1	1	3.031
5899	41 799	3829	1	1	1	3.993
71172	27360	34650	1	1	1	14.770
7117	2736	3465	1	1	1	16.5
632	212	308	1	1	1	1.736
39	3	11				
7.8960	1					
	3.0312	3.8434	Total 11 6.6 hours			

+the. 2.50

12		− 2-50	8.000
		− 1-30	5.078
		− 1-30	4.582
		− 4-30	1.314
	Starting West Side		− .046
	Restarted ½ Ld	oak stk 4×4×18" with bur	
	Back to A32	+5 −	7.480
	33	+4-30	8.000
	34	+4-50	3.053
	35	− 2-30	2.151
36		− 10 −	2.892
37		− 14 −	3.607
38 W.		+4-10	5.747
West 38	Eng 9-01	−	5.558
39	Eng to 5-50	−	4.946
40	" Left	−17'	2.488
41	" "	−42' −10-40	2.080
42	" "	3°−20'−21-10	3.177
43	" "	−19' −7-40	4.923
44	" Right	−2°-46' −23-06	1.530
45	Compromise Left	1°-25' −29-13'	5.220
	Eng R	1°-35'	3.182
46	Thence S 16°-E.	33.05 dist.	9.463
47	corrects S 16°-12	+5-30	7.102
48		+1-30	5.215
49		+6-20	5.927
	Cont Line S16E	+ 4-20	1.581
		− 5 −	3.240

5 −	4 − 50	2 − 30	10 −	14 −			
7.480	3.053	2.151	2.892	3.607	7.991		
2699		1999	18489	3029	5.071		
67320	44699	19359	26028	32463	7.932		
6732	27477	1935	2313	2524	20.994		
448	2747	193	115	10	15.111		
19	183	2	23	3.4997	36.005		
7.451	12	2.1489	2.8479				
	1						
	3.0420						
1-10	10-40	21-10	7-40	23-06			
5.747	2.080	3.177	4.923	1.530			
13999	7289	35239	60199	28919			
51723	18720	28593	44307	13770			
5122	1664	953	4430	153			
401	41	63	49	137			
17	14	15	2	12			
5.316	20439	2.7624	4.8788	7.4072			
	5-30	1-30	6-20	19-23			
29-10	7.102	5.215	5.927	4.619	7.991		
5.220	4599	5.214	9399	23348	5.071		
87278	63918		53343	41571	7.932		
41760	6391		5334	1847	4.568		
3654	355		177	138	25.562		
104	88	4-30	53	13	314		
36	7.0692	1.582	5.8907	4.3569	25.248		
4		9699			15.111		
		41238			40.359		
7.5558	6-	41233			32		
11-29	3.240	274			40.685		
1.581	1499	41					
1799	29160	4					
14229	29164	41756					
1422	2916						
110	25						
1	1						
1.0762	3.2354						

13

Angle Left 86°

	−7-40	2.352
	−1-30	3.919
	−10-35	6.119
	1—	6.265
	+0-20	4.850
	−4-30	1.752
	−2-20	8.[illegible]
	+3-30	3.869

Angle Left 68-21½ Cor., Yew Stake R69

Place Cor at S 5,789 E 1,153 Set Stone Mound
fir 40" N 8° E 13.24
oak 8" S 65-31 E .064
base 50 21-32 8.276
Fence East .51 40 6.[illegible]
62 +3-30 4.483
53 Angle R.—30' +13-40 3.555
51 New Cor. +7-50 3.473
Thence S 34° E. +3-30 2.238
56 −2-20 5.570
57 −4-50 7.160
58 −1-40 4.760
5 29-50 E = Cyd 4-07 −3-20 7.443 to Cor.

Set Cor #58, 1.647 + West 533 oak at 3"x3"
fir 24" N 73° 15' E Slope .546 Slope
30" N 72° 15' W .498
For Humphreys: 0. Selkirk 1½" pipe at South .023 Pasture
+ 1.011 West

For Humphreys:
Set disc at —.090 W .0055, ¾" x 30" disc
N 20' W — 2.000
.589—54 W 10.00
N N—20' W
N 89— 54 E

Bal. to Cor. N 16-12 W .247

Sand Cr

2.352 / 8589 / 21168 / 1881 / 117 / 18 / 23184
9[illegible] / 35271 / 3135 / 234 / 7 / 3 / 38650
6184 / 55071 / 4885 / 183 / 60149
6.265 / 56385 / 5638 / 563 / 50 / 3 / 62639
4.850 / 43650 / 4365 / 242 / 29 / 2 / 48288
1.752 / 15768 / 1576 / 105 / 15 / 1464
74.000 / 73.794 / .206
6.015 / 6.264 / 12.279 / 57100
7.442 / .276 / 7.718
1.576 / 3.235 / 2.318 / 3.865 / 6.015 / 6.264 / 4.829 / 1.746 / 7.993 / 3.861 / .099 / 41.801 / 31.993 / 73.794

3.8614 / .4250 / 0217 / 4.03[illegible] / 11.750 / 7.715 / .02[illegible]
21-32 / 9302 / 7.416 / 4.423 / 31397 / 31807 / 3980 / 354 / 4 / 47145 / 5.570 / 71999 / 50130 / 5013 / 501 / 5 / 13 / 55652
34-[illegible] / 29-50 / 4 / 13-40 / 3.555 / 91179 / 31995 / 2488 / 35 / 21 / 3 / 34542 / 4-50 / 7.160 / 44679 / 64440 / 6444 / 429 / 28 / 2 / 71343
1-50 / 3.473 / 76099 / 31257 / 3125 / 20 / 2 / 34404 / 1-20 / 4.740 / 5-73 / 7.443 / 3899 / 66987 / 6696 / 595 / 42 / 74302
3-30 / 2.238 / 1999 / 20142 / 2014 / 178 / 2 / 22336 / 4-07 / 7.430 / 97170 / 52010 / 743 / 520 / 66 / 53339

−9.7


7.430 / 24799 / 66870 / 6687 / 520 / 29 / 1 / 74107

Paid