70

Plat of Survey No. 77 #199 Claim No. 37

Section 6 Township 14 S. Range 5/6 W.

Scale: 10 Chains to the Inch.

Field Notes recorded at page 1, Vol. 8 field book book, Record of Surveys.

MADE FOR Mrs. Carrie Porter & T. N. Mc Fadden.

Tp. 13/5

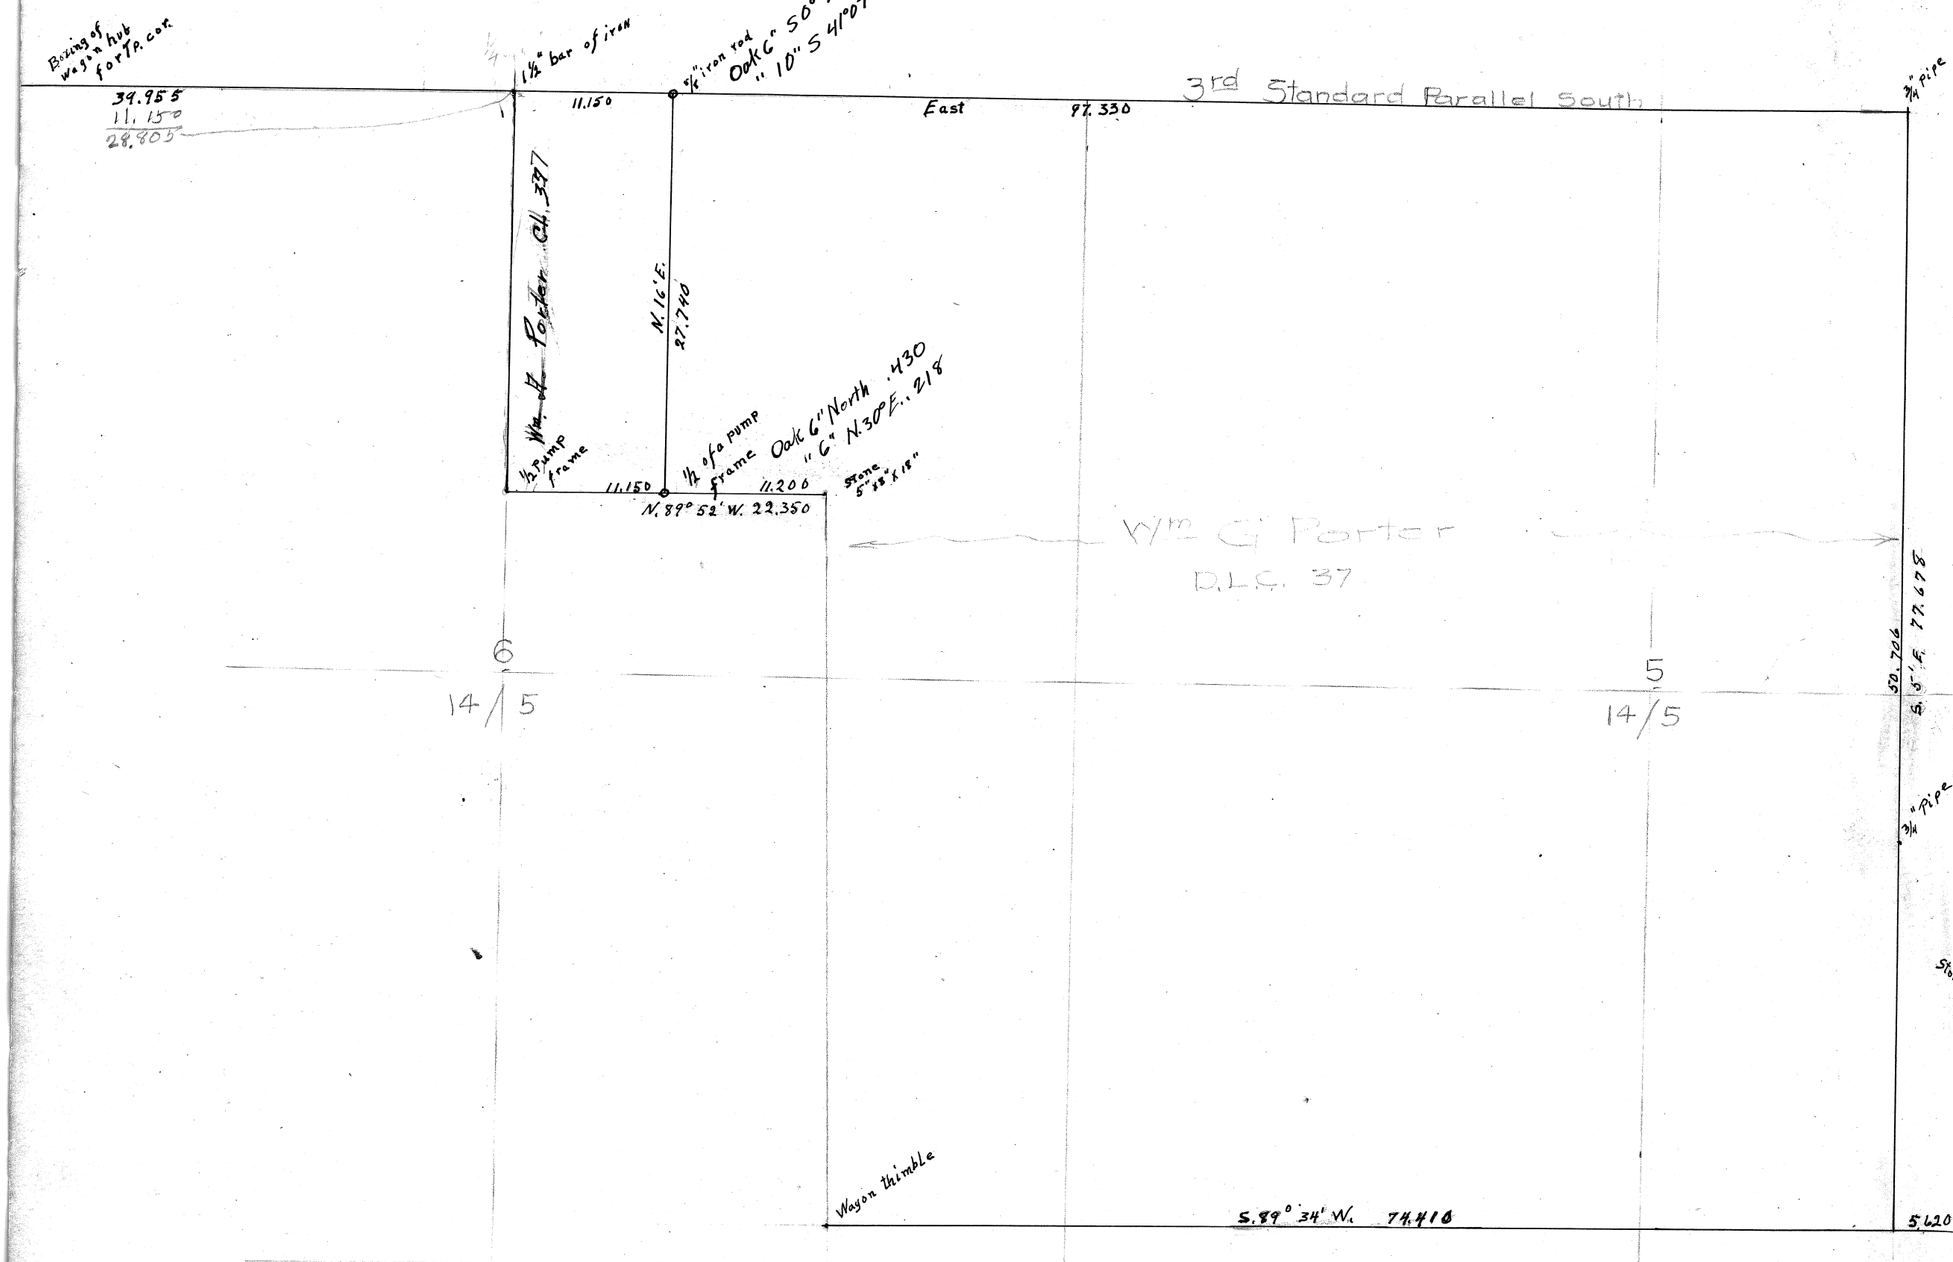

7
14/5

#190

By W. C. Galloway Nov. 5, 1910.

Rec'd.

Survey #77

Beginning at the interior cor. of Wm G. Porter D.L.C. #37 Tp. 14 S. R. 5 W. (only set cor. near noon)

Found orig. cor.

Set Stone 18" x 5" x 8"

Oak 15" N. 10° E. .17 chs. Std.

" 20" S. 50° E. .58 " Std.

" 30" S. 50° 15 W. .716 "

Shadow 31

30 Rec'd.

16

Beginning at cor. of Tp. 14 S. Rs. 5 & 6 W. set a boxing of a wagon-hub.

Both measurements from trees were different from orig. Found stake hole corresponding to brng.

Oak 10" S. 63° E. 1.72 ch. (240) std.

" 24" S. 30° W. 3.56 " (326) dead

Forked Oak 18" S. 6°25' W. .405 "

N. 89° 58' E.

correction S. 02'

1	∠ Right 1°22'	2°	4.657	offset .111
	∠ Right 07'	5°30'	8.000	offset .037.
			4.860	
		8°30'	3.345	
			1.984	
2		5°10'	8.000	
		4°	8.000	
3.		5°10'	.937	

Rec'd

Striking S. of cor + .308 = 39.903

.120

Found mound and print of stake.

~~5~~ Set 1½" bar of iron from which

6 Obs 9" S. 51° 15' E. .886 ch.

" 8" S. 1° 15' W. 2.250 "

	2°	8.000
	2°	8.000
	2°	8.000
	2° 30'	8.000
	2° 10'	8.000
	1° 30'	8.000
	1°	8.000
		40.560
5		1.106 = 97.330

Rec'd. N.E.

Set NE. Cor. ~~Sec 6 T 14 S~~ .052 =

Set a ¾" pipe

South

6 correction E. 5' 32.970 E.045

7 29.583 E.084

−11.847 = 50.706

Set a ¾" pipe

13.418

8 1.429

1.220 = 77.678

E.107

.99939 / 8 / 7.99512

.99902 / 8 / .99224

.99879 / 8 / 7.99032

.99944 / 8 / 7.99552

.99880 / 8 / 7.99040

.00403 = 1'

74.4) 1.0000 (

2976

240

.00138 = 05'

77.400) .1070 (

774

2960

2322

638

32.970	29.583	13.418
831	831	
32.139	28.752	
9891	22553	
2637	18763	
.045198	7004	
	.086322	

7.995

.808

7.687

8.000

7.995

7.992

7.994

7.997

7.999

40.560

96.229

1.106

97.330

.052

32.970

29.583

13.418

75.971

1.429

77.400

.220

.052

77.678

East
North
West
correction S. 26'
6°
4°30
L Right 90°
2°30'
L Left 90°
2°20'
Back to ⅂ or John Lloyd's NE. cor. on first page
S. 89°08' W.
correction N. 10'
Set ½ of a pump frame 1¼"x⅝" or Tap.
Oak 6" North .430 ch.
" 6" N. 30° E. .918 "
Striking S. of Back to △ 14 N. 08° E.
cor. 4°10'
correction E. 08'

5.737
16.598
8.000
8,000
1.966
3.345
8,000
27.424
3.753
17.745
4.546
+.014 = 74.410
5.706
4.752
+.777 = 11.200
N. .030
6,300
5.627
+.002
.064
3.887
7.169

N. 18° of Shovel to cor. 14 Lod.
To N.W. cor. cl. 41
offset 3.749
offset 4.542
Set ½ of a pump frame Oak 15" N. 43° E. 5.71 ch. dist. " 15" N. 30° 15' W. .029 "
S.W. Ext.

3.753
.00999
3.3774
3377
337
1
3.7492
4.546
.71999
.10914
4091
409
69735
66973
6697
669
24
4.5421

.99452
7.9561 c
11.345
29699
102105
10210
680
402
2
11.3099

.793
74.415
.01065 = 37'
.79300
74 410
4885.00
446490
420100

74.415

Rec'd
S.W.

Set wagon thimble Orig cor.
Oak 12" S. 36° E. 1.06 ch. std.
" 8" S. 8 E. 1.14 " std.
" 12" S. 45° W. 1.10 " std.

5.706
76598
51354
51322
272
34
3
5.811

4.752
69799
42764
4276
332
42
2
4.7420

5.627
37999
50643
5004
396
39
1
5.6253

10.423
22.350
10.423
7821
.00287 = 10'
.06400
4470
19300
17830
14200
22.350
.02913

8.000
7.955
1.966
11.310
27.424
17.745
.014
74.415

5.641
4.742
6.300
5.627
.002
22.350

3.887
7.169
11.046

22.350
10.423
11.927
11.150
W. .777

17 10.930
18 2.742
19 3° 2.997
+.059 = 27.740
W. .709

Oak 6" S. 00° 20' E. 3.578 ch. Set 5/8" iron rod
" 10" S. 41° 07' W. 1.131 "
West 11.859 To N.E. cor. of D.L.C. 37

2997
36899
26973
26997
239
17
2.9926

11.046
10.930
2.742
2.993
27.711
.059
27.770
.030
27.740

11.859
.709
11.150