C.S. # 197

Hardcopy 12-6 # 28

also see notes in file

F. B. 8-25

#197

25 Survey # 101 For R. A. Sandiford

Beg. at Sec. cor 21/22 / 28/27.

Trees std. ∠ iron for cor.

1	South	19°10'	.470	
2	∠ Right 2" correction W.E.	20°54'	7.340	.311
3			.862	
4	∠ Right 44'	15°46'	2.907	.040
5		13°50'	1.424	
6		8°30'	.795	
7			.706	
8		6°30'	4.356	
9		12°03'	4.012	
		2°30'	3.968	
		22°30'	6.411	
10	ft. X ft. X ft. Shoulder on stone		.992	
	Natural Sandstone .003 N. of ¼.		E. .389	
	Fir 8" N. 87°43' E. .377 chs.			
	Oak 4" S. 34°19' E. .077 "			
11		7°45'	.957	
12		12°30'	9.555	
			.591	
			-1.266	
28/27	Rest.			
	7/8" steel rod		E. 1.402	
	Oak 18" S. 64°53' E.	2.110	chs.	
	" 18" N. 32°13' W.	4.932	" slope	
		4°10'	8.[illegible]	
13		4°30'	1.953	
		4°50'	6.717	
14	∠ Right 1°51'		6.804	.220
15		7°38'	2.958	

Dec. 14 1910. 12-6

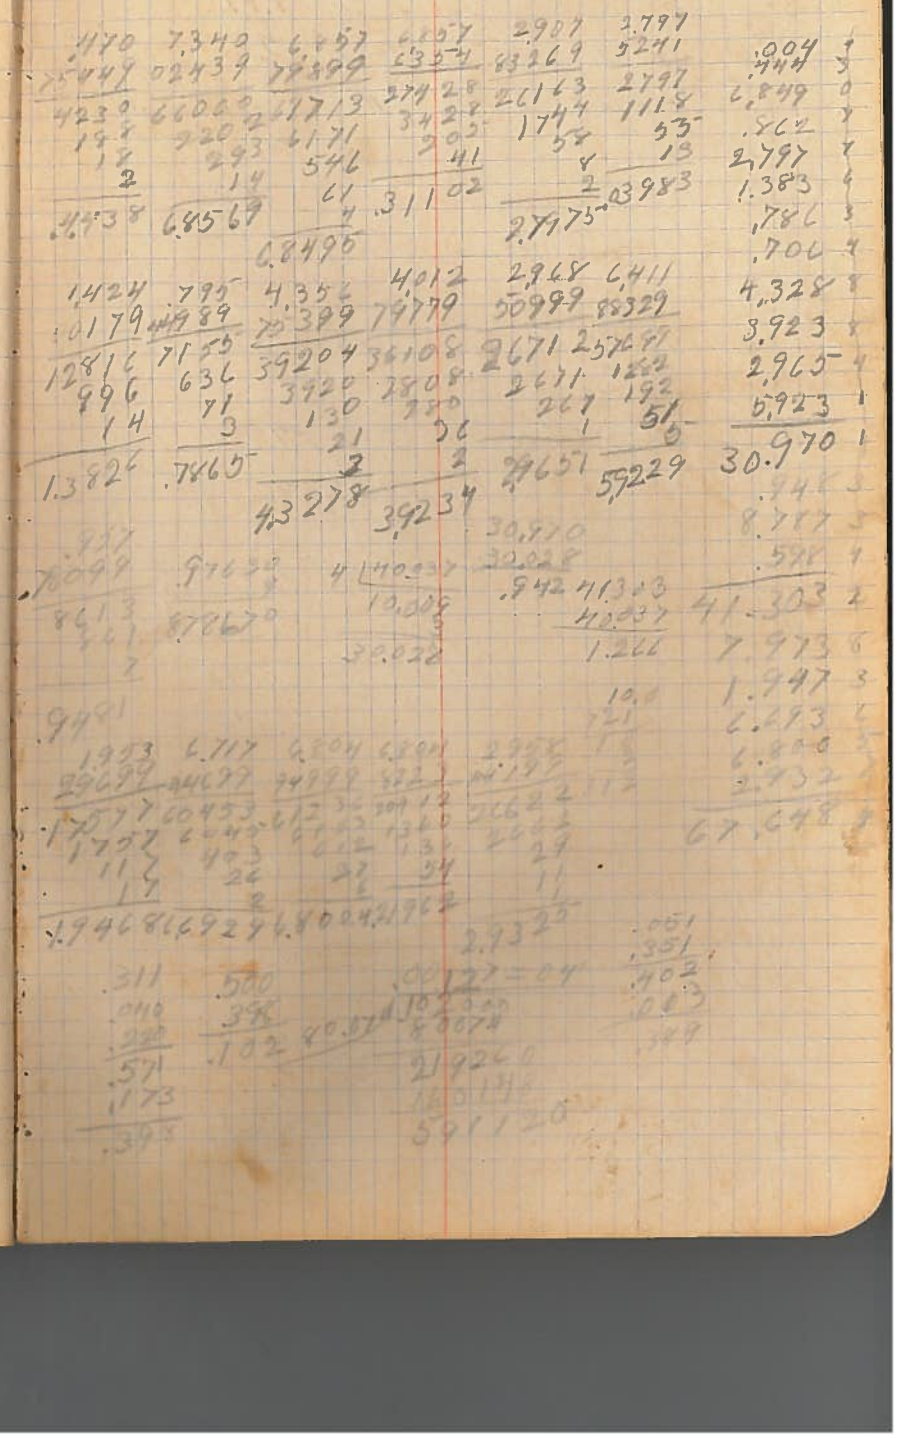

26

16			2°30'	1.076	
17			4°20'	5.229	
18	∠Left	1°45'	4°	5.190	offset .173
				+.468 = 80.074	
	Striking W. of cor.			.500	

Reest

33/34	∠Iron.				orig. cor.
	Fir 40° N. 71° E.			.89 chs.	Std.
	" 36° S. 31° E.			.17 "	"
	" 15° S 47°40' W.			.274 "	
	" 36° N. 10° W.			.12 "	Std

East
corrections S. 46'

19			4°50'	4.169	
20				1.337	
21				1.498	
22			3°30'	1.555	
23			2°	3.876	-1.712 2" pipe S. 6.6 E.
24			4°50'	4.876	+ 2.942 1" pipe 3/14
25			4°	4.592	
26	∠Right	90°	16°30'	.863	offset .827
27			3°	1.193	

Reest

			4°30'	4.777	
			5°30'	5.300	
	1½" pipe ∠ Right	4° 5'	1°30'	3.811	offset S. .180
27	Fir 20° S. 21°21'			2.531	orig. cor.
34	" 36° N. 37°		W.	.968 chs.	
			W.	.27 "	Std.

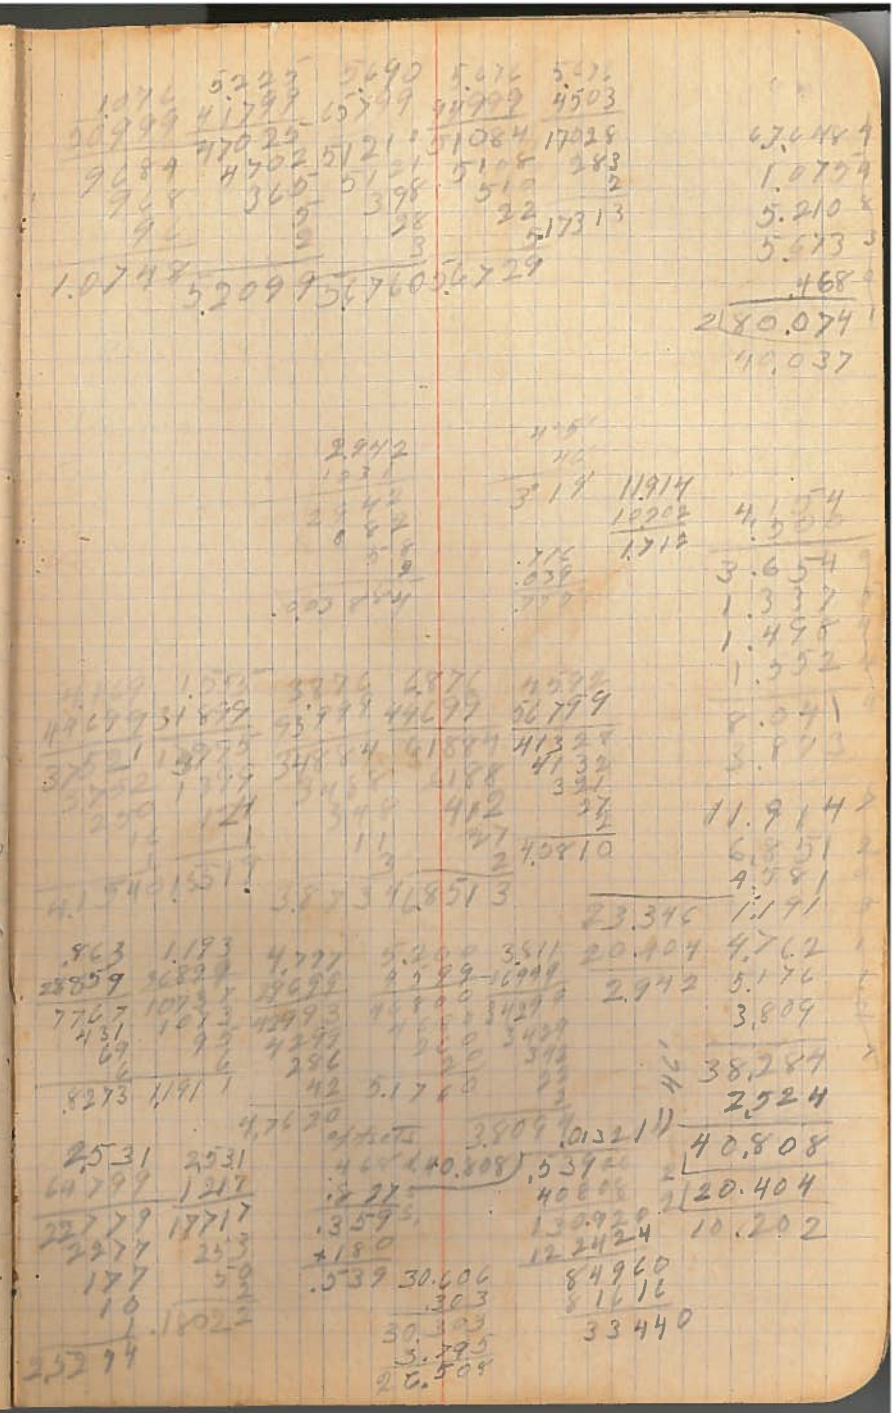

27

Back to △ 12 — 1.766

East

	correction S. 56'			
28	∠ Left 1°2	3°	6.472	
		5°	1.575	
		4°30'	8.000	offset
				1.354
29		5°40'	3.658	
30	∠ Right 28°47'	2°	1.809	offset
				1.870
			−.518	=20.309
	Set □ tubing		N. 175	
Fir	20" N. 14° 50'	E. 1.407	chs.	
"	30" N. 88° 8'	E. 1.236	"	
31	∠ Right 03'	4°30'	4.266	offset
				1.004
32	∠ Right 02'	6°50'	5.284	offset
				.004
33	∠ Left 06'	8°30'	2.629	offset
				.002
34		11°	1.598	
35		13°23'	2.535	
			+.181	= corrected distance 37.133
	Stone on W. line of Cl. 58		S. 075	
Oak	10" N. 60°46'	E. .098	chs.	
Maple	10" S. 6° 14'	W. .314	"	
36		9°30'	3.469	
37	∠ Left 12'		2.229	offset
				.108
38		6°00'	2.526	
39		5°	1.179	
40		16°05'	3.648	
41		4°50'	1.922	

42			10°10'	1.926	
43	∠ Left	12'	10°30'	1.6[illegible]	offset .033
.43			10°30'	8.019	
44			2°30'	1.752	
			5°40'	7.111	
			4°30'	8.000	
45				3.804	+7.432
44				-3.152	
				+1.050	

Recast.

Striking N. of cor. .857

Set Wagon seat Spring

Cor 24 S. 88° 29' E. 10.270 chs.

~~No 16~~ correction W. 02'

	9°50'	7.700
		7.700
	3°10'	7.700
	3°	1.110
		4.630
40		
41	1°40'	4.148
42	6°10'	1.128
43	11°40'	6.602
28 23		-.990
27 26	Striking W. of cor.	1.027
	Set ⅝ iron rod	
	Fir 16" N. 6° E. 4.007 ols. slope	

Recast.

orig Cor.

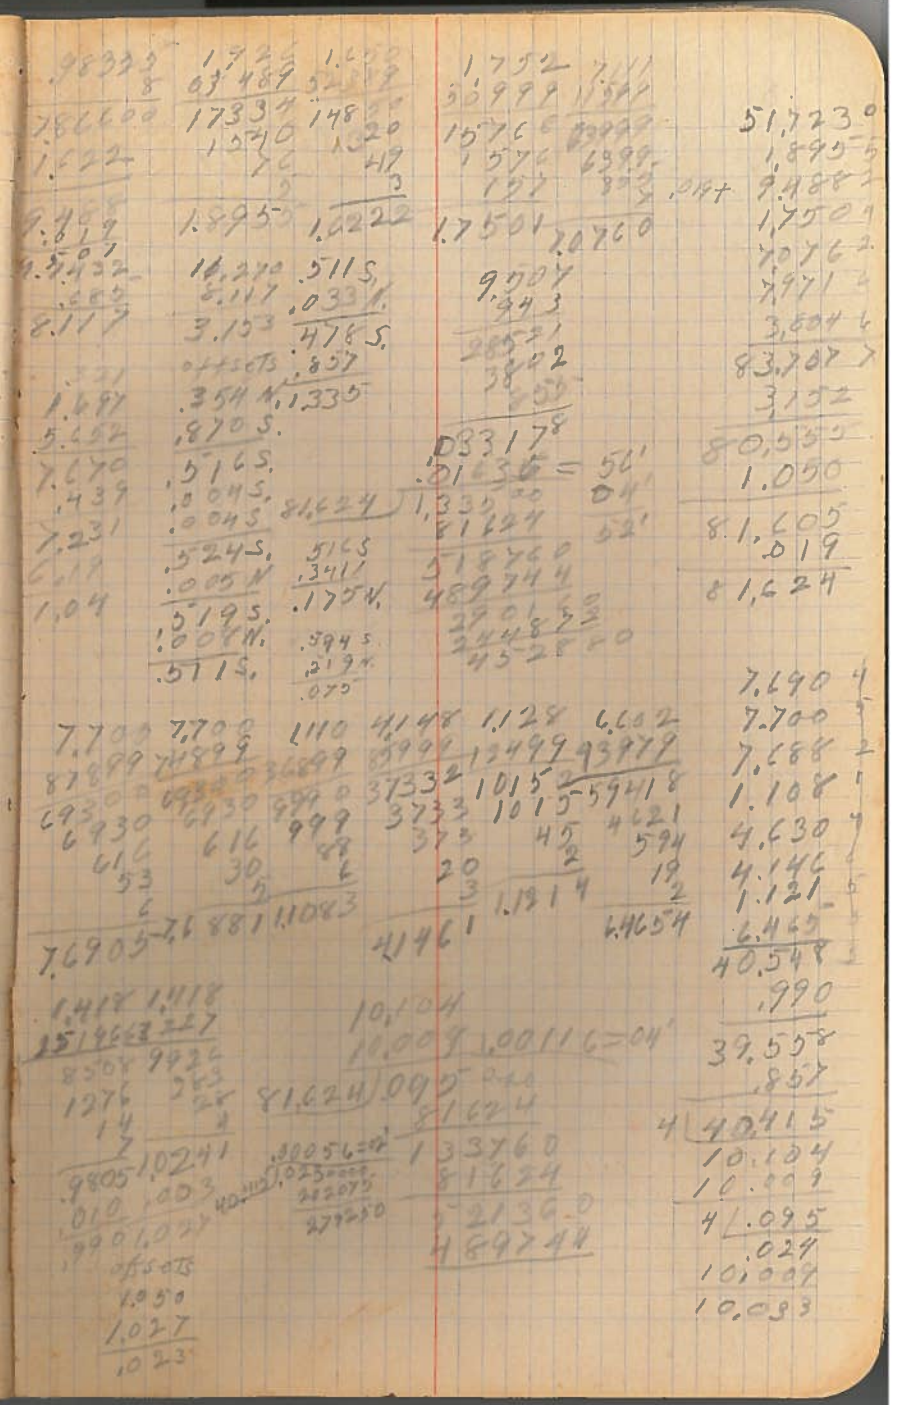

-29 Back to △ O.

44	S. 89° 40° E.	15°	4.171	
45	correction S. 21'	6°30'	1.283	
46			.832	
47		18°15'	5.585	
48	L Right 45°	90°30'	1.439	offset .018
49		9°45'	9.744	
50		5°30'	2.078	
			.603	
	Striking N. of cor.		.104	
51	Back to △ 10 — .942			
	S. 89° 08' E.			
52		1°30'	4.574	offset .006 S.
53	L Left 4°18'	2°10'	4.304	offset .322
54		1°30'	1.477	
55	L Right 1°23'	7°10'	5.348	offset .125
56		15°35'	.956	
57		4°30'	1.502	
58	L Right 1°42'		2.646	offset .074
			+.014	=20.285
	¾"X¾" tube		S..100	
	Fir 24" S. 62°06' W. .378 chs.			
	" 24" N. 63°26' W. .300 "			
59	S. 12' E.		3.225	
60		6°10'	5.229	
S.E. cor. 20A			1.715 = 10.033	

4.171 1.283 5.585 1.439 4.744
3956 0839 07949 92689 62581
3763 11547 4502.65 12951 42196 4.039
208 1156 2230 1151 3795 1.275
37 38 502 86 237 .832
1 11 39 2 23 5.304
4.0387 1.2750 5.3036 1.4191 4.6753 1.419
4.679
1439 2078 .104 20.309 2.078
9031 04092 .1012 20.215 .603
1439 18702 .123 4.094 20.215
431 1870 20.315 .09608=21' .024 20.404
12 102 .12300 20.309 40.619
.01882 .12290 20.286-2
17.1000 20.309
2.0683
10.033 .0240 60
.002-39=08'
20066 12'
39316
3.0097
4574
6.6992
4116 9304 4301 4301 1.477 5.348 5.306 4.572
411 92999 41998 89942 51869 91299 41142 .387
411 38736 38709 30107 13293 48132 10612 4.183
27 3573 3870 1720 886 4813 2122 4.299
2 387 30 387 118 106 55 1.430
3 4 34 1 2 21
4.5722 4.3007 1.2885 5.3248 1.4298 5.3060 .12808 5.305
.956 1.502 2.646 3.229 .921
423 69 29 699 .006 7692 43579 1.497
86.04 135 18 .316 5292 47061 12.625 17.625
573 1351 .124 3781 1.56 12.640 2.646
28 90 .188 1 05 .10 2.646 .014
1 13 .078 18 2 .014 20.280
.9206 1.4972 2.110 .07849 .21935 3.225
.100
3.125
5.193
1.715
10.033

Cor. on N. side of Sec. 27 2.977 W.
of ¼ sec. cor. 27 & on W. side of
J.C. Wood D.L.C. 58 set oak stake
E. of where it was set in survey 47 1.05 chs.
Fir 12" S. 14° 55° W. .278 chs.
" 20" N. 80° 50' W. .174 "