C.S. # 206

Hardcopy 11-5 # 20

also see notes in file

F. B. 8-40

~~38~~ 40 C.S. 129 #206

Sec 35 Tp. 11 S R 5 W.

Beg. at a point about the intersection of the west side of the C & E. R.R. R.W. & the E. side of the wagon road leading from Corvallis to Polk County.
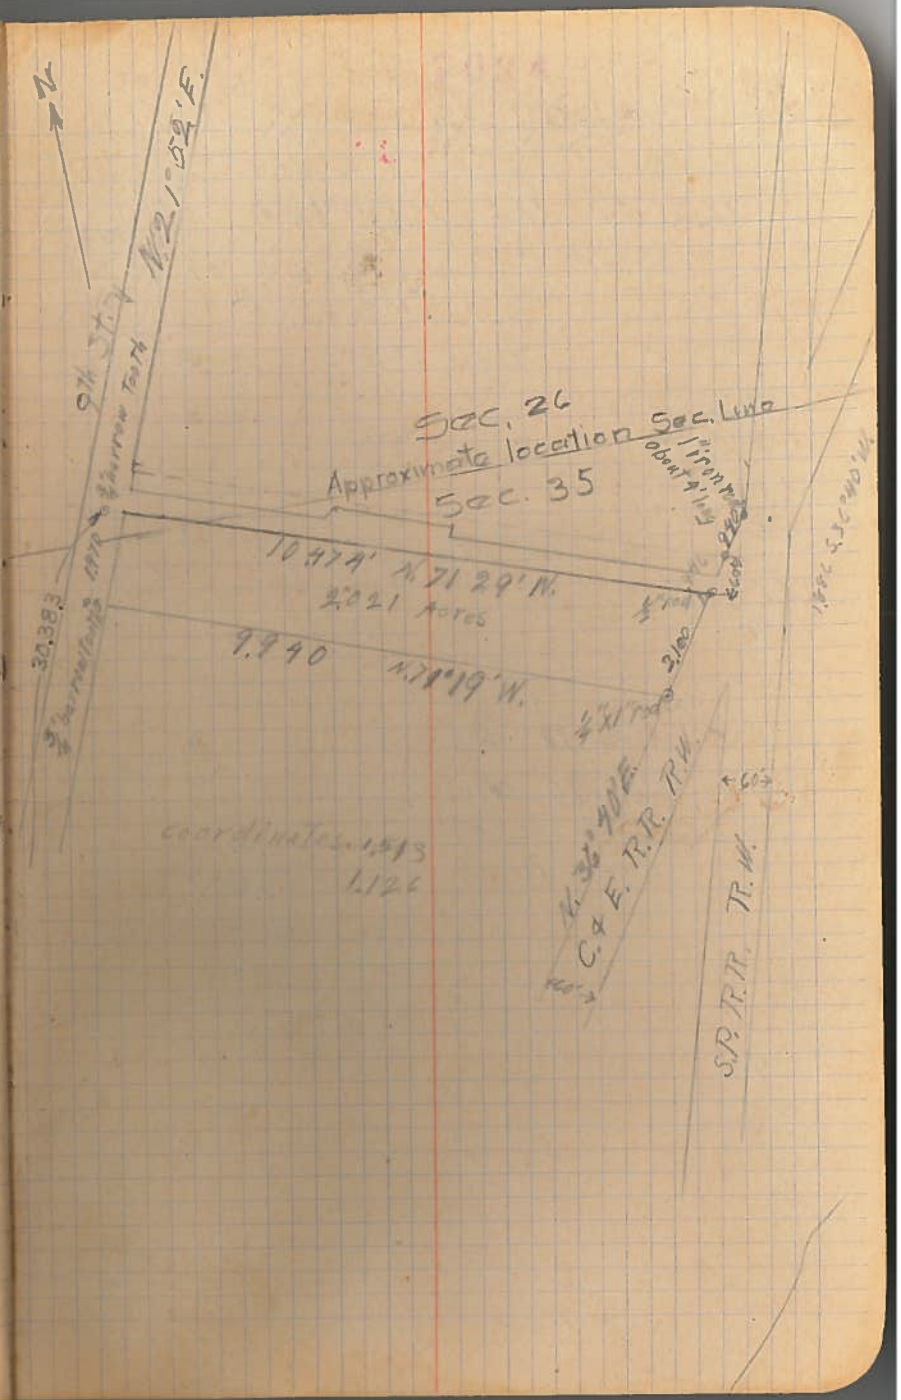
N. 21° 52' E.	16.148	To wire fence N. old orchard.
	12.240	.192 Wire fence
Set out into cen. road	1.995	3/4" Harrison
	30.383	
S. 71° 29' E	10.974	1/2" Iron
S. 36° 40' W.	2.100	1/2 x 1 iron
N. 79° 19' W.	9.940	3/4 Harrison
N 21° 52' E.	1.970