C.S. # 212

F.B. 6-46

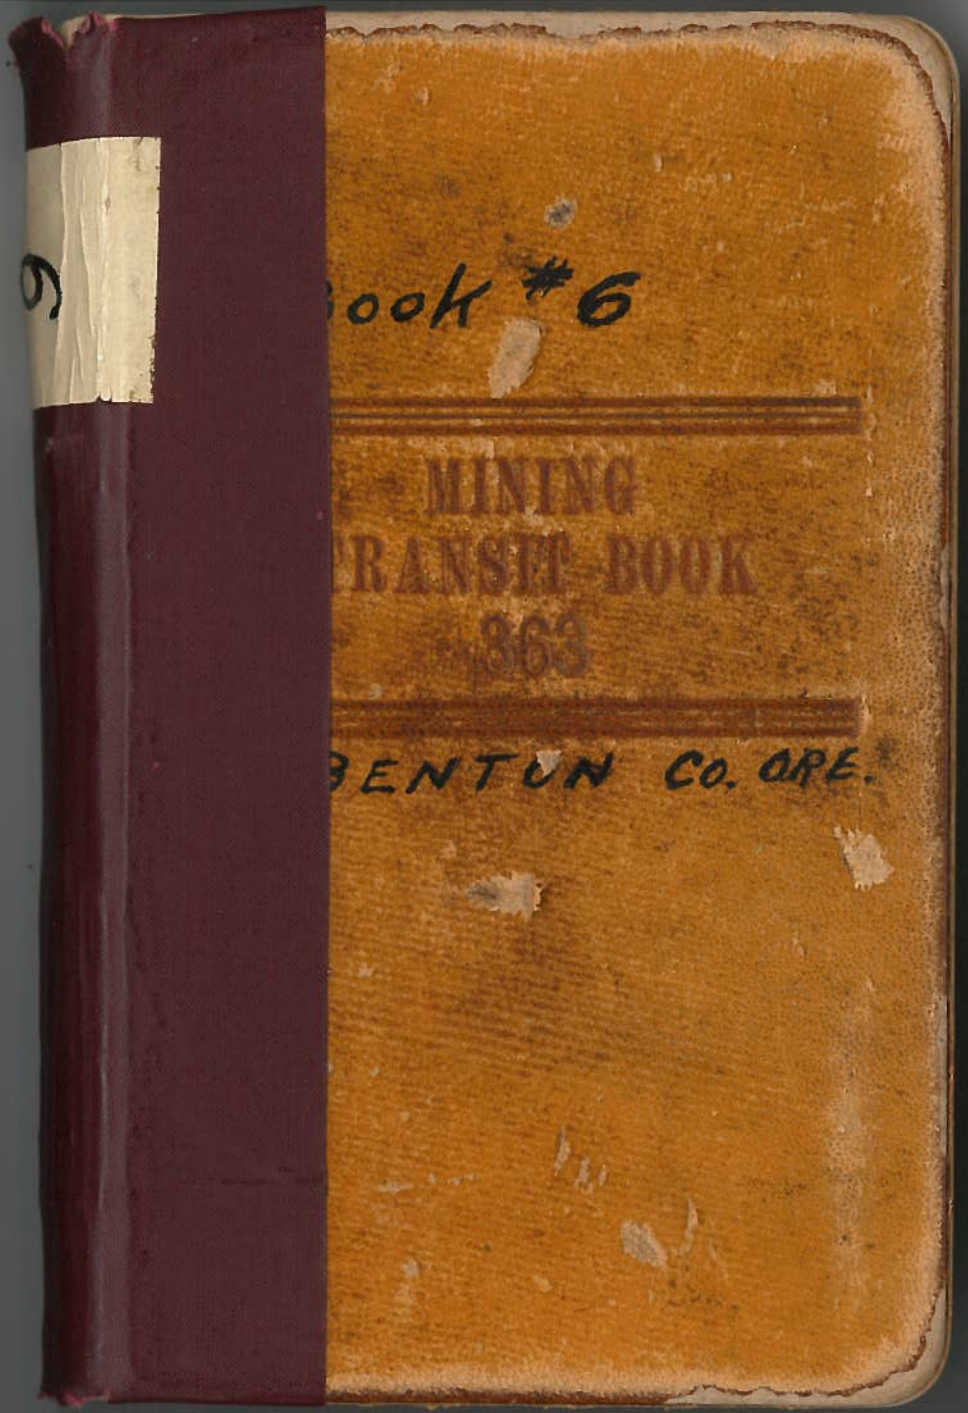
Book #6
MINING
363
BENTON CO. ORE.

46

R1	N 76-13 W		6.417	L.10
R2	N 18°-09' W		5.881	L 30
R3	N 25-41 E	—	3.534	L.44
R4	N 57-14 E	—	3.010	L.70
R5	N 50-51 E	—	6.779	L 20
R6	N 60-15 E	—	3.876	L.75
R7	N 46-18 E	—	3.714	L.40
R8	N 52-36 E	—	3.000	L.36
R9	N 42-42 E	—	4.000	L.38
30	N 38-16 E	—	3.648	L.40
31	N 34-18 E	—	4.458	L.68
32	N 24-43 E	—	7.092	L.35
33	" " "	—	3.253	L.60
W.C.	N 11°-09' E.	—	4.272 +	To W.C.

Set 2.5" x 2.5" x 22 oak stk.

N N 89-40' E. — 4.936

#212

Mc Cready Sawmill Switch

Assum. sta ∆ about 150' from Switch.

∠ Lpl 13°-25' to ∆ 281.6'

∠ " 36°-00' to W 281.6'

Adopted 6°-44' Curve = No. 8 Frog

0 + 25 ∠ ∠ 1-34'

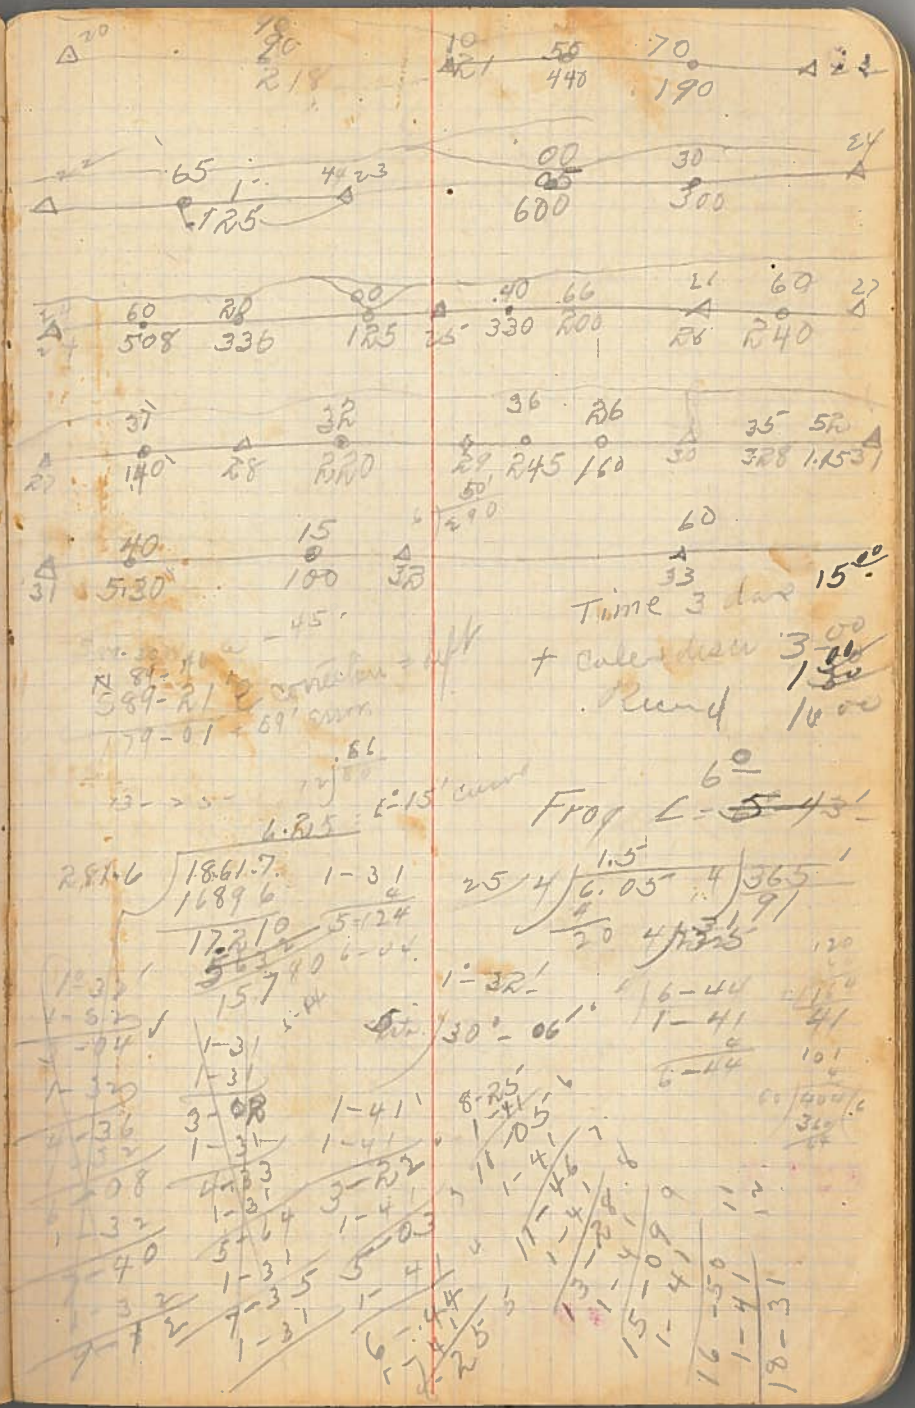

47

Sta.	B.S.	H.I.	F.S.	Surface Elev.	Remarks
0	3.96	103.96		100.	at 00 sta. Level Top Pin
-00			3.4	100.56	
+25			3.8	100.1	
-50			3.9	100.0	
+75			~~4.2~~ 4.2	99.7	
-100			~~4.2~~ 4.2	99.7	
125			~~4.6~~ 4.6	99.3	
50			5.9	98.0	
75			7.5	96.4	
200			11.0	92.9	
225	2.22	95.46	10.52	93.24	Top 2 stakes only
250			8.1	87.3	
275			8.4	87.0	
300			7.6	87.8	
325			9.5	94.4	
50			7.6	96.3	
75			7.7	96.2	
400			7.2	96.7	
25			8.1	95.8	
50			6.5	97.4	
475			5.0	98.9	
500			3.9	100.00	
			3.9	100.00	

Continued from Pg 72 Bk 4

#213

Owl R Survey #62 Wm Ore 5,

Beg at Oak 1 Inch Wood Stake

West.

#213

P 1

Point Sat -.061

89-14

3-00 8.000

3-20 8.100

+.456

-.061

Time M. Cready.

16.71
.091
16.620

at 6 1/2 hrs.

Bird 5 hrs at .25

Length of Line 45.714 Width Woodstake.

395
7.989
7.989
16.370
.061
16.431
16.37
.15

16.520
16.431
.089
.061
.150