Plat of Survey No. 88. #1216 Claim No. 38

Section 23 & 26 Township 11 Range 7

Scale: ..... Chains to the Inch.

Field Notes recorded at page , Vol. , Record of Surveys.

Field Book 6 – f 55

MADE FOR E. A. & Davis

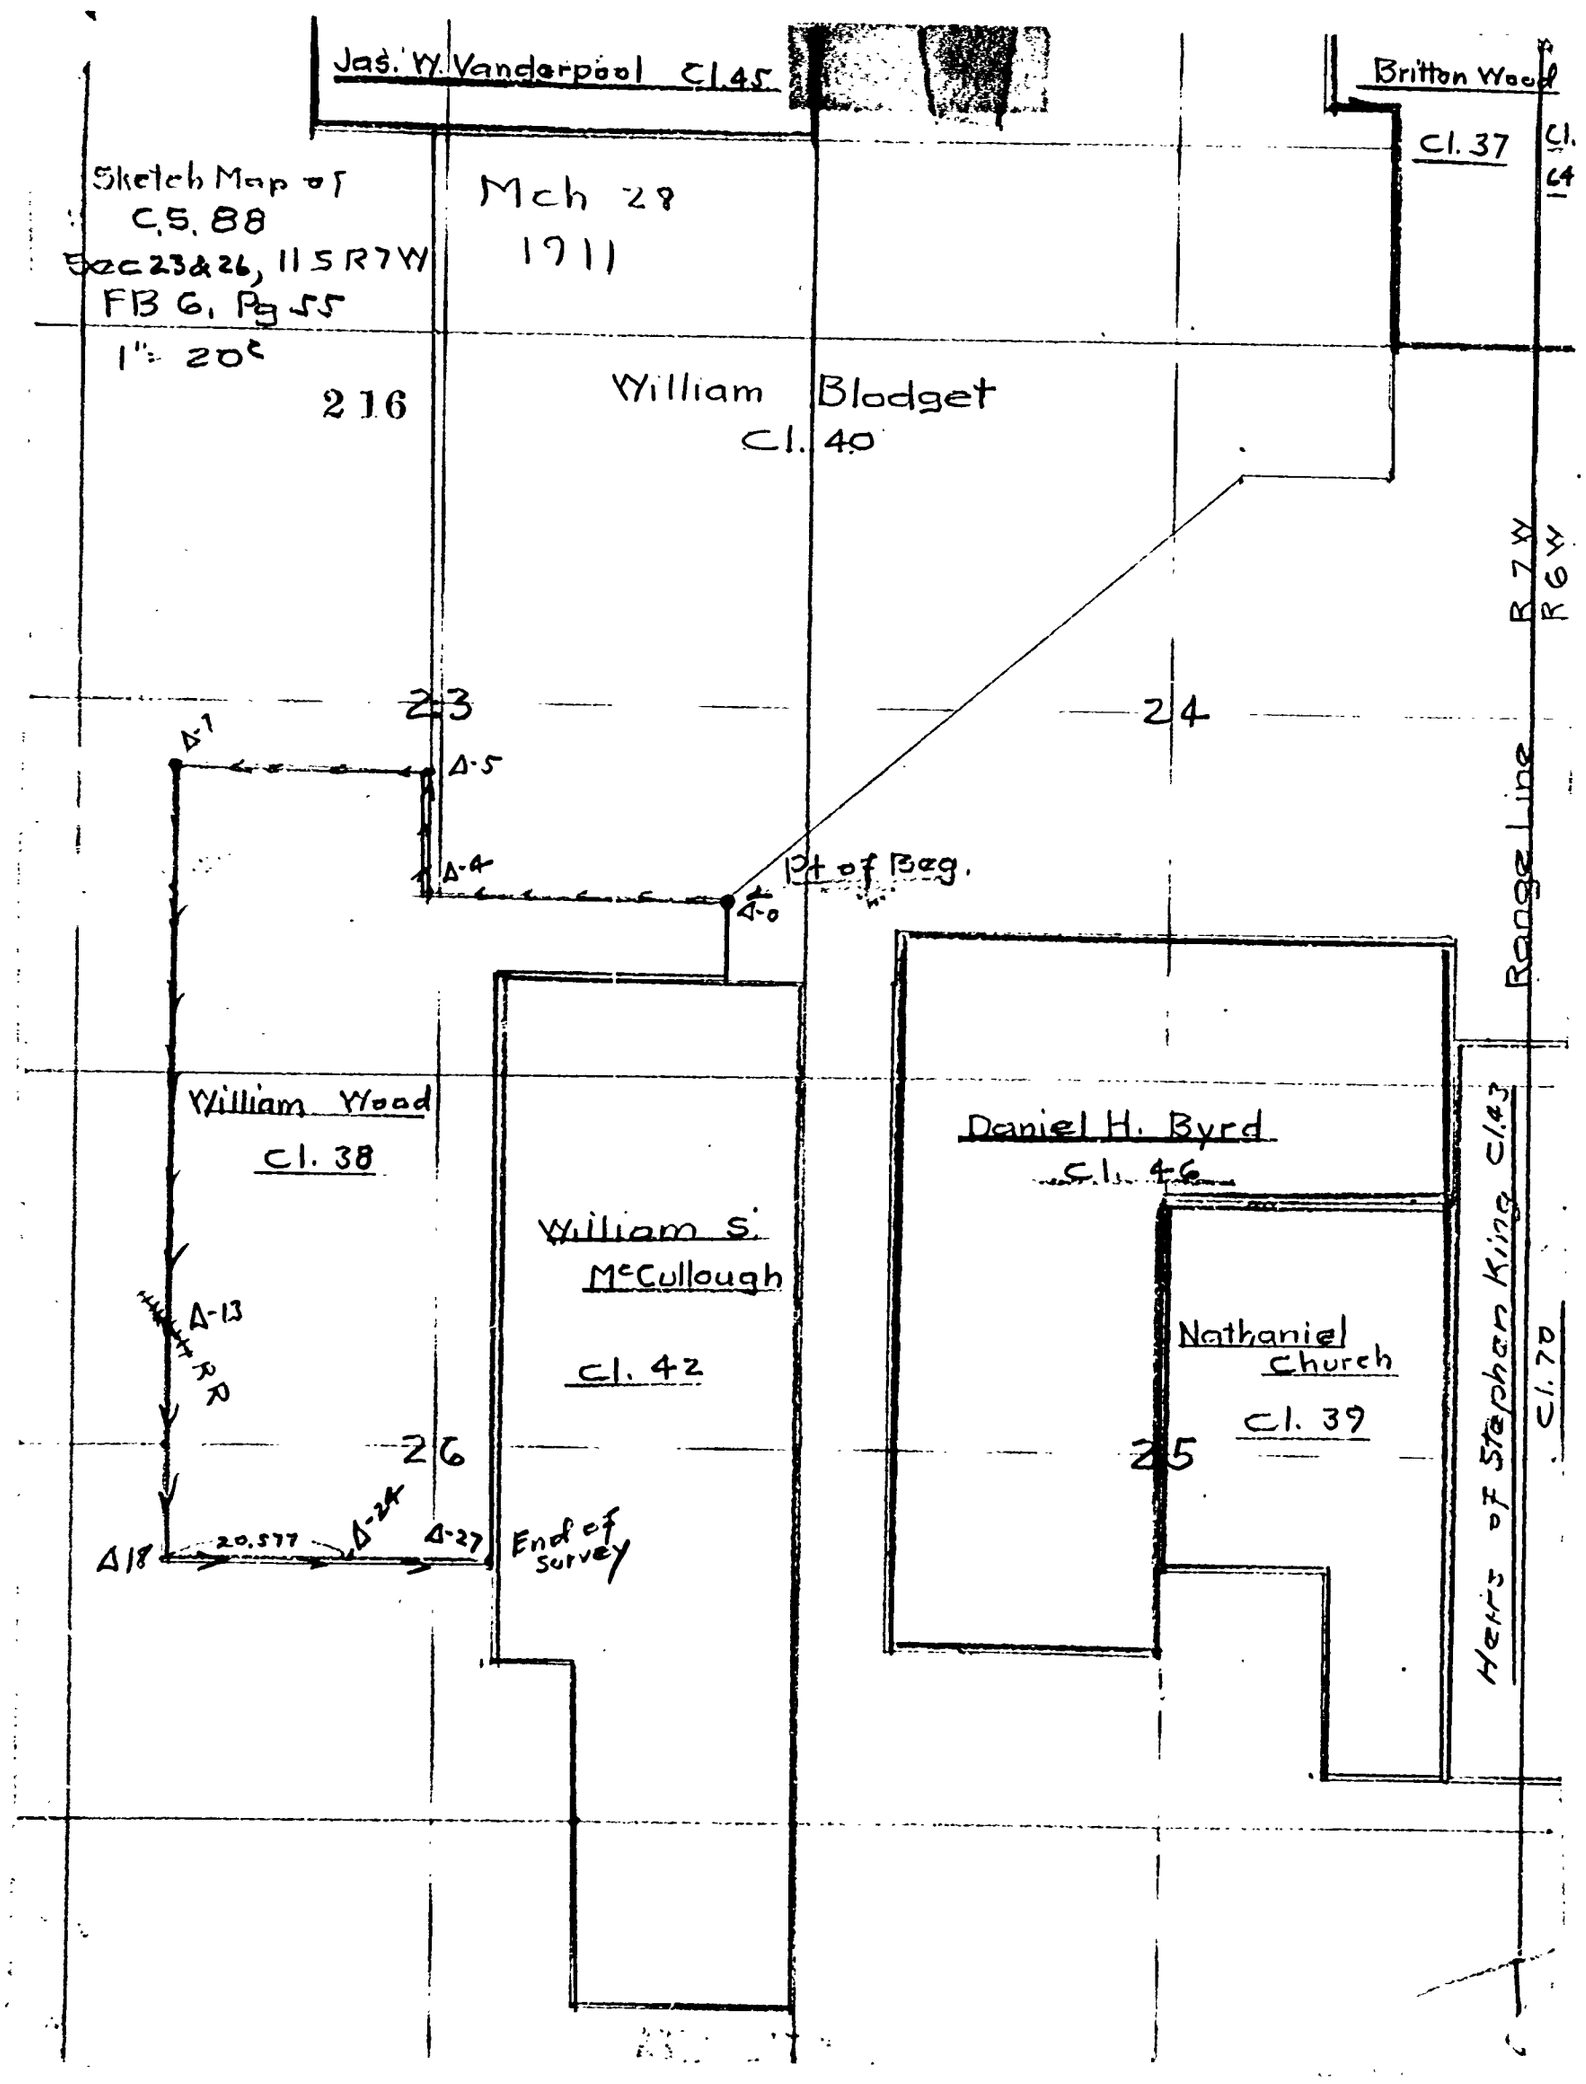

55 #216 Sur N° 88 for E. L. Davis

Beg at NE Cor. Wm Wood C/.38 NW

Reestab. 3/4" by 24" in orig. fence. one bur. tree

fir 9" N 54-30 E .543

" 10" S 53-15 E .354

Pine West 1 L or P 3°-35' R-20 2.738 Offset .171

4-45 8.000

1.191

-1-20 7.739

-5-45 8.000

-2-00 3.864

Canal Rt. -16.5 N-38' E 12.250

Set 3/4" x 24" blk pipe at N-side 253

This pt Comes in fence Corners.

8.000

+2-25 8.000

+4-40 5.700

2.004

Offset .249 N.

Pine 1 L or P 2° 53' -2-35 4.960

Set 3/4 x 24" blk pipe at W. 045 & N. 004

Stake N 57-16' W Slope. 7-50 1.840

N Goble. Randolls house 3.83-3R

Center N Window frame S 42-59 W. -5-50 8.000

Mc Donalds House -45 8.000

8 W.085 1.454

9 line corners Tan .03' f = 00099 14.847

10 .067 .078

11 Angle R- 2°-22' 6.609

12. 2.201

13 Cen RR Track. 10.684

14 8.506

15 5.980

+11-00 6.740

16 +12-30 4.693

17 +7-40 1.687

18 Near Cor Angle R 5-55 2 4.795

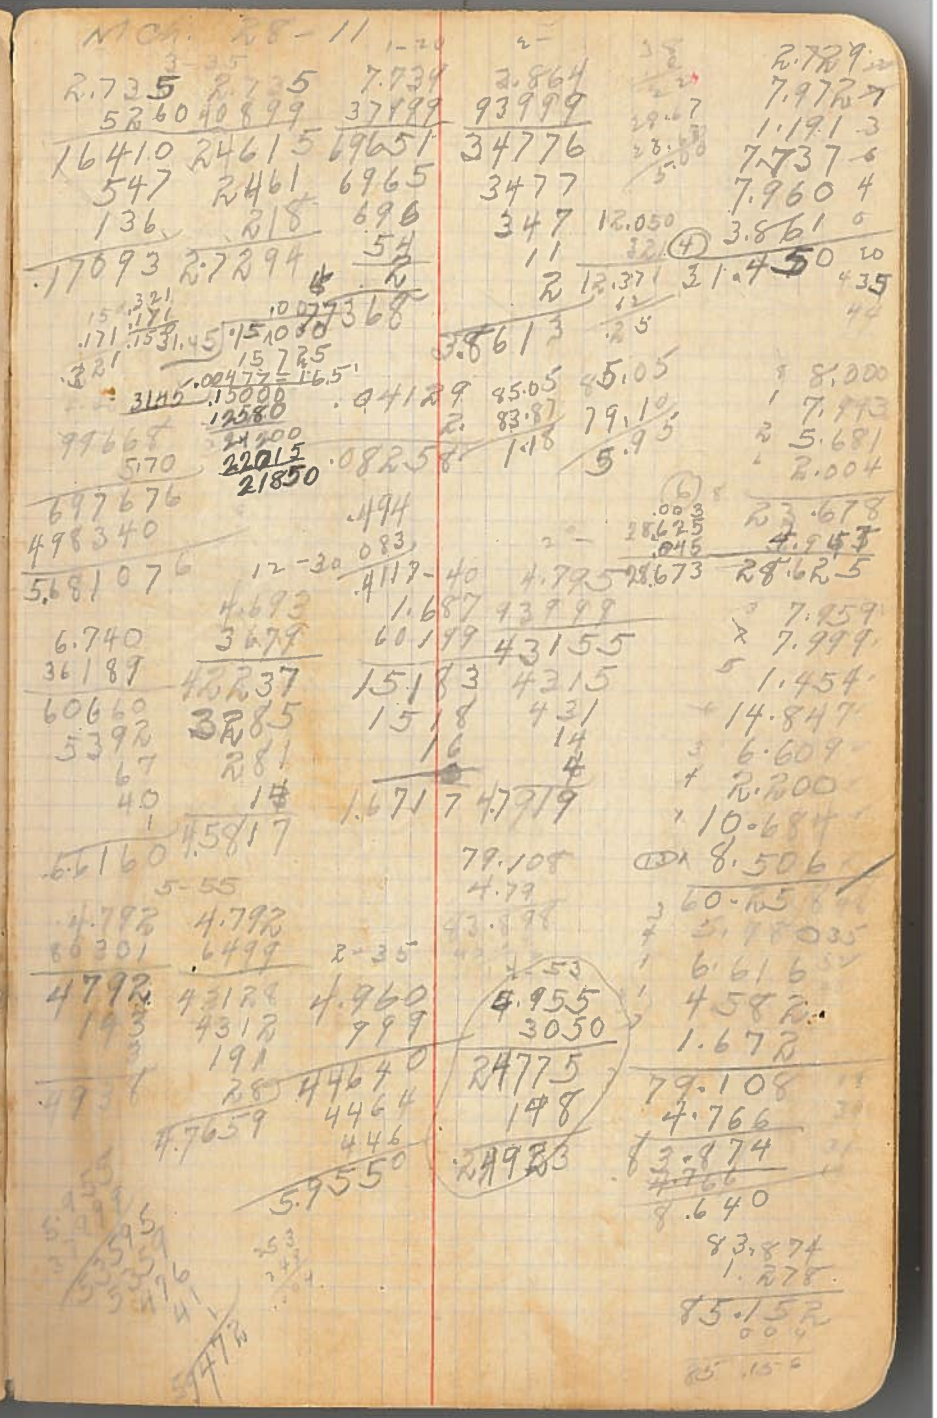

50

| | | | | |
|---|---|---|---|---|
| 19 East terrace N.066 | | | 2.740 | |
| 20 Line terrace Jan. 06 1/2 .00186 | | 4-30 | 1.980 | |
| 21 | | 16-50 | 2.887 | |
| 22 Angle L-16′ | | 11-50 | 3.185 | 37 offset .014 N |
| 23 P-4-54 | | 17-30 | 3.742 | 2° offset .305 S. |
| 24 P-2° 08′ | | 3-20 | 5.901 | offset .219 S. |
| 25 R-2°-57 | | | 5.820 | |
| 26 " " | | 1°-20 | 4.923 | offset .553 S. |
| 27 R-33′ | | 10° | 4.737 | offset .045 S. |
| R-11°-15′ to Cor. | | | .523 | offset .102 S. |
| Reestab Stone 12″×8″×5″ - stamp + two lines. | | | | |
| fir 12″ | S 69° W | | .119 | |
| " 14″ | N 72-30 W | | .165 | |
| Back + Reestab used South tree ok for date | | | | |
| Stone 16″×7″×7″ | | | | |
| oak 7″ | N 73-30 E | | .320 | |
| fir 6″ | N 87-45 W | | .547 | offset .541 W. |
| Angle R-22°-57 | | 2-40 | 1.389 | To S.W. |

Stone 10″×6″×5″ Orig Lot Cor

Direct on Sun at 4. Comtd L-16′ 11″ hrs.

| | | | |
|---|---|---|---|
| 79-28 | | 16-11 | 7-31 |
| 79-17 | | 16-22 | |
| 79-38 | | 16-02 | 7-33 |
| 79-24 | | 16-14 | |

Twice Paid