C.S. # 218

Hardcopy 14-5 # 20

also see notes in file

F. B. 7-54

CHAINS

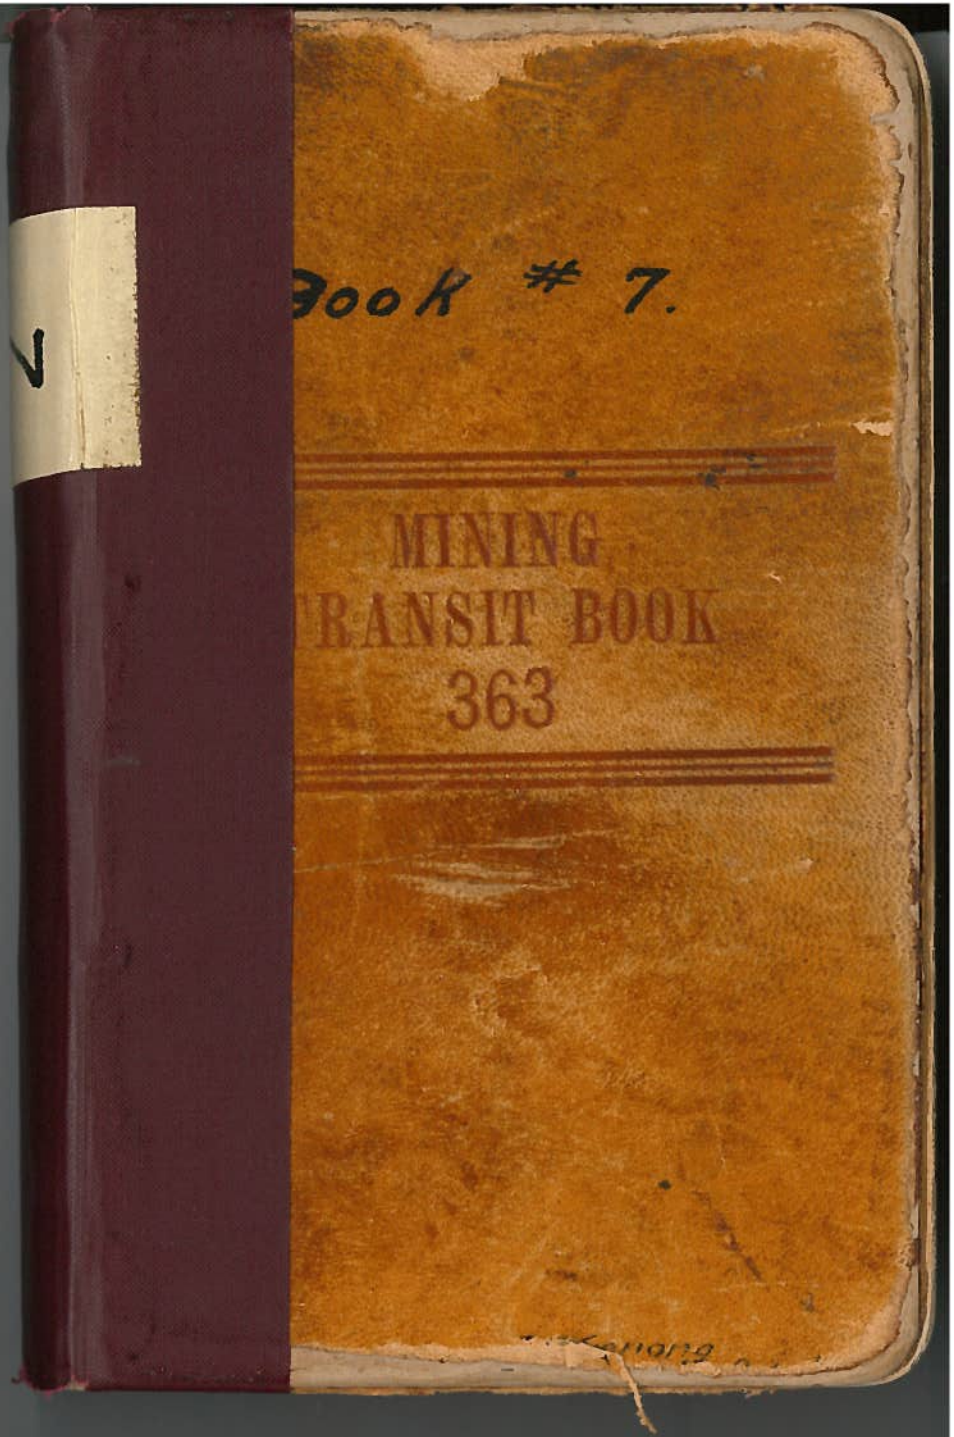
Book # 7.
MINING
TRANSIT BOOK
363

54 Bennett Wilhelm #218

Beg 9.80 N and 55.29 E of NE. cor. Cl. 67			-14-5
Thence	West	S 86-55 W	5.234
	North	N 3° 05' W	2.094
	East	N 86-55 E	5.020
	S 5°55'E	S 8°55'E	2.106

#219 J. F. Moore et al C.S. #95. T 11-5

Beg. at the S.W. cor Cl. 65 .0245 .050W

running East

		2.454
1	L = 25.228 N.133 tan .00527 Corrects S 18'	6.915
		3.560
2		7.000
		4.025
		1.341
3		+.003
Striking Molkeys S.W. + S.E.		N.109
4		6.990
	L = 25.159 N.044 tan .00174 Corrects S 06'	5.134
5		6.644
		6.380
4+		-2.511
Striking N.E. cor J.H. Molkey		.102 N.
Striking S.E. cor H.D. Molkey		+.011 .153 N.
Thence North		4.434
6		6.989
7		6.978
8		6.999
		1.349

25.278 | .00431 | .109000 | 101112 | 78880 | 75894 | 30460 | 25278 | .00174 | .044000 | 25159 | 18871 | 17613 | 12258 | 10063

25.228 | .00527 | .133000 | 126140 | 68600 | 50456 | 18144 | 17659

.303 | .153 | .150

2.454 6.915 3.560 7.000 4.025 1.341 .003 = 25.298

6.990 5.134 6.644 6.380 .011 = 25.159

25.228 = 50.384 = 50.384

.153 4.434 6.989 6.978 6.999 1.349 = 26.902

.109 N. .102 .007

22.634 | .00031 = 1' | .00700000 | 67902 | 20980