C.S. # 225

Hardcopy 10-7 #8

also see notes in file

F. B. 7-64

Book # 7.

MINING
TRANSIT BOOK
363

64 #225 E.L. Pattan April 15th 1911

Beginning at the center of sec. 21 T. 10 S. R 7 W.

| | | | | |
|---|---|---|---|---|
| and running thence North | | | 3.655 | |
| 1 | | | 8.000 | |
| | | 12°-30' | 5.376 | |
| 2+ | L = 40.421 | | 3.004 | |
| | corrects W 03' | +2 — | 6.998 | |
| 3 | | -1-20 | 7.829 | |
| 4 | | +4-30 | 6.132 | |
| 5 | | | 2.118 | |
| 6 | | | .320 | |
| Thence | N 89°25 W | L R 1°02' | +12°-20' | 3.606 | .063 N |
| 7 | | | +14-30 | 4.968 | |
| 8 | | L R 37' | +30-30 | 1.014 | .009 N |
| 9 | | L L 20' | +21-40 | 4.628 | .025 S |
| 10 | | | +18-40 | 1.820 | |
| 11 | | | +6-50 | 2.313 | |
| 12 | | | -3 — | 2.457 | |
| 13 | | | -9-30 | 2.565 | |
| 14 | | L L 37' | -15-30 | 3.015 | .032 S |
| 15 | | | -20 — | 3.807 | |
| 16 | | | -2-40 | 1.878 | |
| 17 | | L R 24' | — | 5.177 | .036 N |
| | S 79°54 W | | — | 3.640 | .638 S |
| Back to 6 | N 89°25 E | | -2-30 | 1.221 | |
| 18 | | | -13-30 | 3.373 | |
| 19 | | L L 14' | | 4.509 | .018 N |

-80 links center Mary's River-

C.S. #45 (continued) From 3-71

N.W, tree .454
S.W " .181

122° 15'

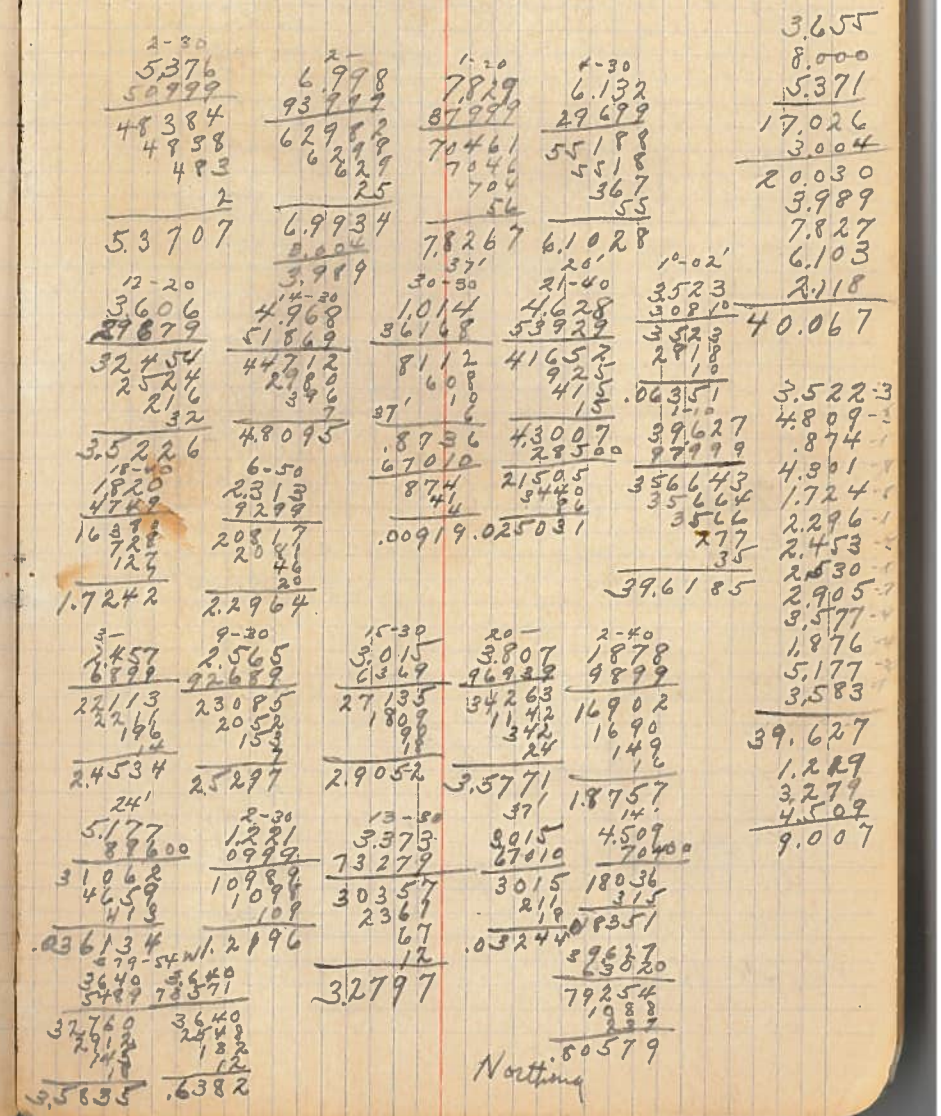

| | | | | | |
|---|---|---|---|---|---|
| 20 | | LL 6°47' | +20-50 | 1.2941 ✓ | .142 N |
| 21 | | | +3-30 | 1.035 ✓ | |
| 22 | | | +15-40 | 3.887 ✓ | |
| 23 | | | +13-20 | 2.496 ✓ | |
| 24 | | | +3-30 | 1.414 ✓ | |
| | | | +29-40 | .808 ✓ | |
| 25 | | LR 58' | +27-30 | 3.637 ✓ | .054 S |
| 26 | | | +7-30 | .875 ✓ | |
| 27 | | | -24-30 | 2.914 ✓ | |
| 28 | Course S 89 47 E<br>Correct S 22' | | -4-20 | 3.614 ✓ | |
| | | | +30— | 1.861 ✓ | |
| 29 | | | +21-30 | 1.078 ✓ | |
| 30 | | | +3-40 | 1.480 ✓ | |
| 31 | | | — | 5.854 ✓ | |
| | | | | -360 | |
| | Striking Cor | 15+16-21+22 | | N. 180 | |
| | Set Fir Stake | 3X3X36 | From which | | |
| | A Fir 20" | S 14¼° W | -28-30 | 1.090 | |
| | Fir 18" | S 78½° W | -16°— | 2.760 | |
| | Fir 20 | N 13½° W | +15— | 2.530 | |
| | Set ¼ cor. | 4x4x36 Cedar Stake 16+21 at Sta. 6 | | +.034<br>W.036 | |
| | Fir 18" | N 64¾° E | | 1.005 | |
| | Fir 30" | S 38° E | -15°— | 1.420 | |
| | Set stake at Sta. 2+ | | | +.180<br>E.018 | |
| | Fir 20" | S 68¼° W | | 1.845 | |
| | Fir 36" | N 29° W | | 2.265 | |

A. L. Patton
Alva Davis
Arthur Skaggs