C.S. # 228

Hardcopy 12-5 #38

F.B. 7-68

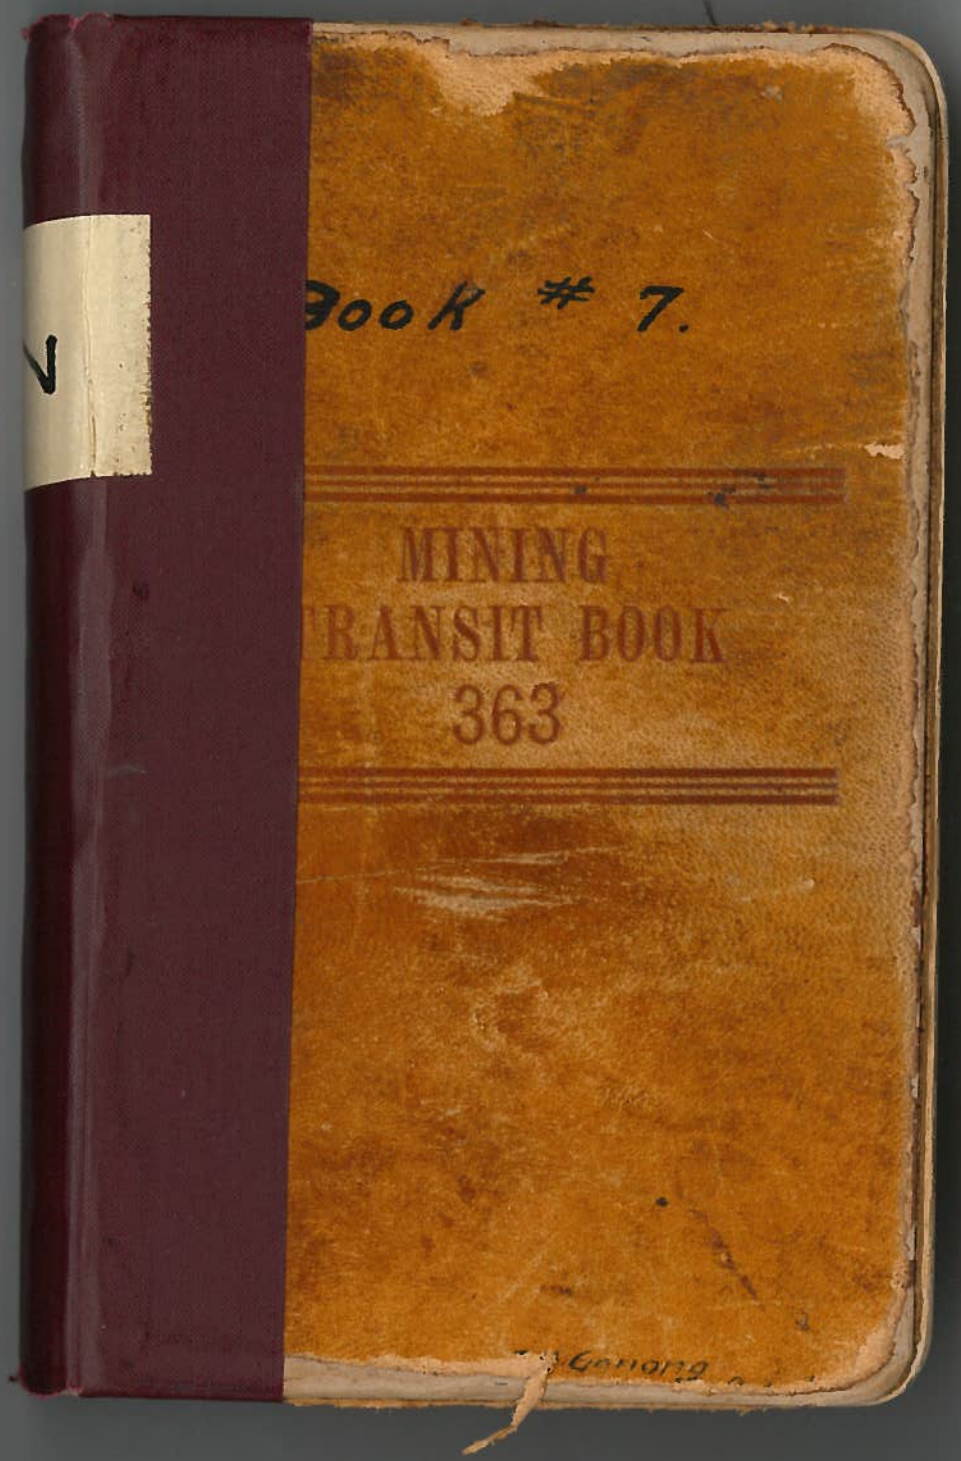
Book # 7.
MINING
TRANSIT BOOK
363

68 O.L. Davis C.S. 97 April 21st 1911

Recst.	N.W. cor. Hiram Allen		Cl. S.E. Tree stdg	
Oak 14"	N49¾°E		.774	
thence	West	#228	3.300	
thence	South		6.367	
1			8.000	
			5.343	
			-.006	
Striking	Stone marked "W"		W.081	
thence	South	∠L 1°55'	3.772	.126 E
2		∠L 25'	8.000	.098 E
			5.502	
thence	East		3.151	
Striking	S.K. Brown's N.E. cor. Cl. 54		N.188	Original
thence	South		4.104	
		-6-20	2.153	
			4.410	
	Corrects E 33'	Set 1" pipe	E.101	
3			8.000	
			1.160	
4		∠R 10'	4.192	.012 W
5			4.699	
6		∠R 3°01'	1.153	.061 W
7			5.599	
			+.105	
Striking	S.K. Brown's Int. cor.		W.417	
Set	Stake from which			
Oak 10"	N55½°E		.336	
" 16"	N62½°W		.444	

1-55

3.772 × .5430 = 11316 + 11310 + 1510 + 15 = .12615

3.772 × .44999 = 33948 + 33948 + 339 + 15 = 3.7696

25'

13.502 × .72700 = 945514 + 27004 + 945 = .098159

6-20

2.153 × .9999 = 19377 + 19377 + 64 + 18 = 2.1396

4.192 × .17200 = 8384 + 3772 + 42 = .012198

3°01'

1.153 × .36250 = 5765 + 230 + 69 + 3 = .060067

012

073

.00972

35.372 × .34400 = 313348 + 254520 + 24704 + 8916 = .101619

4.104 + 2.139 + 4.410 = 10.653 − .188 = 10.465 + 279.. = 94185 + 7235 + 209 = .101619

6.367 + 8.000 + 5.343 = 19.710 + .006 = 19.694

3.769 + 13.500 = 17.269

4.104 + 2.139 + 4.410 + 13.502 + 3.769 + 5.343 + 14.367 = 47.634

3.916 + 2.139 + 4.410 + 9.160 + 4.192 + 4.699 + 1.152 = 29.668 + 5.599 + .105 = 35.372

Thence	East		8.000	
			7.901	
8			7.000	
			7.000	
			5.845	
9		LL 1°35'	.874	.024 N
10			3.909	

Morgan + Johnson (continued) C.S. 96.

From pg 62
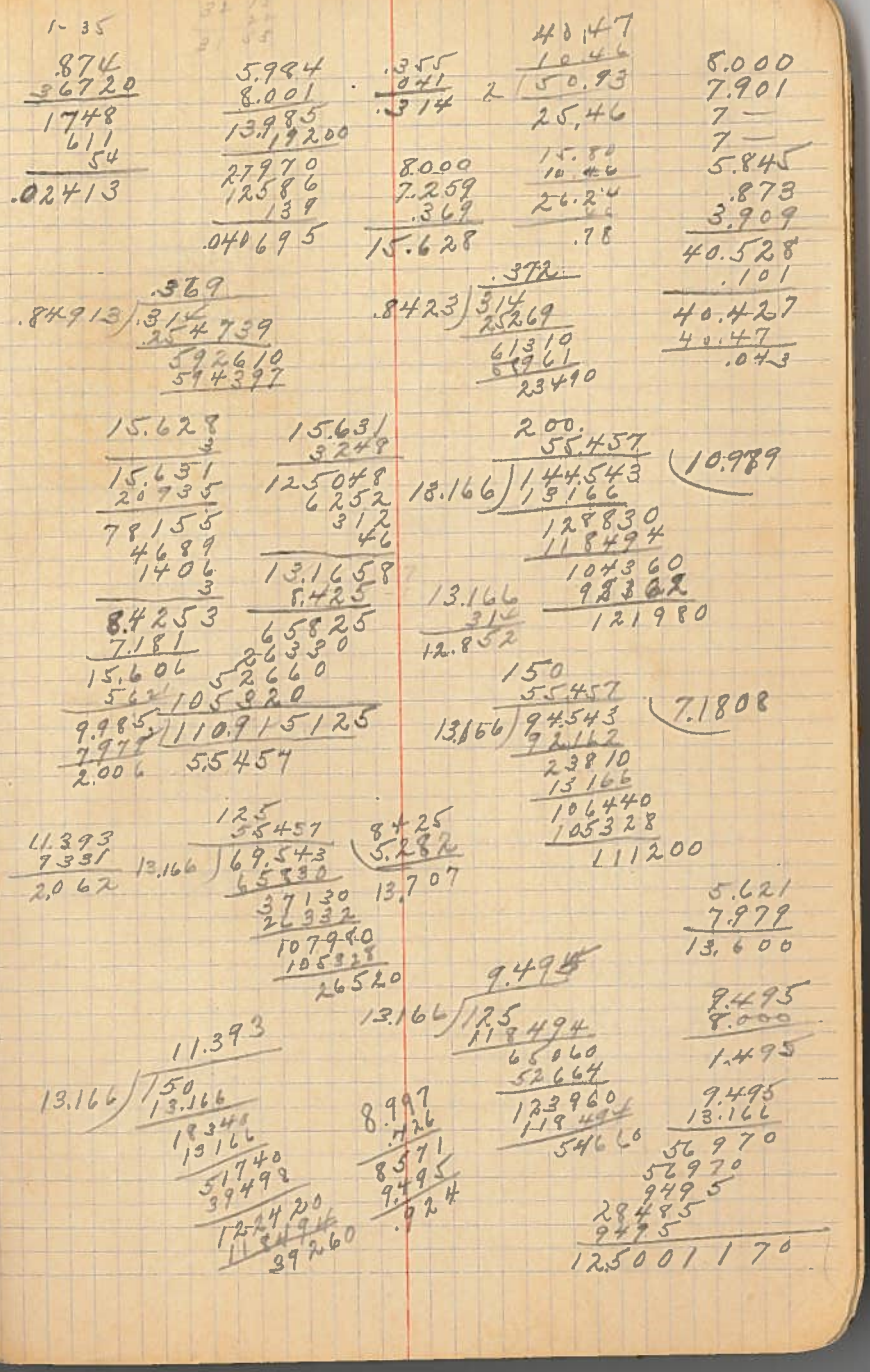
9+		1.014	℄ of Road
58	S 89°38' W at #9 –	4.019	
59		8.000	
		.997	
	N 32°15' E	8.000	along Road
		7.259	
	Set pipe at 9+ on Line	.372	S.W.
	From which a		
Tel. pole	N 61½° E	.630	
Light pole	N 14½° E	.980	
	Set ¾" pipe from which		
Light pole bears	S 47¾ W	1.178	
Light pole	N 7½° W	.516	
Thence	N 29°34' E	3.927	
	S 89°38' W	5.621	
		7.979	
60			
Set	pipe at 60+	.167	
61		8.000	
		1.331