C.S. # 231

Hardcopy 13-7 # 3

also see notes in file

F. B. 8-67

MINING
BANSIT BOOK
1898

ok #8

8

#231

67 Survey # 108 For J. A. Walker

Beg. S.E. cor. of Allen Hayden

D.L. 37. Tp. 13 S. R. 7 W.

Boulder 3"x4"x12"

Maple 20" N. 3° E. .93 chs. Fir Stump

" 20" N. 59° W. 1.1437 " Maple Stump

N. 1° 8' W.

Correction E 1° 8' (N. 24° E. Correction E. 1°)

N.E. Cor. Sec. 12 Boulder 5"x5"x10" Offset .178 E.

1	∠ Right 2°6'	5°20'	4.878	
2		1°50'	4.852	
3	∠ Right 1°22'	1°30'	7.864	Offset .187
4			2.773	
5			5.972	
6		2°	7.271	= 32.073
			-1.300	
	Casting.		E.294	
	Fir 10" S. 3°10' W. .584 chs. out.			
7		-2°50'	5.501	
8		+1°50'	8.000	
9	∠ Left 1°44'	+15°34'	4.580	Offset .133
10		+9°30'	4.782	
11		+2°50'	.688	
12		+3°30'	3.396	
13		-3°30'	3.826	
To N.E. cor. C/37	∠ R. 20°41'	+12°40'	1.098	Offset 1.037
	Setting W. of cor.		1.037	

Set Stone 10"x10"x14"

Fir 50" N. 15° W. .21 chs. Stk.

Maple 24" S. 35°30' W. .660 "

Apr. 27 1911. 8h 10.3m + 14.4 = 8h 55.9m

∠ W. 1°35'

24

.31 55.9

.23 5.04

8 50.86

1°35' .38

1°11' -

24' correction E. 1.37

4.853

.162

4.691

33.378

5.499

7.994

4.410

51.273

4.714

.687

3.329

3.819

.265

2 64.197

32.073

4.949

7.857

2.573

15.281

.08999

13752

13752

1375

122

15.277

68

	Back to ⊙ 0			
14	N. 87° 54' W.	4° 30'	4.341	
	Correction 2° 31' S			
15	(S 89° 35 W.)	1° 30'	5.503	
16			1.022	
17		3° 45'	3.199	
18			3.315	
19	Notes in total	8° 50'	1.020	
20	∠ Left 6'		3.546	
21	∠ Left 8°		4.867	
N.E. Cor. 38	∠ Left 8° 12'		4.466	= 30.127

Re set.

Maple 30" S. 31° 5' W. 1.593 chs. 8"X10"X12" boulder
Fir 48" S. 83° 45' W. 1.464 "
∠ Left 2° 40'

45'	8.000	Found Sts. 21
45'	8.000	
2° 50'	7.528	
22		

Back to △ 19 +.558 = 19.772
S. 80¢

W.C. cor. S. 34° 20' W. .978 chs.
Set boulder 5"X7"X19" 1.020 E of cor.
Maple 16" N. 56° 20' E. .652 chs
Fir 5" N. 89° 5' E. .382 "

23 N. 34° 20' E. 3.751 = 4.724

Cross R.
19 W
110' to river
18,216
E. 90
.006 offset
.677 offset
.637 offset
boulder
8"X10"X12"

24	N. 36° 47' E.	3.662	
25	N. 41° 12' E.	3.267	
26	N. 8° 41' E.	4.421	
27	N. 9° 28' E.	3.095	
28	N. 14° 40' E.	1.923	
29	N. 22° 13' E.	1.909	
30	N. 15° 00' E.	1.715	
31	N. 66° 5' E.	2.704	
32	S. 52° 14' E.	2.724	
33	N. 89° 21' E.	1.330	
N.C. cor.	N. 38° 3' E.	1.092	N.C. cor. 1.092 S. of cor.

Set boulder 6"x8"x15"
Maple 28" S. 24° 55' W. .490 chs.

From △3 S. 68° 48' E. 3.262 to △4
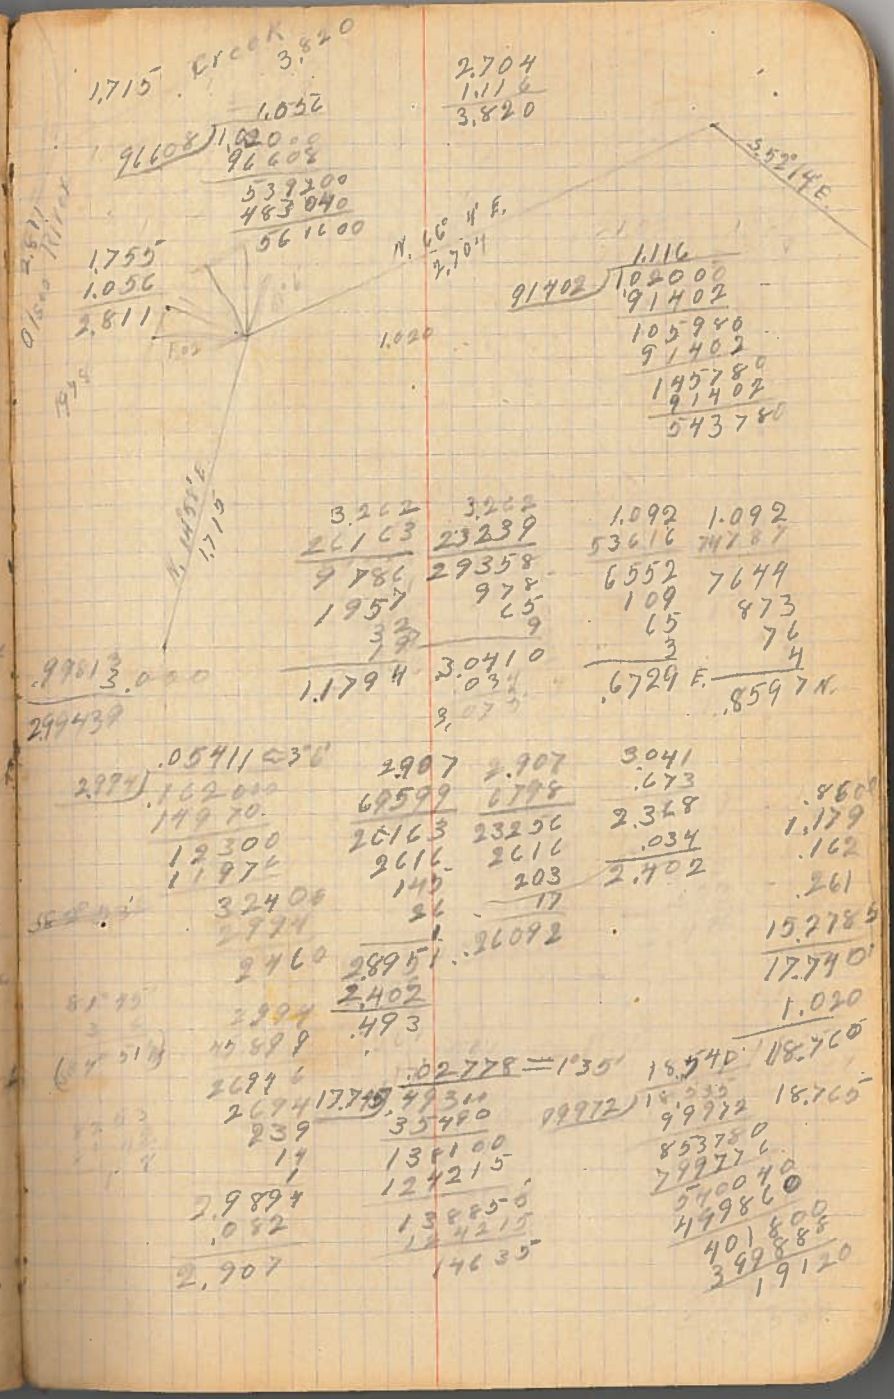
From △1 S. 84° 45 W. 3°30 3.000 = 2.989
correction N. 3°6'
Set boulder 5"x5"x10" 2.907 between corners
Fir 22" N. 86° 10' E. .453 chs.
" 6" S. 60° 15' W. .322 "