C.S. # 244

See notes in file

F.B. 9-7

5 CHAINS

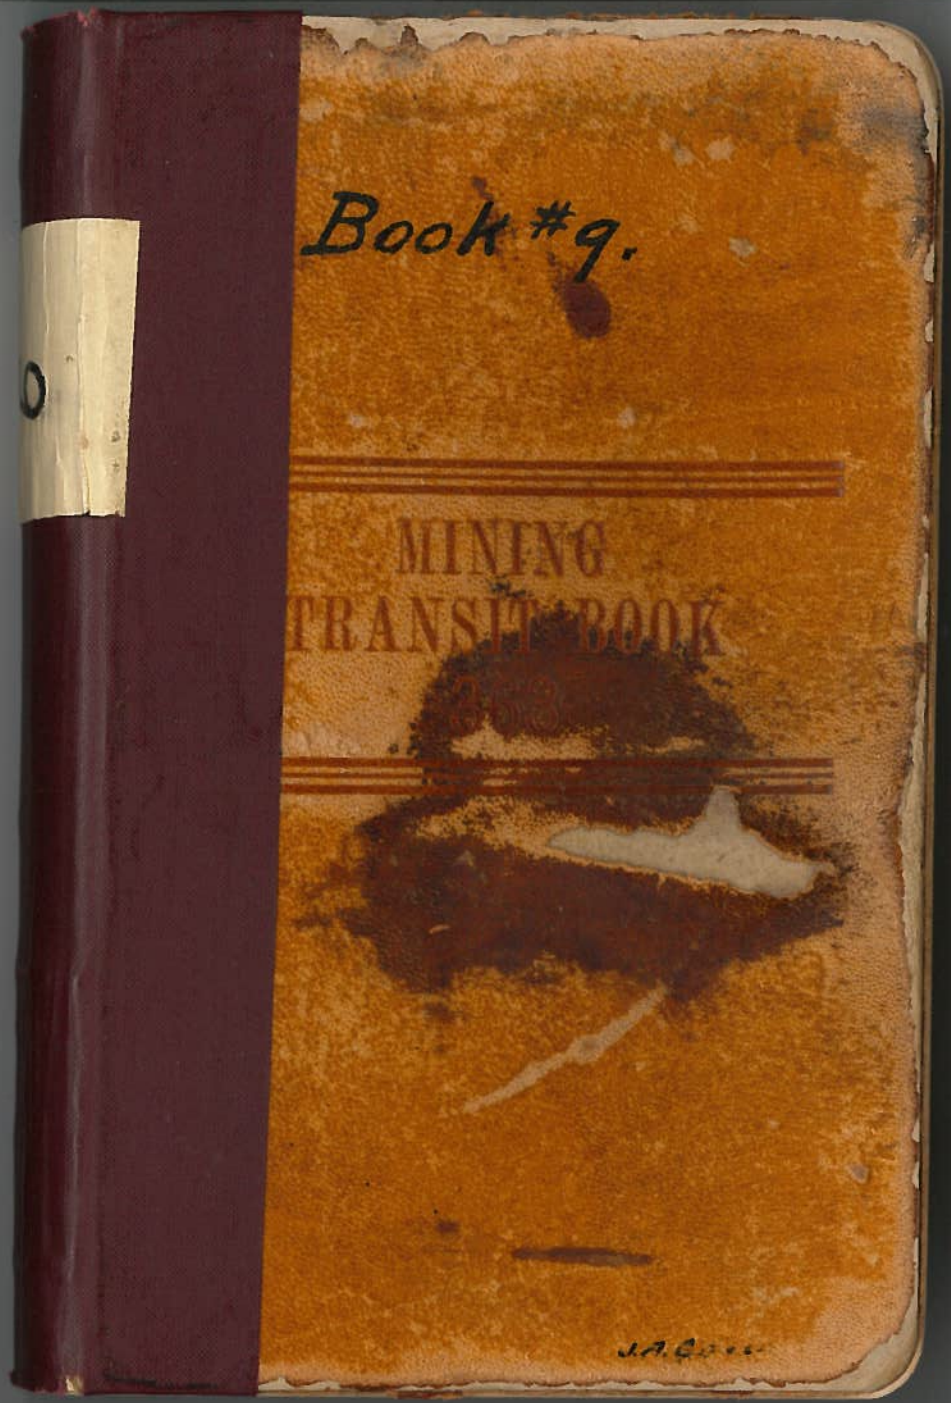
Book #9.
MINING
TRANSIT BOOK

7

1, 2, 11 & 12 - 11 - 5

#243 Beg. at the S.E. cor A. Fuller D.L.C. 38

		S.008 W.053
Thence	N 30' E	8.000
		7.008
Thence	West	1.329
Thence	Southerly	1.011
Thence	East	1.464
Thence	N 30' E	1.000

#244 Geo. Linderman

Beg at the SE cor. A. Fuller D.L.C.

		S.008 W.053
Thence	S. 30' W	.998
Thence	S 89°30' E	.053
		3.358
Thence	N 30' E	4.538
Thence	N 89°30' W	3.305

#245 Carl Sutton

Beg at S.E. cor. school lot { Which is the above Geo Linderman survey

Thence	S 89°30' E	8.000
		3.017
		6.398
Thence	N 30' E	4.114
		.424
Thence	N 89°30' W	6.398
		8.000

36.250) .001460 .053000 36250 167500 145000 225000 217500

3.358 .053 3.305) 4.5385 15000 13220 17800 16525 12750 7915 28350 26440 19100

4.5385) 11.017 50.000 45385 46150 45385 76500 45385 311150 317695

4.538 4.114 .424

6.398 4.538 51184 19194 31990 25592 2.903412477

15005 64100 15000 6000 900 .021900 14000 641 14000 5600 8400 .07044 053 1023

15.1286 3.305) 50.000 3305 16950 16525 45385 11017 317695 45385 45385 50.00065545

9.7 .95) .053 022 .031

20.72 4) 8285

15.1286 3305 18.4336 11.017 3.305 14322 20.72 6.398

42.50 3305 9450 6610 26400 26440 19600 19830

11.017 8.000 3.017