C.S. # 248

Hardcopy City Plat #9

also see notes in file

F. B. 9-12

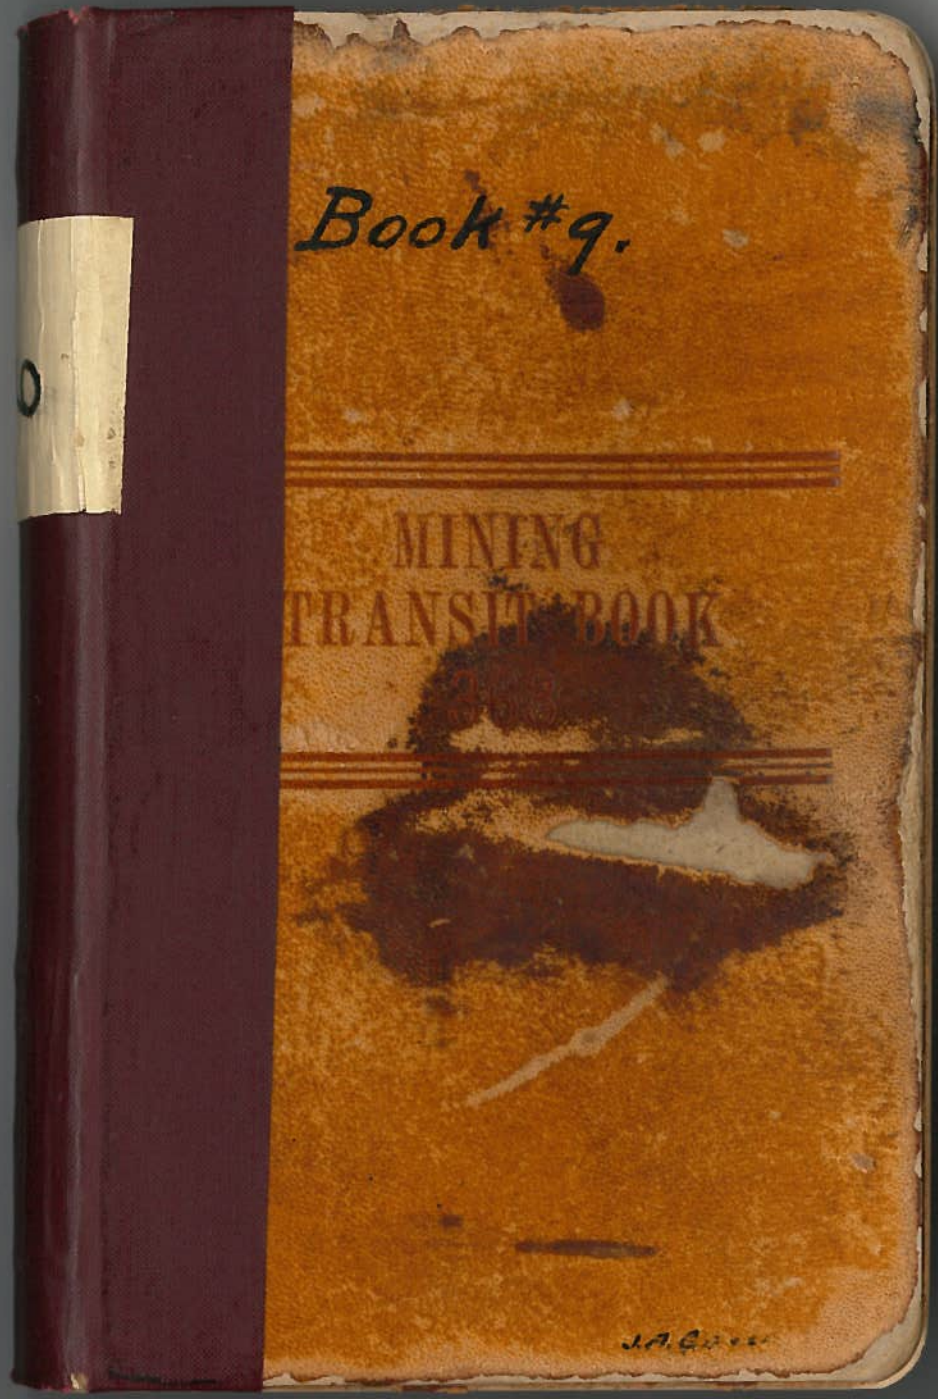
Book #9.
MINING
TRANSIT BOOK

12

Mrs. Jamison

#248

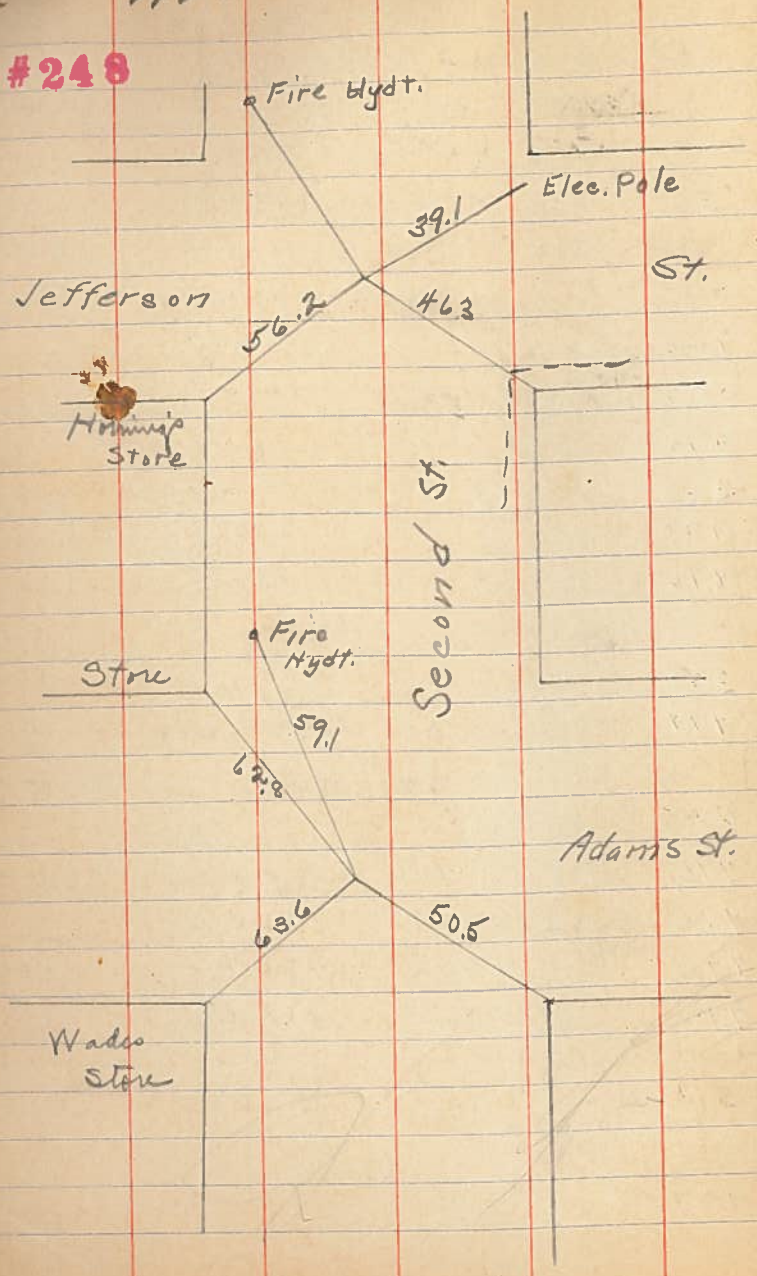

Block # 3 (Manyville)

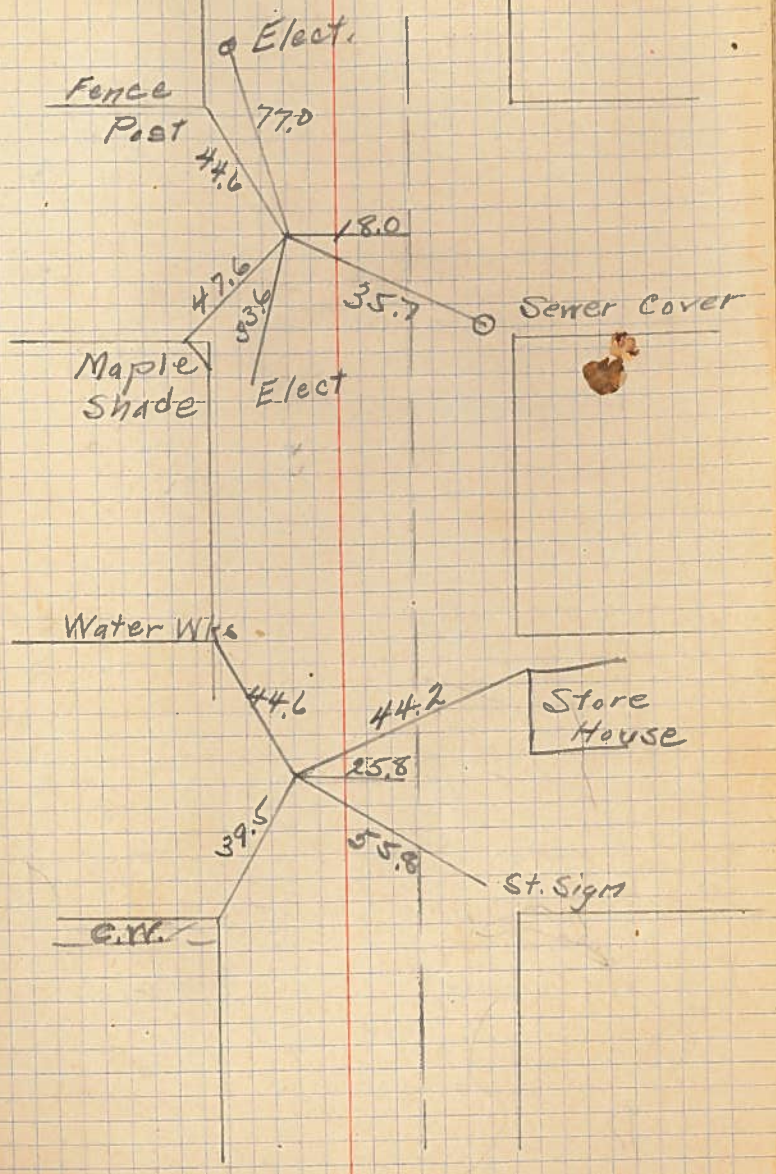

13

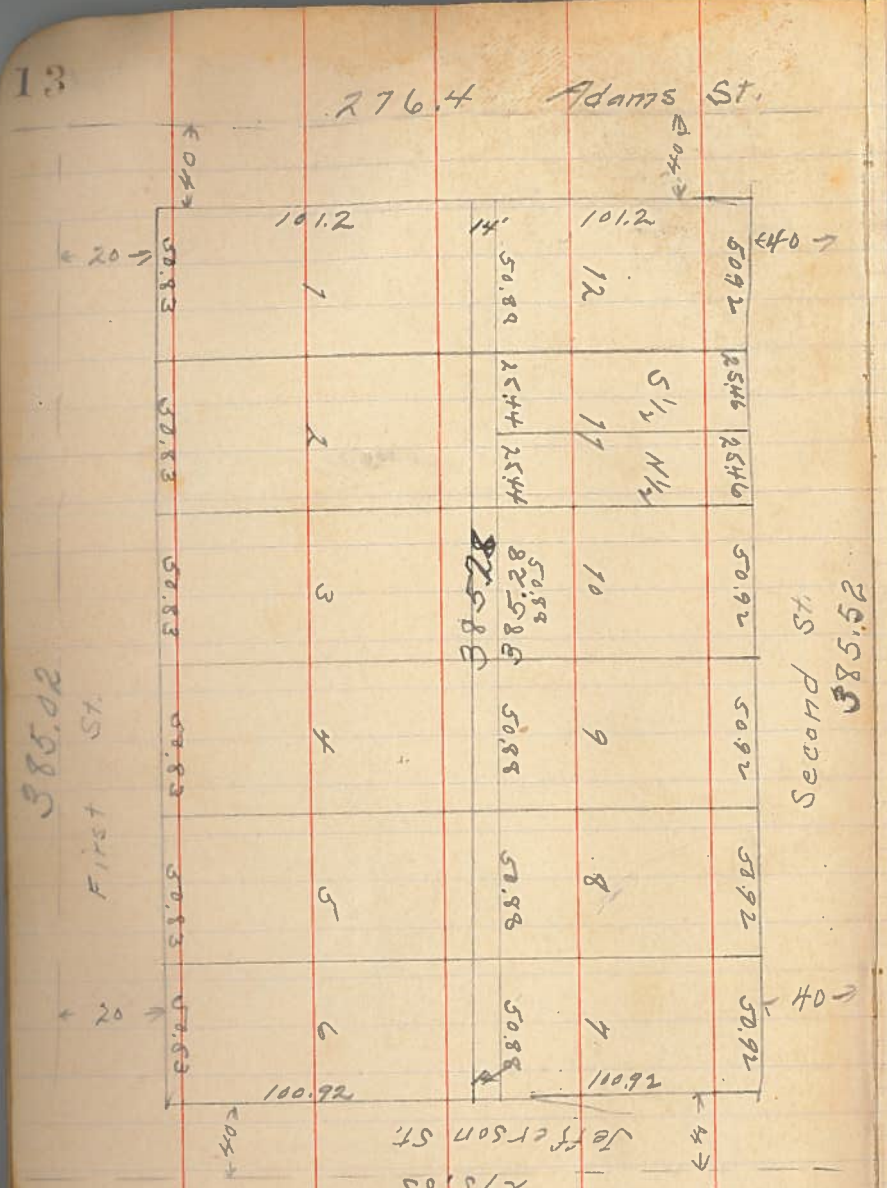

3/4" black pipe 5.69 W of ⊙ alley
from which
N.E. cor. Hathaways concrete bldg. 25.43 Ft.
Tel. pole S.E. 21.3 Ft.