Plat of Survey No. 112 (25) Claim No. 51

Sections 28 + 29 Township 11 S. Range 6 W.

Scale: 10 Chains to the Inch.

Field Notes recorded at page 9, Vol. 10, Record of Surveys.
Book 15 Page 9

MADE FOR J. H. Goldman and W. P. McFarland

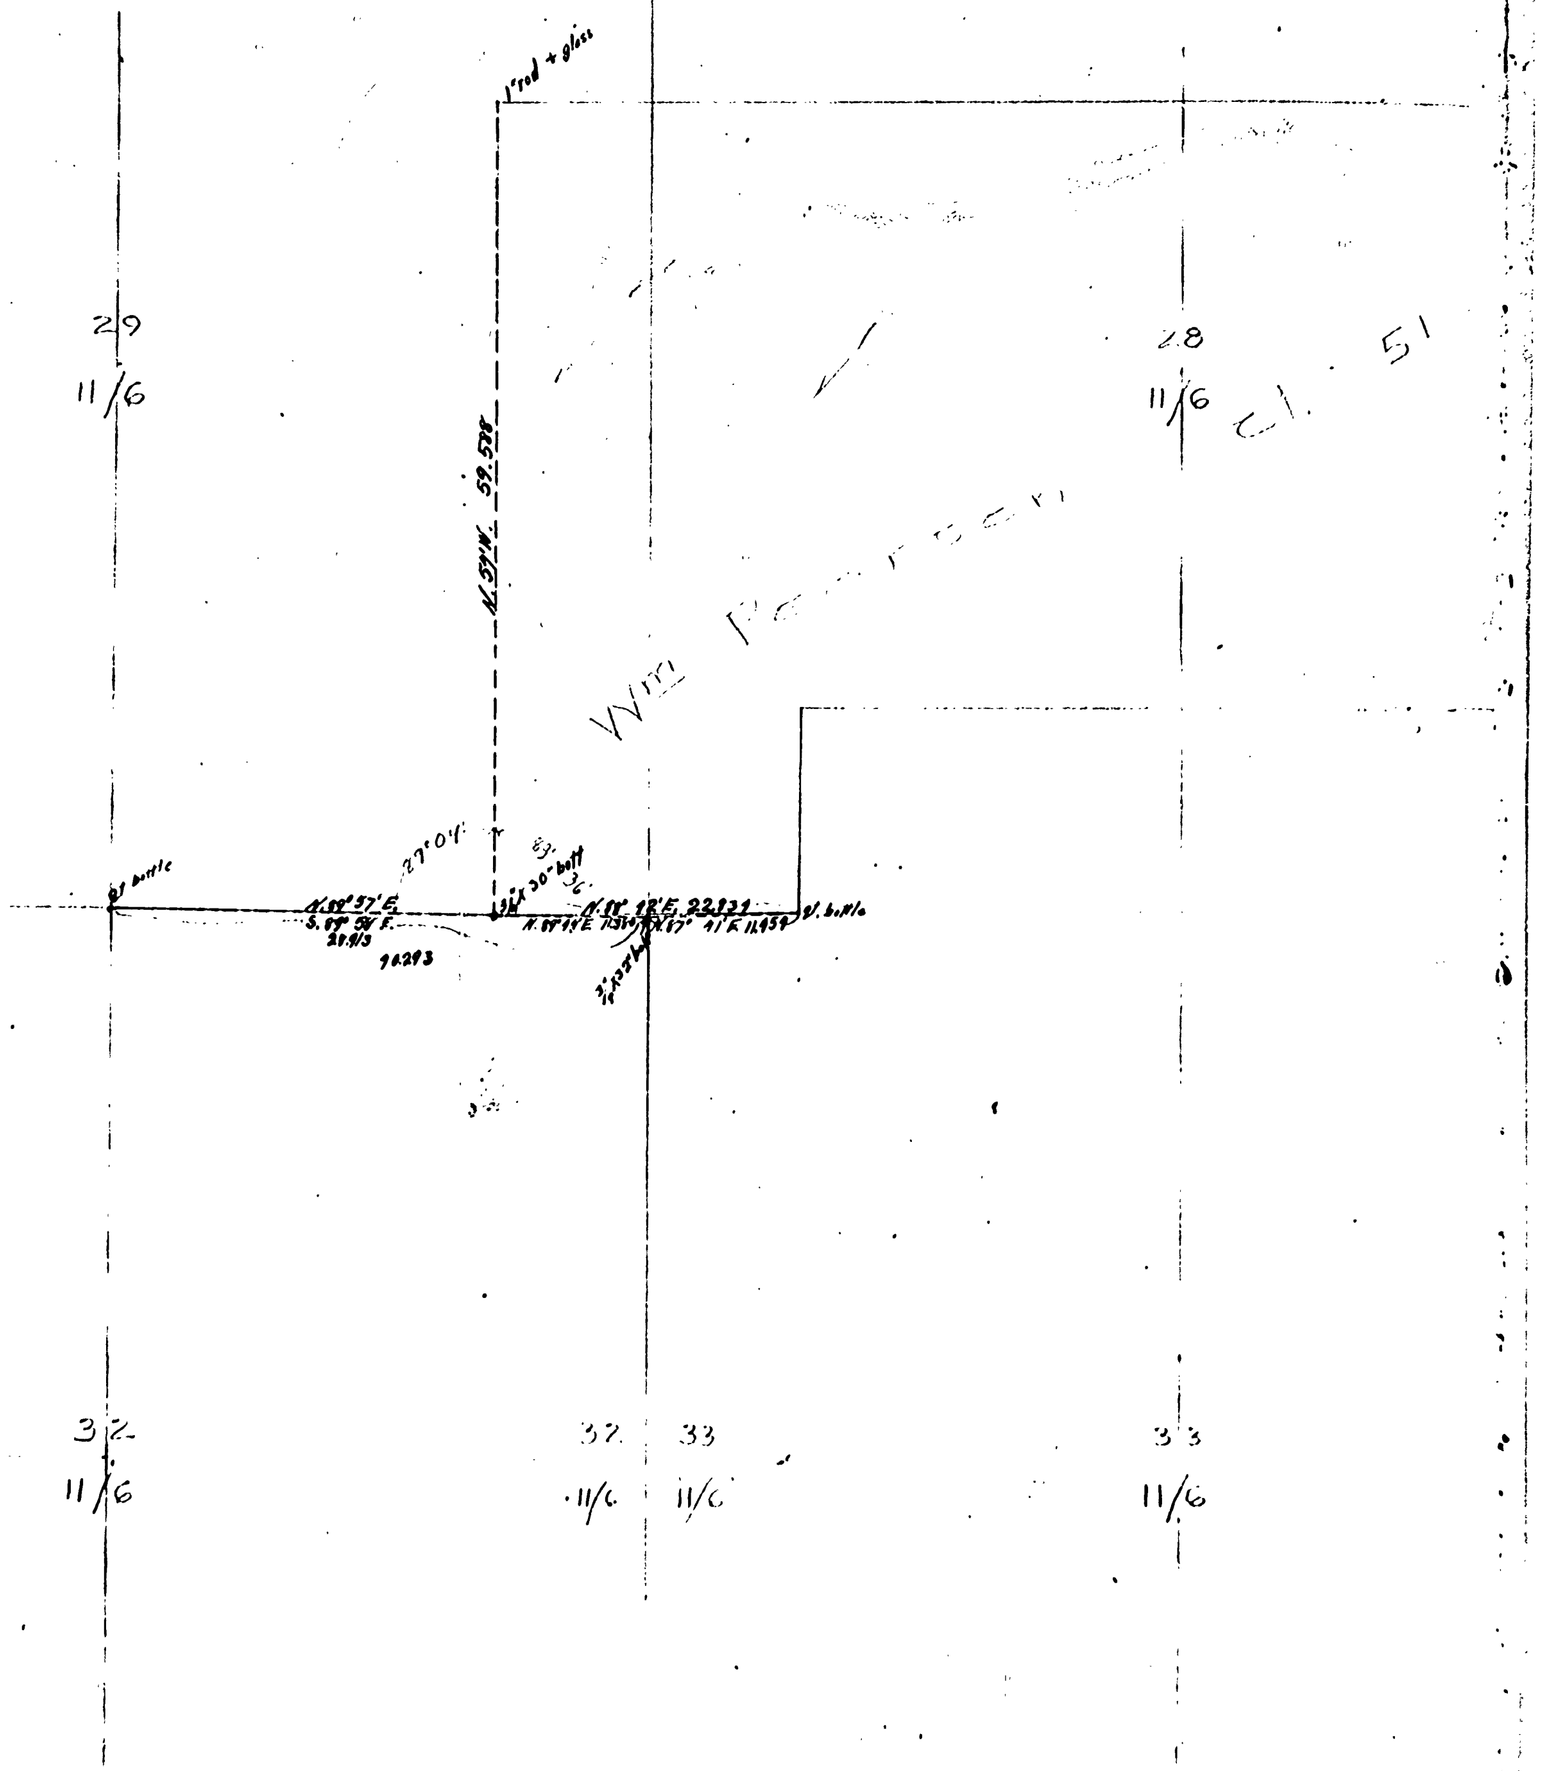

FB 15

9 Survey # 112 Tp. 11 S. R. 6 W.

N.W. cor. W.M. Pearson Cl. 51.

Oak 30" N. 74° E. 3.05 Std.

#256 24" S. 87½ E. 5.73 Stump

7" N. 89 E. 1.13 Set Fir root

South

1			12.072
2			2.802
3		-3° 10'	1.849
		-4° 20'	5.130
4		-1° 40'	4.093
5		-2 30'	2.892
6		+12° 45'	3.788
7		+9° 30'	2.623
8		+5° 30'	2.510
9		+2°	2.111
10			2.315
11		-3° 40'	2.652
		-5° 10'	4.[illegible]
12		-4° 15'	7.024
			-.046
			E. .003

July 13

S.W. Set ¾"X 30" bolt 12" deep

Ash 12" S. 12° 43' W. 6.973 chs.

Oak 11" N. 73° W. 6.558 "

22/28 Set ¾"X 32" bolt 15" deep Stump std. + 11.38 from DLC

32/33 Oak 6" N. 73° 30' E. 8.907 chs. Cor. W&C

" 8" S. 45° 40' E. 7.110 "

.204 S. of DLC line

July 11, 1911. Dirt Road J. H. Goldman

16 47	5.130	4.093	2.892				
92999	58999	58999	56999				
16623	41229	38837	26028				
1682	4179	3683	2632				
168	363	512	260				
16	5	32	1				
3		3					
1		1					
1.84555	1.153	4.092	2.8891				
		5.115					
		9.207	2.111	2.652	½ 28.7853		
3.788	2.623	2.510	93999	57799			
43179	13599	22599	18799	23901			
34092	23967	22599	1899	2390			
2651	2130	22599	199	185			
37	133	22599	19	23			
11	7	129	1	1			
1		10					
36792	26237	24984	9.1074	2.6503			

12.072					
2.802					
1.849					
9.207					
2.869					
3.679					
2.624					
2.488					
2.109					
2.315					
2.652					
14.977					
59.639					
.046					
59.593					
22.634					
11.354					
11.454					

7.022 offsets .0465 .6150 .564 N. .8175 .258 S.

52799

68234

63223

4911

9

7.006

2.962

W. 277

22.824 11.38

.01893 = 1° 2'

1.704

1.138

90 20

79 66

16510

10242

2980

.01772 = 1° 1'

.207

1.145

594 60

40178

40820

40178

11.454

.01108 = 38'

253 6

22.834

246 60

22.834

1.826 98

1.826 98

Flagpole Trial dist. bet. SE. cor. & ¼ sec. cor.

W. Cl. line South Cl. cor. to ¼ sec. cor. N. Cl. cor. N. 89° 04' W.

East
Correction N. 24'

13	∠ [illegible] 2°4'	14.922	offset	.610 N.
14	∠ Right 7°52'	7.72		
To Cor.	16°24'	1.151	offset	.817 S.
	Set 2". 60 7/5	orig.	cor.	
	Mobile 6" W. (60 E.)	.08	Stat.	
	F.F. 5" (S.60°W) S.25W	.18	Stamp	
	W. " 12" N. 40°30' W.	310		
	Cor to △ 12			

Correction N. 56'

11	∠ [illegible] 3°3'	6.473	offset	2326.
16		5180		
17		2.642		
18	∠ Right 6°43'	+4° 2.202	offset	.257 N.
19	∠ Left 3°	+5°20' 1.638	offset	.255 S.
20	∠ Right 7°31'	1.132	offset	.139 N.
21		+19°46' 2.603		
22		+5°50' 1.125		
23		-2°30' 2.053		
24 Point 5 on 47	∠ Right 7°56'	-11°25' 2.427	offset	.338 N.
△ 48 + ½ Cor.	∠ Right 10°31'	+ 3° 1.591	offset	.271 N.
△ 44 is S. 5°54' W. from △ 47 in				28.911

Survey 111

| | | | |

112

Plat of Survey No. 112 Claim No. 51 MADE FOR J. H. Goldman and W. P. McFarland

Section 28 + 29 Township 11 S. Range 6 W.

Scale: 10 Chains to the Inch.

Field Notes recorded at page 9, Vol. 15, Record of Surveys.

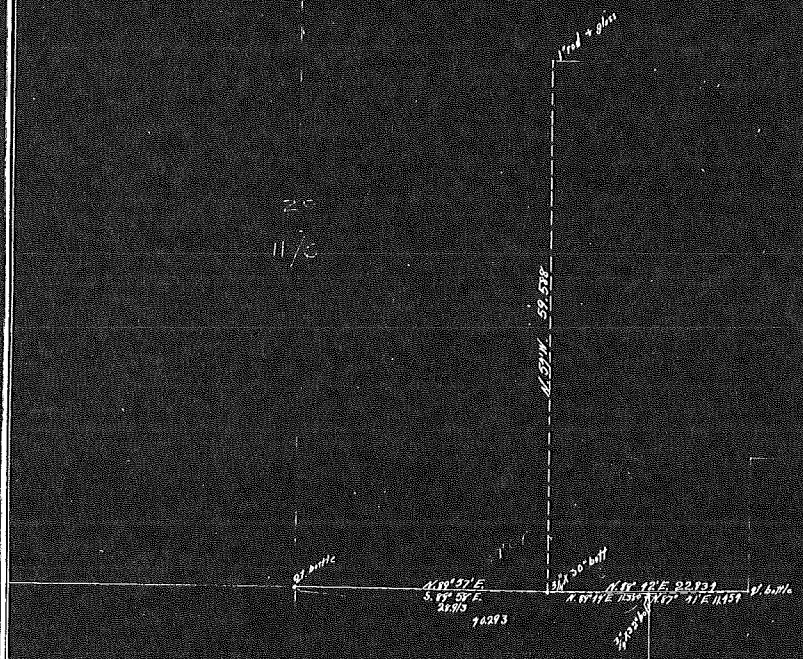

Plat of

Section

Field N