C.S. # 263

Hardcopy 14-6 # 13

also see notes in file

F. B. 10-12

Book No 10

10

#269

12 Alpine Site — Jesse Bishop Cl. #50 / 41

Tp. 14 S. R. 6 W.

1	Beg. at harrow tooth in road N. of line			
	N. 5° 58' E.		2.254	Harrow tooth
2	N. 89° 52' E.		4.442	
3		3° 20	7.712	
4			6.425	S. 90 H. E. 602
5	S. 7° W.		9.504	
6	S. 74° 34' W.	1°	6.691	+ .624
	S. 74° 27' W.		7.276	5/8" rod
	S. 89° 54' W.		.060	Harrow tooth
	Beg. at S. E. cor.		Cl. 50	
7	N. 10' E.		10.542	1/2" spike
8	S. 77° 26' W.		18.160	
9	S. 4° 3' W.		.795	
10	S. 69° 35' W.		2.141	
11	South		2.408	
12	S. 26° 27' W.	3° 20'	1.963	− 1.959
	Back to Δ 8			
13	S. 74° 26' W.		21.362	Cen. road
14	N. 89° 54' E.		17.649	Cen. Creek.
cor.			20.390	S.E. cor. Cl. 50.

From spike on S. of RR. to 3/4" rod on N. of RR. .941

" N. of RR. to cen road. 5.119

7.713 / 13.893 / 6.940 / 6.940 / 6.940 / 6.940 / 7.698 / 6.690 / .624 / 7.314 / 1.963 / 13.893 / 1.766 / 1.766 / 156 / 19.594

0.690 / 4.442 / 0.446 8 / 4.442 / 6021 0 / 13.893 / 4014 / 4014 / 267 / 267 / 26 / 26 / 6.451 / 1.768 / 8 / 1.773 / .004 / .005 / 6.69 / 3.00 / 1.963 / 13.893 / 15.856 / .037 / 7.346 / 2.140 / 5.842 / 8 / 15.982 / 21.362 / 6.238 / 3.540 / .398

S. 69° 54' W. / 7.34 / 15.20

18.566 / 12.141 / 6.425
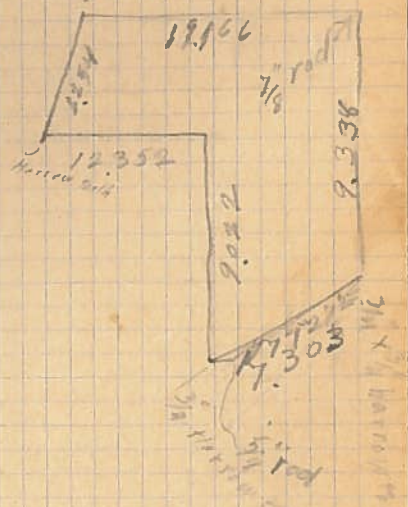
4.442 / 7.699 / 12.141