118

Plat of Survey No. 118 #268 Claim No. 55

Section 16 & 17 Township 12 Range 5

Scale: 10 Chains to the Inch.

Field Notes recorded at page ~~30~~, Vol. ~~10~~, Record of Surveys.

Field book 10 page 30 ~~Vol 10~~
" " 12 Page 34

MADE FOR Caleb Davis

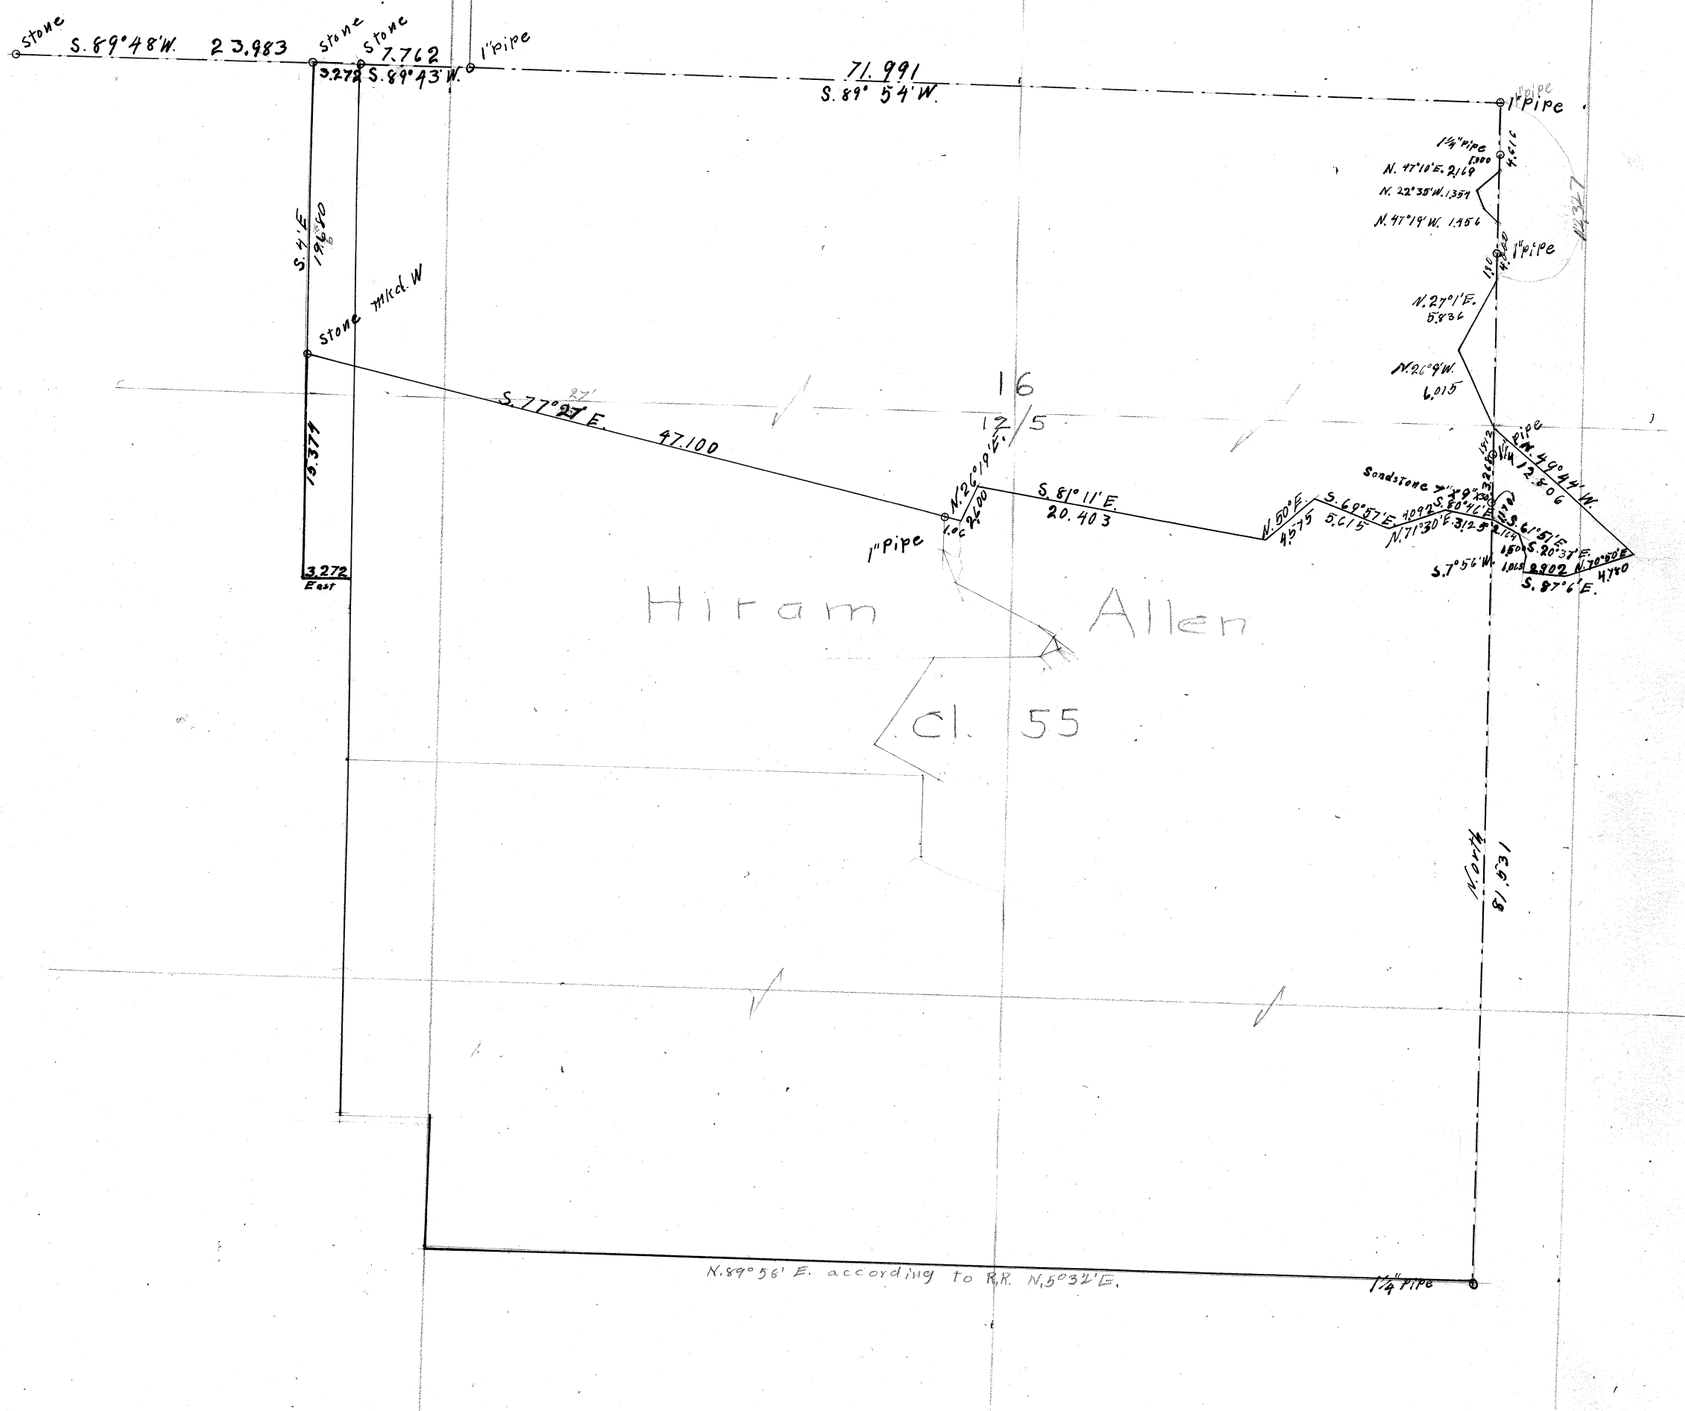

21
12/5

268

268

118

268

PLAT
of
BASSELIN FARM

Tp. 12 S. R. 5 W. Will. Mer.

Benton County, Oregon

scale 1" = 10 chs.
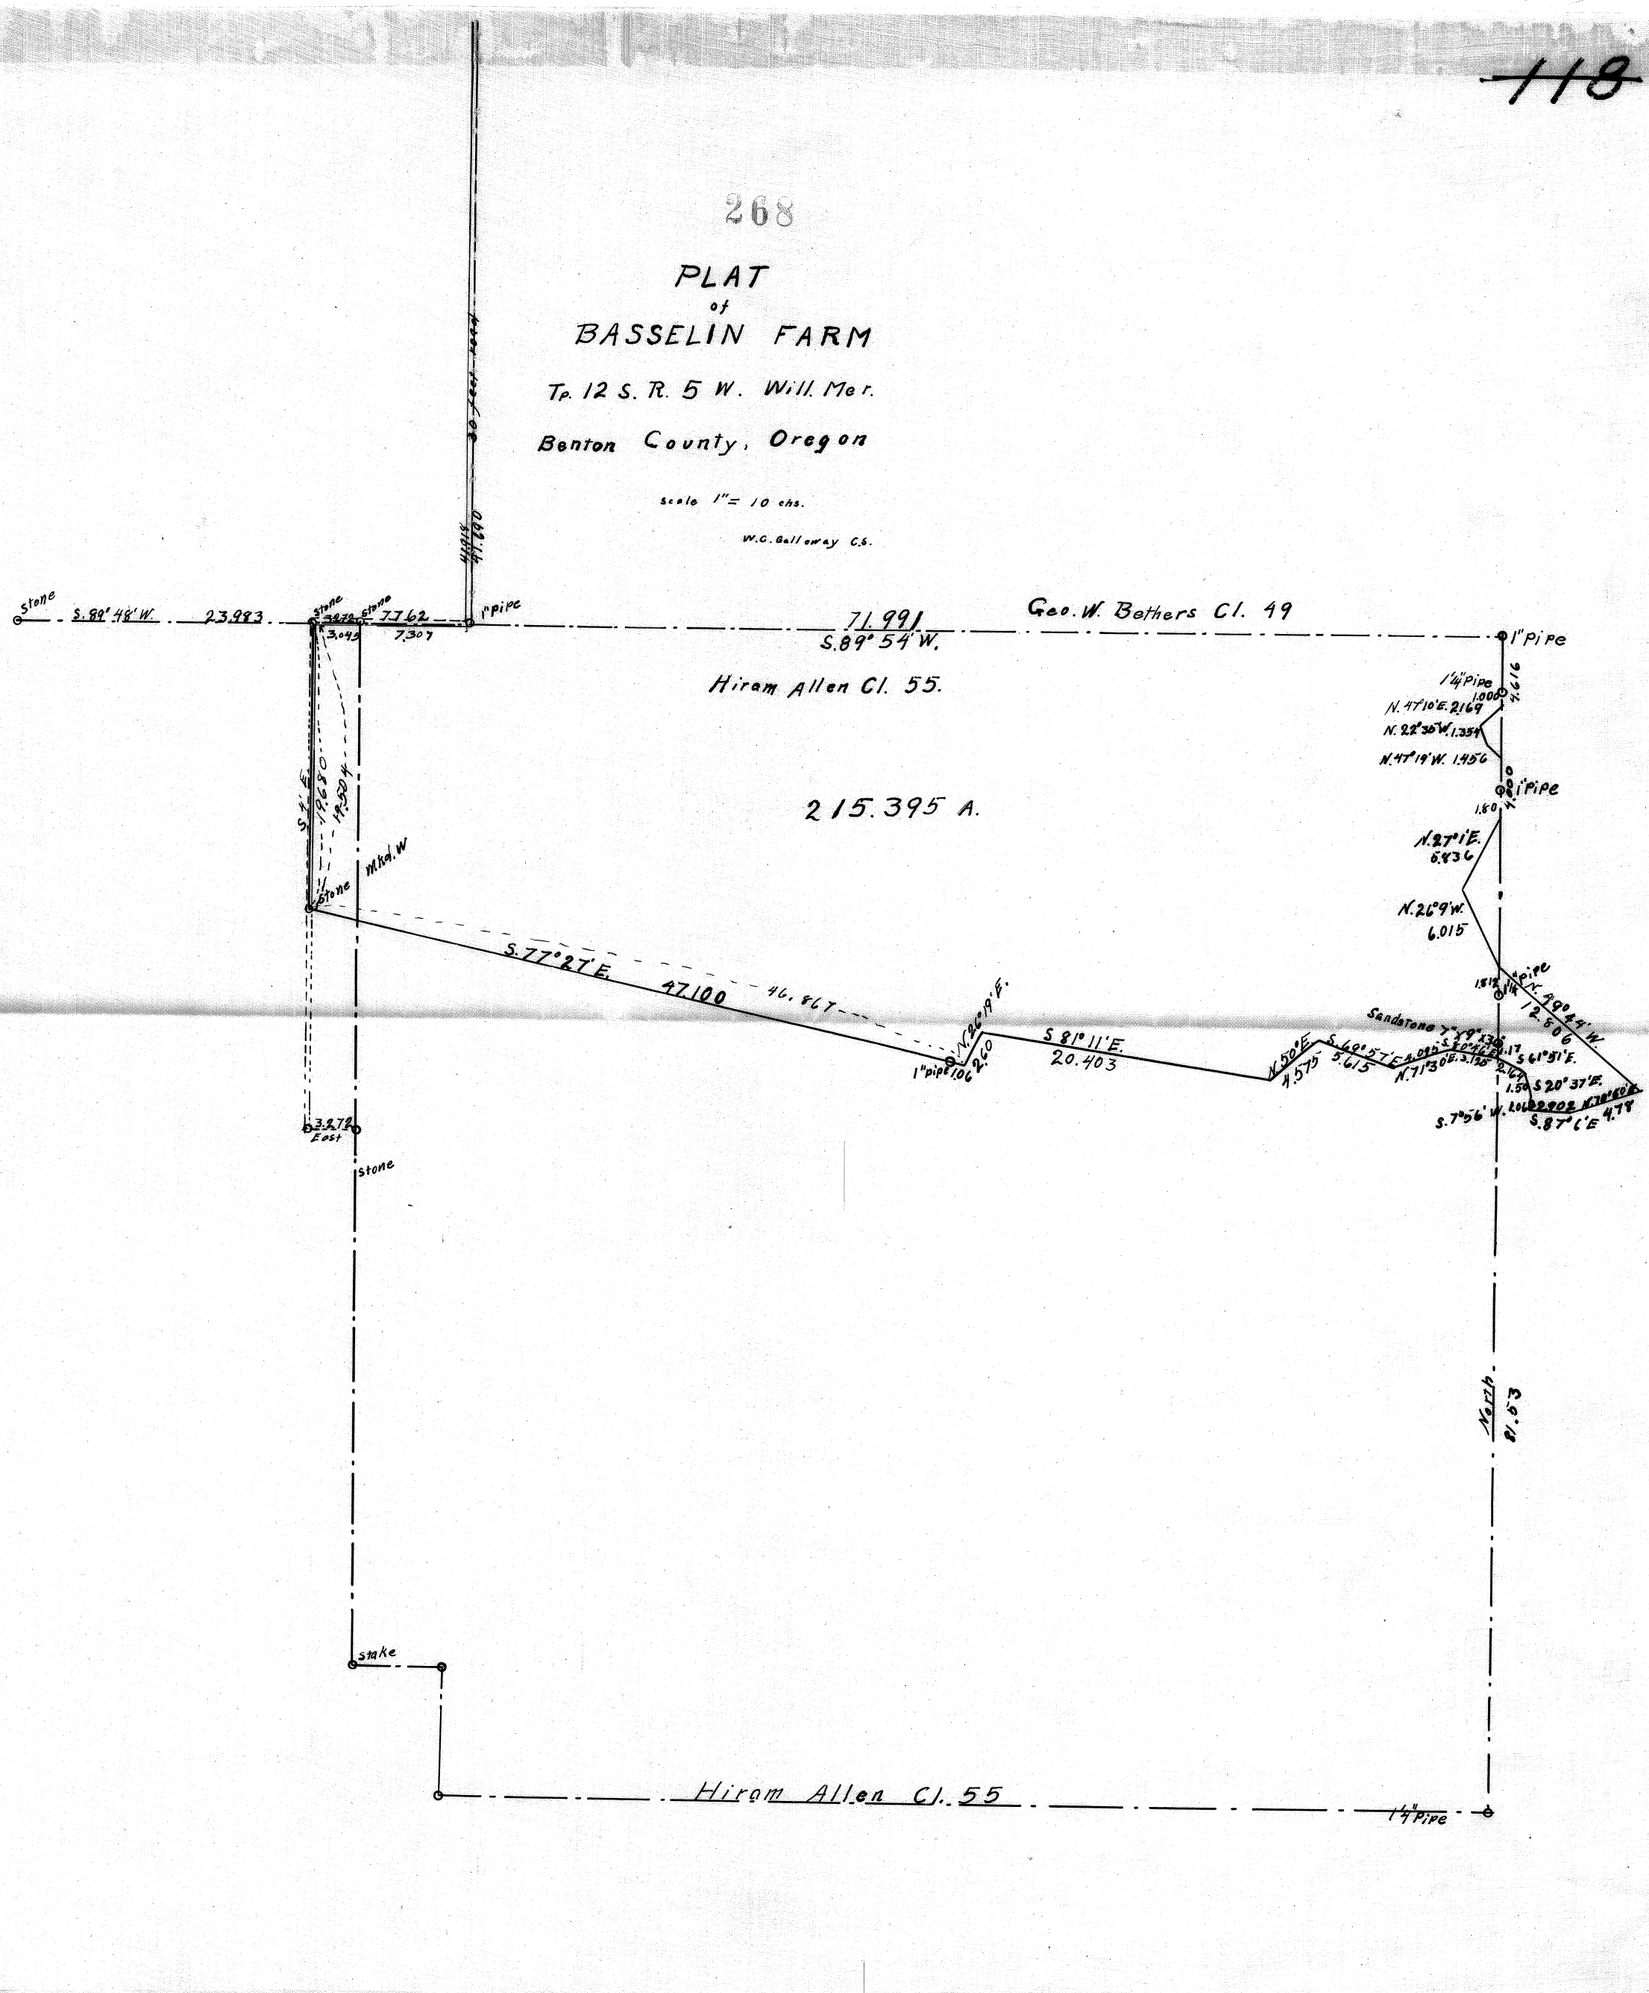
W.C. Galloway C.S.