C.S. # 273

Hardcopy 14-6 # 12

also see notes in file

F. B. 10-39

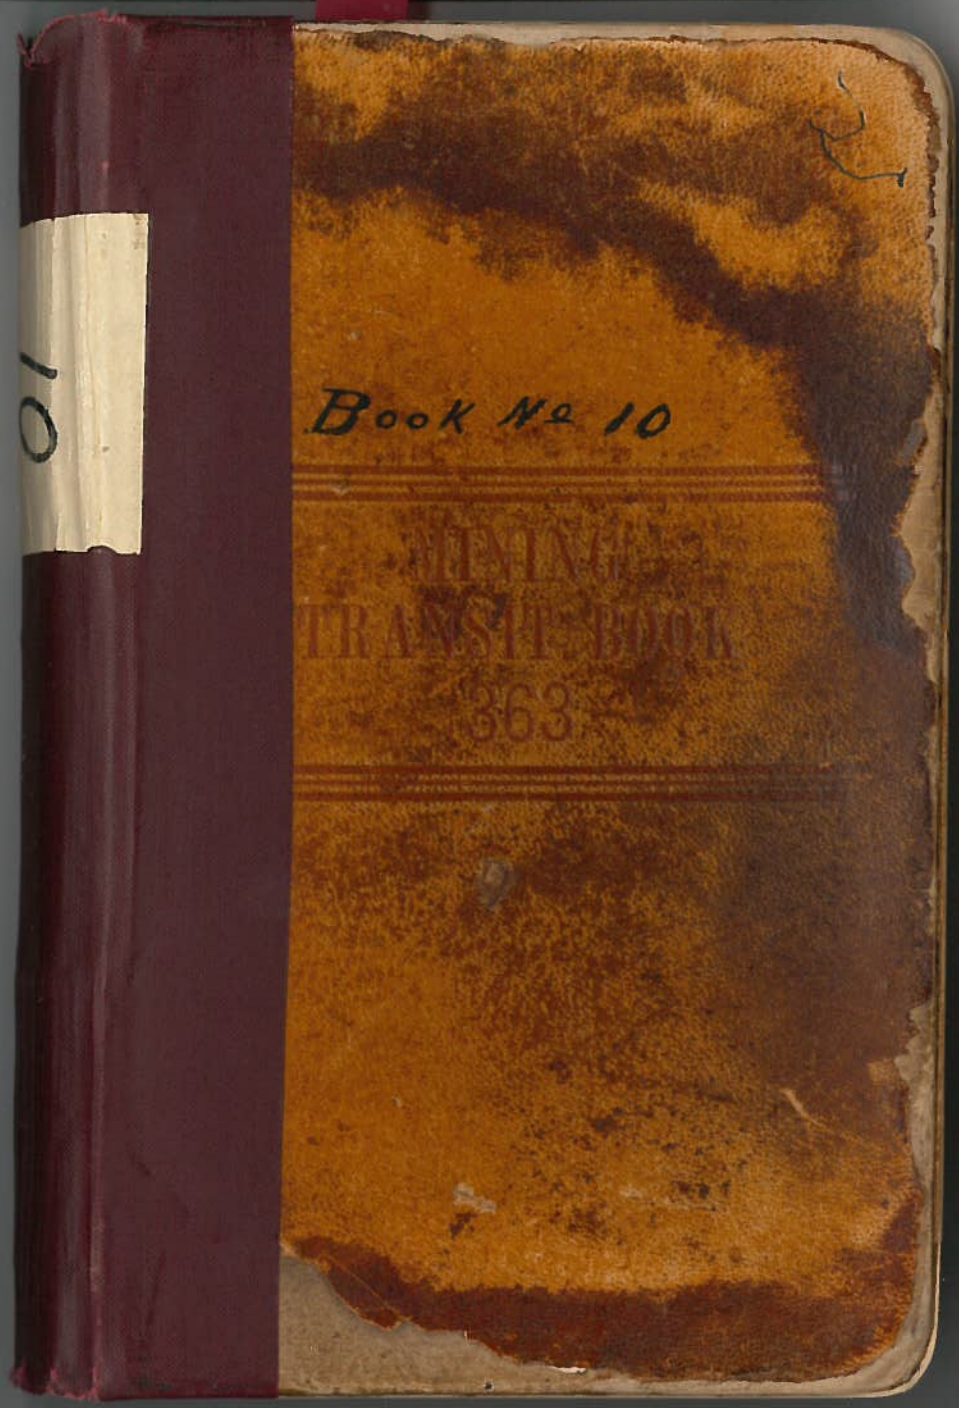
01
Book No 10
TRANSIT BOOK
363

#273

39 Continuation of Survey #103

For O. K. Scott,

Beg. at Stone 2.262 W. of △37 Pos 35

Silas Belknap Cl. #40 Pp. 146

Beg. again at S.W cor. of Cl. 40.

| | | | | |
|---|---|---|---|---|
| | North correction N. 4' | | | |
| | ∠ Left 2°15' | 5°45' | 8.000 | offset .400 W. |
| 1 | | 9°50' | 2.273 | |
| | | 5°50' | 6.261 | |
| | | 8°50' | 6.567 | |
| 2 | | 4°20' | 1.791 | |
| | ∠ Left 27' | | 7.994 | |
| 3 | | 16°30' | 8.002 | offset .137 W. |
| | | | -.236 | |
| | Striking W. of cor. | | .476 | |
| | East correction 9.5' | | | |
| 4 | | 5°30' | 1.772 | |
| 5 | ∠ Left 2°11' | 9°20' | 4.873 | offset .183 W. |
| 6 | | 7°30' | 5.636 | |
| | | 12°28' | 7.493 | |
| | | 5°50' | 8.000 | |
| 6 | | | .948 | |
| 7 | | | 2.161 | |
| 8 | ∠ Right 37' | 4°10' | 7.988 | |
| | | | 1.465 | offset .101 S. |

Frank Dater

Nov. , 1911.

Book 8

22.247
2.262
24.509

10.191
6.229
6.489
1.782
7.994
7.673
40.362
.236
40.126

1.768
.476
1.292
4.306
5.083
7.316
7.959
.948
2.161
7.964
1.462
39.998

39.913
39.998
.115 E.

40

Stone Mkd. oak 14" ☐ 8.3°10'E. 7.58
N. 30°35'E. 4.05
14

| | | | | | |
|---|---|---|---|---|---|
| | | | | + .415 | |
| | | | | S. .379 | |
| 9 | | | 3° | 5.020 | |
| | | | 6°10' | 2.447 | |
| | | | 8°35' | 8.000 | |
| | | | 9°50' | 8.000 | |
| 10 | | | | 1.077 | S. 4.10 / 4.028 offset .007 S. |
| 11 | ∠ Right + 5' | | 4°30' | 5.018 | |
| S.W. cor of Buckley's Cl | | | | − .239 = | |
| | Striking N. of cor. | | | .418 | |
| Continuing East. | | | | | |
| 12 | ∠ Right + 9.93' | | 2°30' | 3.599 | offset .576 S. |
| 13 | ∠ Right 24' | | 1°50' | 7.032 | offset .049 S. |
| | | | | + .377 | |
| | | | | + N. .201 | for cor. |
| | South correction N. 7' | | 50' | 7.956 | |
| 14 | ∠ Right 32' | | | .822 | offset .062 N. |
| 15 | | | 1°40' | 7.389 | |
| 16 | | | 3°30' | 2.896 | |
| | | | | − .048 | |
| (Continuing) | Striking N. of cor. | | | .422 | + |
| | ∠ Left 31' | | 3°20' | 8.000 | offset .133 E. |
| 17 | | | 5°20' | 4.765 | offset .248 E. |
| S.E. O.A.O. cor. | ∠ Left 2°22' | | 2°30' | 6.010 | |
| Back to Scott's S.W. cor. | | | | Set a stone 12"X12"X18" | |
| N 7° E | | | 4°50' | 8.003 | |

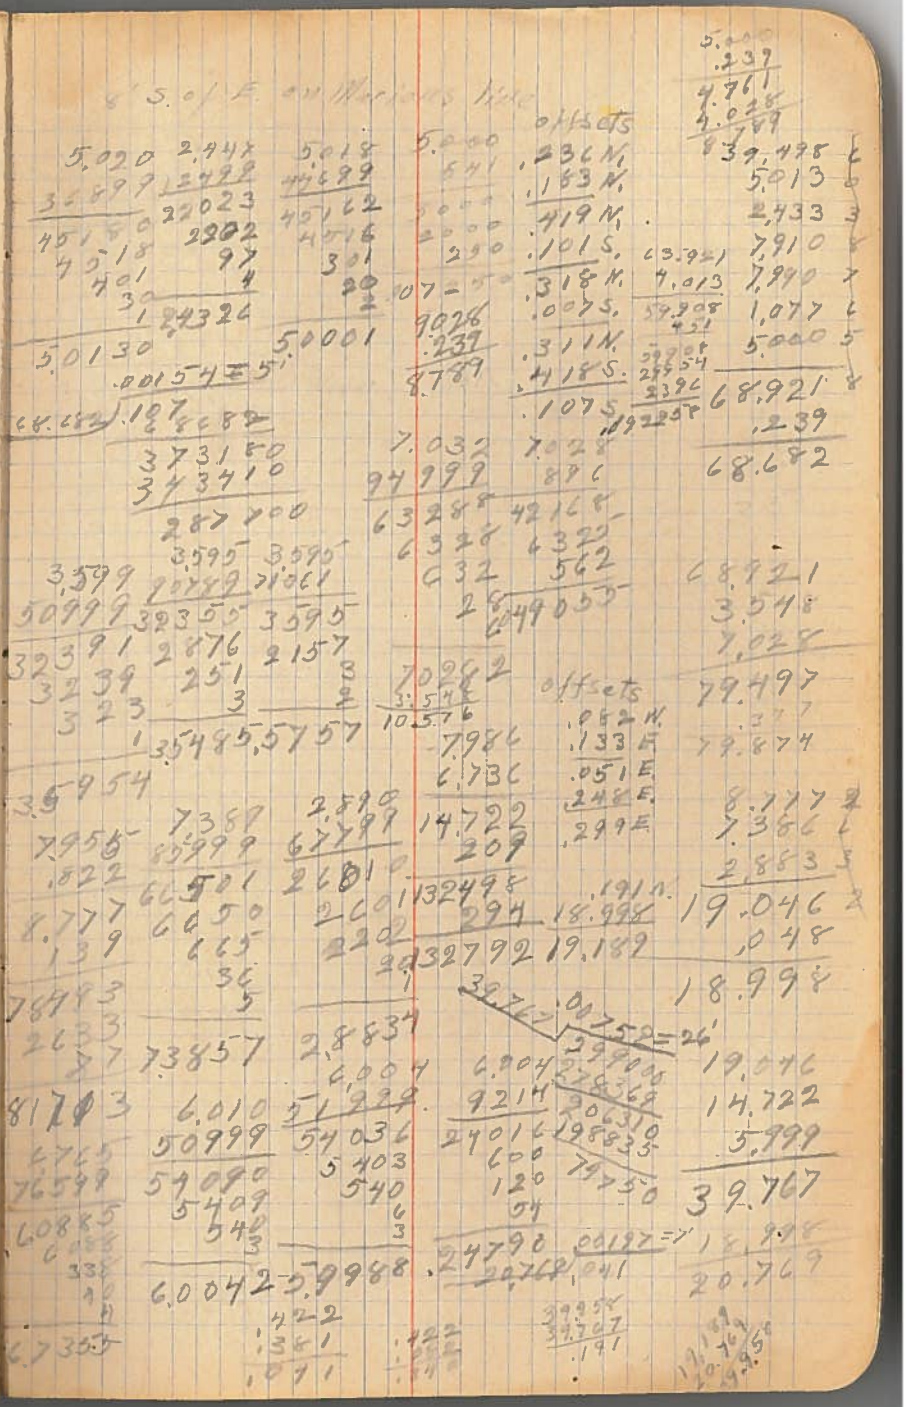

41

| | | | | |
|---|---|---|---|---|
| 18 | | 9°40 | 5.576 | |
| 19 | | 12° 7' | 5,298 | + .940 Set X 1.369 Post |
| 20 | | 5°10' | 1,973 | |
| 21 | | 1°40' | 2,198 | |
| | | 8°40' | 2,637 | |
| | | 11°50' | 5,049 | |
| 22 | | 4°30' | 5,074 | |
| To △ 8 | ∠ Left 7°41' | 9°56 | 5,097 | Offset .410 W. |

Back to △ 41 Page 36 Book #8

East .536 Set Stone 5"x11"x17" Set Stone E. .438 of Stone

Double oak 20" N. 33° E. .982 ok

N. 8° E. correct W. 1'

| | | | | |
|---|---|---|---|---|
| ~~23~~ | | 4°30' | 8.000 | |
| 23 | | | 018 | |
| 24 | | | 2,072 | +.135 +.350 |
| 25 | | 9°34' | 5,436 | |
| 26 | | 4° | 3,315 | + + 1.204 |
| | | | +.779 E. .007 | |

Set oak stake

| | | | | |
|---|---|---|---|---|
| 27 | | 2°40' | 1,300 | |
| 28 | | 5° | 1,564 | |
| 29 | ∠ Right 56' | 2°20' | 3,668 | Offset .060 |
| 30 | | | 6,753 | |
| 31 | | | 2349 | |
| | Striking E. of ∠ to be | | .075 | |

42.

| | | | | |
|---|---|---|---|---|
| | Back to △26 | | | |
| | N. 89° 57' E. | | S. 7 cor. | |
| 32 | ∠ Right 36' | | 6,128 | offset S. 30 |
| | | 1°30' | 4,150 | .064 |
| | | 2°10' | 6,000 | .281 |
| 33 | | 2°10' | 1,926 | .205 |
| 10 to 16 | N. 26° 53' W. | | 1,392 | |
| | S. 6' W. correction 1' W. | 6°35' | 8,000 | |
| 34 | | 7°40' | 1,894 | |
| | | 13°35' | ,663 | |
| | | | 3 | |
| 35 | | 1335' | ,863 | |
| 36 | | 3°20' | 3,018 | |
| 37 | | 2°50' | 5,991 | |
| | | | .068 | |

20.709
19.591
1.178

6.123
.394

24492
55107
306
030308

531
5 994
6 53

3.279

2121081
9.795
6.530
3.265

6.123
4.321
10.444
9.990

6.123
4.148
7.994
1.925
20.190
.205
19.985

4.146
.173

4.321
2 401
7 921
172
30
.04523
.064
.107

1894 863
60192 30278
17046 77677
1724 604
18 17
1 1
1.8769 .8388

3,018 5991
13892 87899
27162 53919
2716 5391
241 479
9 41
4
30128 59834

7.947
1.877
9.824 9.839
9.795 3.013
.029 5.983
19.659
19.591
.068

.086
.011
.070
.186
.007