C.S. # 282

Hardcopy 12-6 # 19

also see notes in file

F. B. 9-38

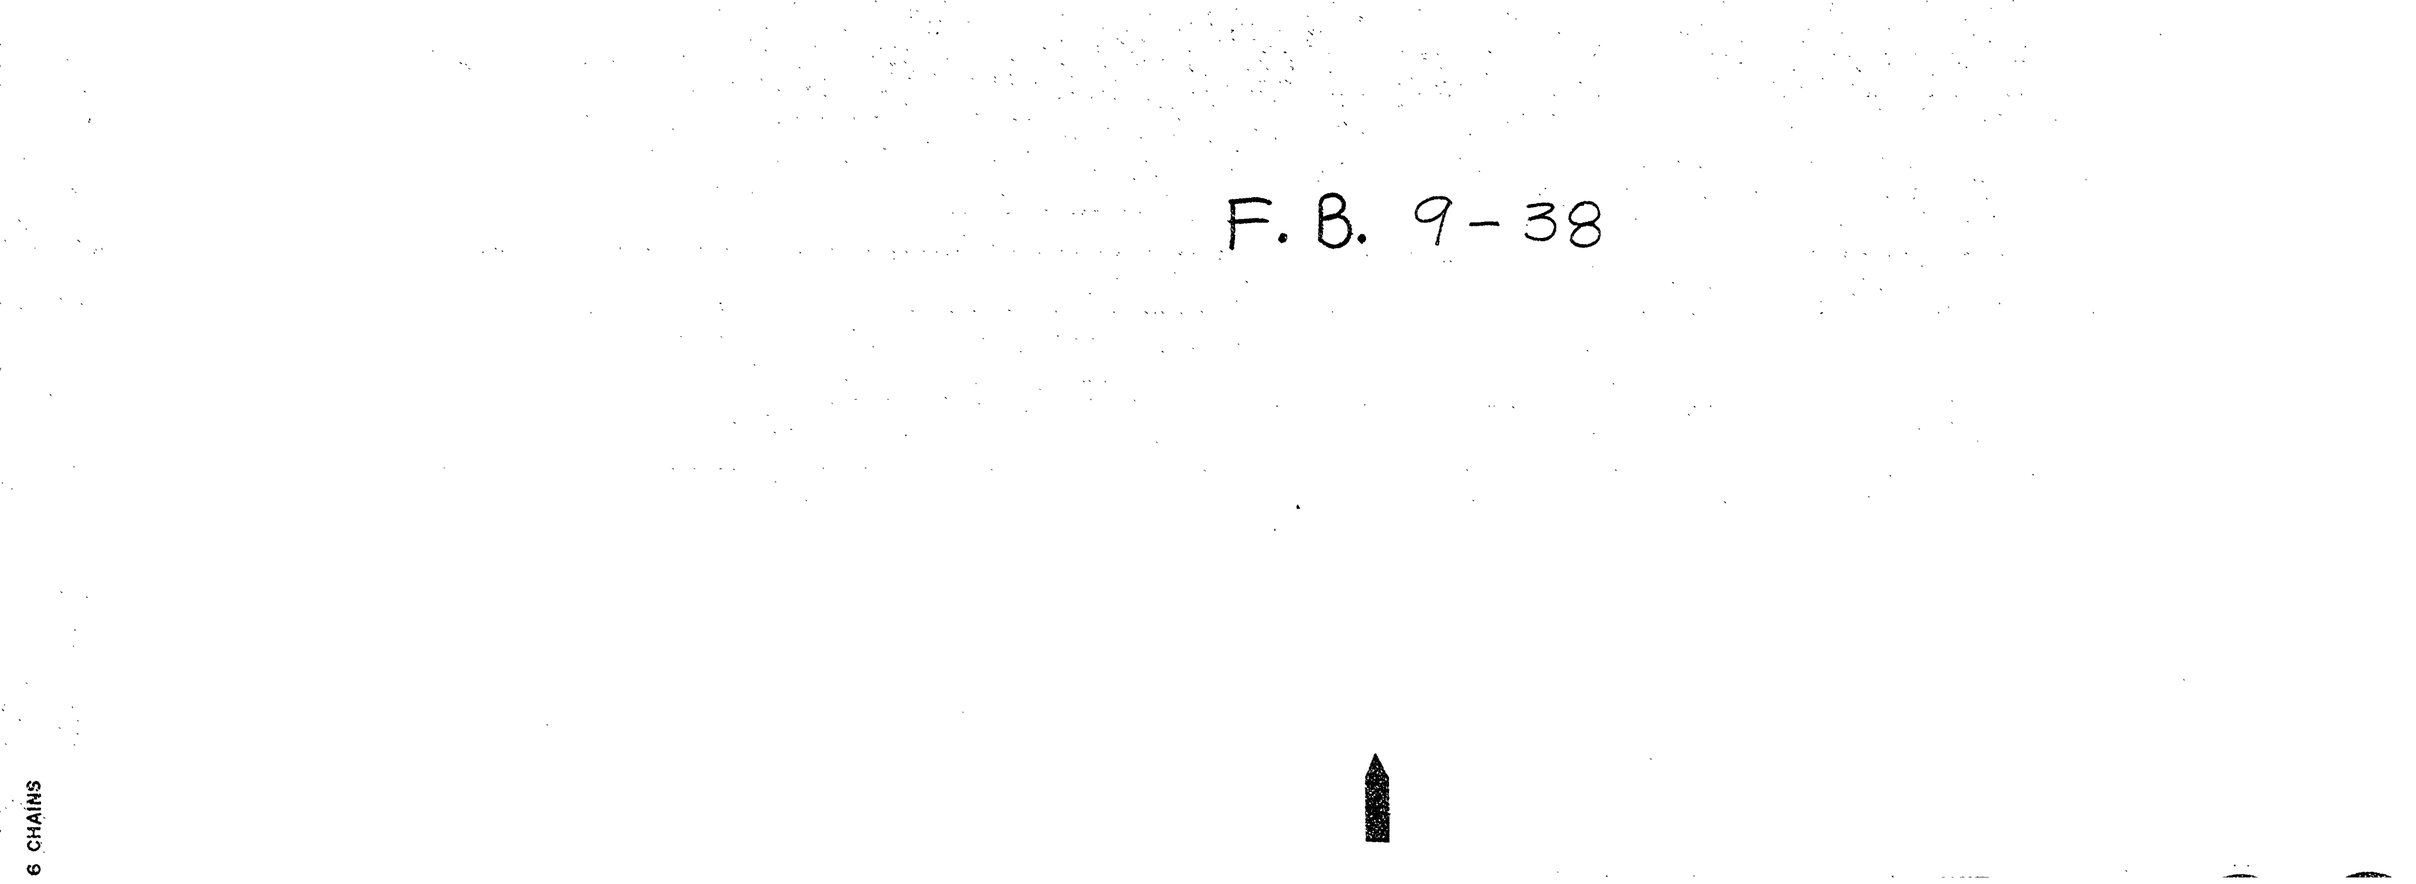

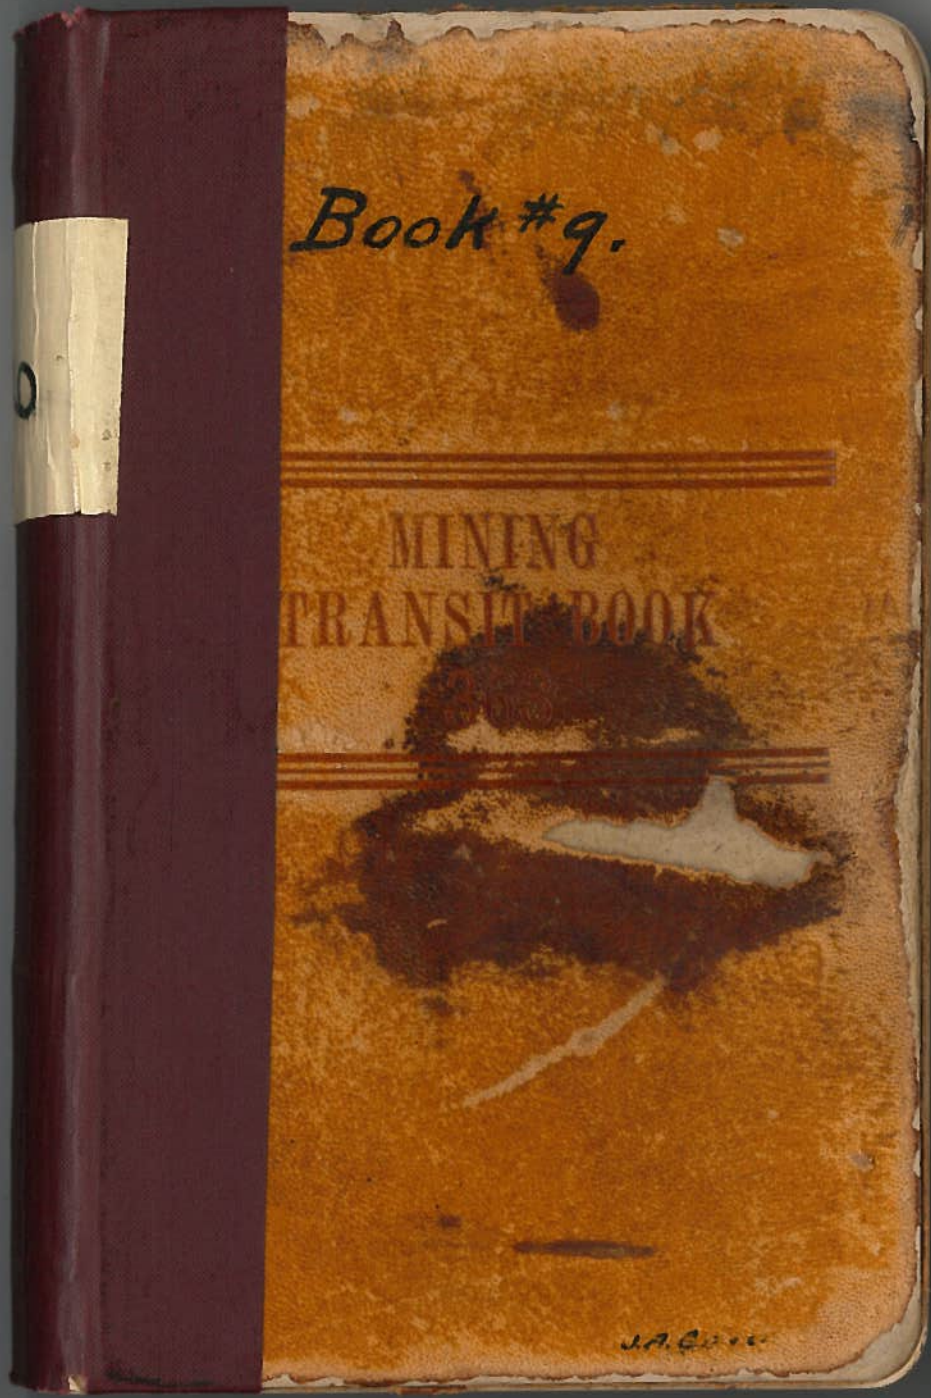
Book #9.
MINING
TRANSIT BOOK

38 Horgan & Yates CS.#144 Jan 18th 12.

#282

Beg. at Jens Petersons N.W. cor. NW

South line of A. Hansen C/67 12-6

East		LL 35'	+8-40	1.630	.016 N
1			+6-10	.958	
2		LL 3°-35'	—	2.970	.185 N
Set. Stake on line				N.048	Comm. 1.33 N
Set Stone 18X14X8				-.303	
Alder 18" N 5° E				5.043	
Willow 18" N 89° W				.485	
East				.255	
			+14-20	7.022	
3		LR 10'	-3-30	4.843	.014 S
4		LL 2°17'	+8-30	2.784	.109 N
Set Stone 16X12X10				-.092	
Fir 14" N 30°30' E				5.138	
Fir 24" S 80°-15' E				.130	
Thence North		LL 41'	—	.233	
5		"	-9-	2.103	.101 W
6		LR 01'	-13-	6.480	
		"	—	8.000	
7		"	-9-50	.373	
8		"	-11-20	2.512	
9		"	-10-40	5.142	
10		"	-14-20	1.769	
11		"	—	3.970	Took Sun Horz
				4.381	.007 E
Thence East			—	7.883	
Set at Stake Stake 4X4X36"				S.046 W.044	
Maple 16" S 67-30 E				1.130	

8-40 1.630 5889 14670 3304 130 8 1.6112 8V010 1611 16 12 .01639 8-31 4843 31899 43587 43556 387 5 4.8337 18200 9648 4351 48 D14067 13- 8.000 78479 73000 5600 320 29 78949 10-40 1.769 7289 15921 1415 35 12 1.7383

6-10 .958 2499 8622 8622 39 .95239 14-20 7.022 78869 63198 42 13 560 60 6.8021 7- 6480 96789 583 20 51 84 453 3-8 5 6.400-0 2.103 8.503 39110 8503 550 766 25 .10143 14-20 3970 78569 35730 2382 917 33 3.8462

5-35 2.970 5360 17820 5944 148 .18562 5.533 8-31 2.784 .089 25056 2227 250 2.759-3 48930 8251 2477 220 10 .10966 9-50 2.512 3589 22608 2009 125 7 2.4749

.043 201 .15 .02855 15500 11066 47340 44264 30760 27665 30950 .109 443 .153 017 .138 11-20 5.142 5089 46278 4313 25 5.0616

185 016 201 1.611 .952 2.970 5.533 22.370 27903 27.60 .303 6.812 4.834 2.753 14.692 14.600 .092 .138 -3 7.895 R 8.503 .7 .37334 25.771 -4 5 2.475 5.062 -4 34.412 .046 1.739 -2 3.846 -3 34366 4.381 -7 4 25.771 92... 51542 23193 .0074795

39

12	East	∠R 3°04'	+ 6-20	4.121	.219 S
13			—	8.000	
			—	6.441	
14		∠R 1°23'	—	6.187	.149 S
15			—	4.166	
16			—	7.092	
Int.	Henson's N.E. cor.			5.414	
Back to Sta # 11			—	3.406	
Thence	West				
17			—	4.754	
18			—	6.879	
19	N 37-38 W			3.502	2.138 W
					2.773 N
20	S 69-38 W			7.927	7.431 W
					2.758 S
21				2.535	
Set at	Sta # 18 Stone 18 X 6 X 4			-.395	
				5.046	
1st Sta	West of Sta # 11			-.010	
Int.	Yew Tree			.152 N	1 Yew 16"
				.060 W	S 41-30 E 1.138
Set	Stone 12 X 12 X 10			.046 S	.083 W
Thence	N 41-30 W			8.000	
	N 40-46 W			.501	
11				4.065	
Set	1/4 X 3/4 X 16" iron 1/2" pent			-.150	
				3.915	
Ash 20" N	29-10 E		2.263		
Fir 16"	S 66-45 W		1.068		
Thence	N 40-30 E			8.000	
				2.767	
				3.060	
				-.045	
				N .112	
				-.283	
Thence	S 40-30 W	S 38-51 W		4.555	

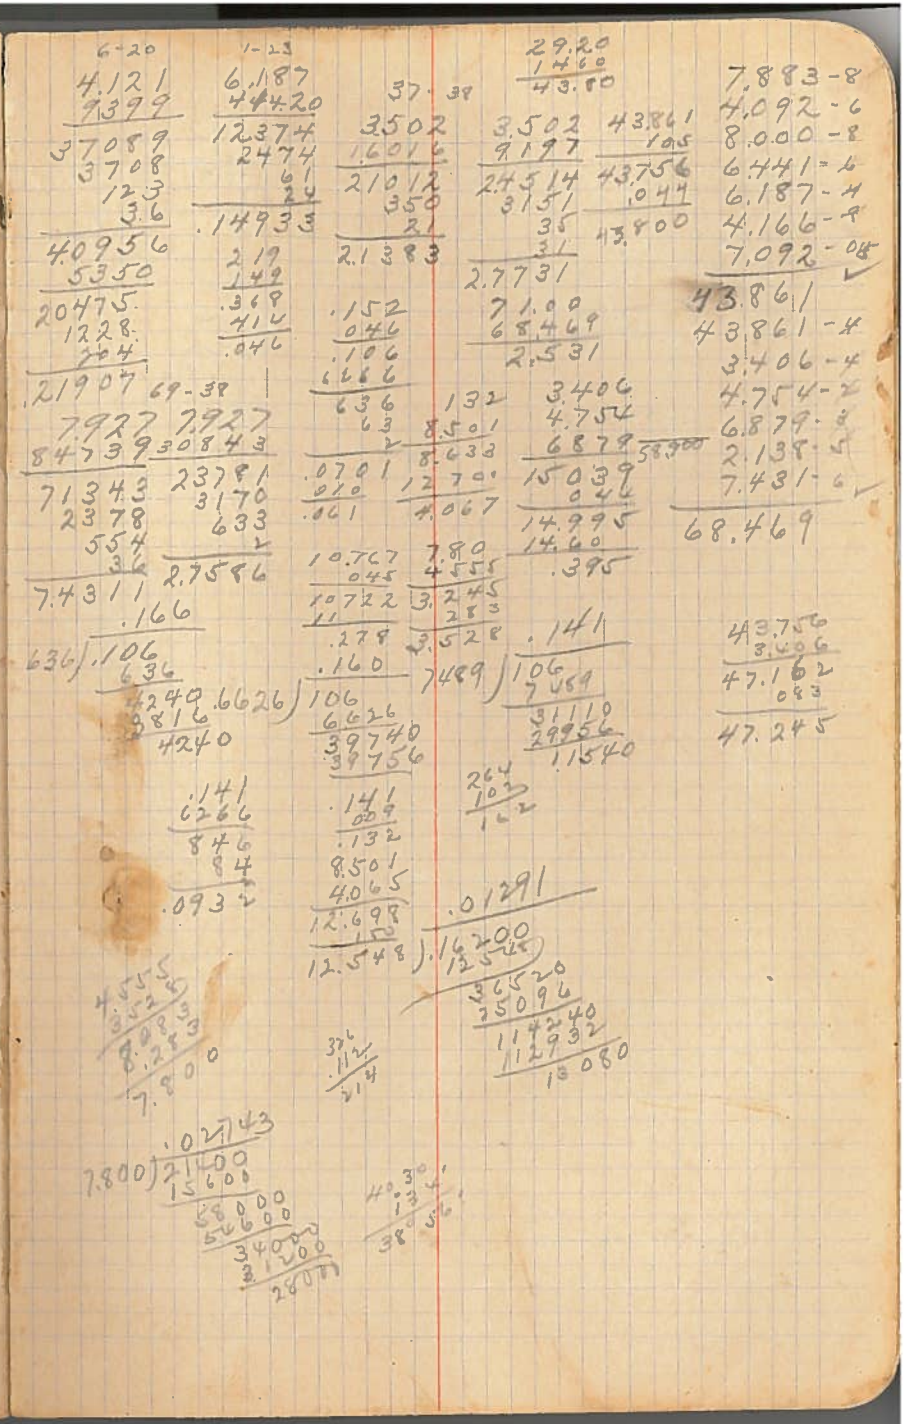

			3.528	
			.136 N	
Set Stone	8X8X8	W.C.	.210	N 49-30 W
			.116	
Oak 4"	N 19-25 E		.550	
Chittim 8"	S 86-20 W		1.055	
			.0365	
			.181 W	
Thence	S 3-30 E		1.862	
Set iron 3/4" mut.		W.C.	.175 E	
Oak 24"	N 7°-50' E		.211	

210
4067
1470
126
.1596

210
946
1260
84
.1342

4.535
.283
4.252
3.328
7.900
.283
7.617