Plat of Survey No. Miscellaneous #322 Claim No. Sec City No 26

Section 35 Township 15 Range 5W

Scale: 40 Ft. ~~Chains~~ to the Inch.

Field Notes recorded at page , Vol. , Record of Surveys.
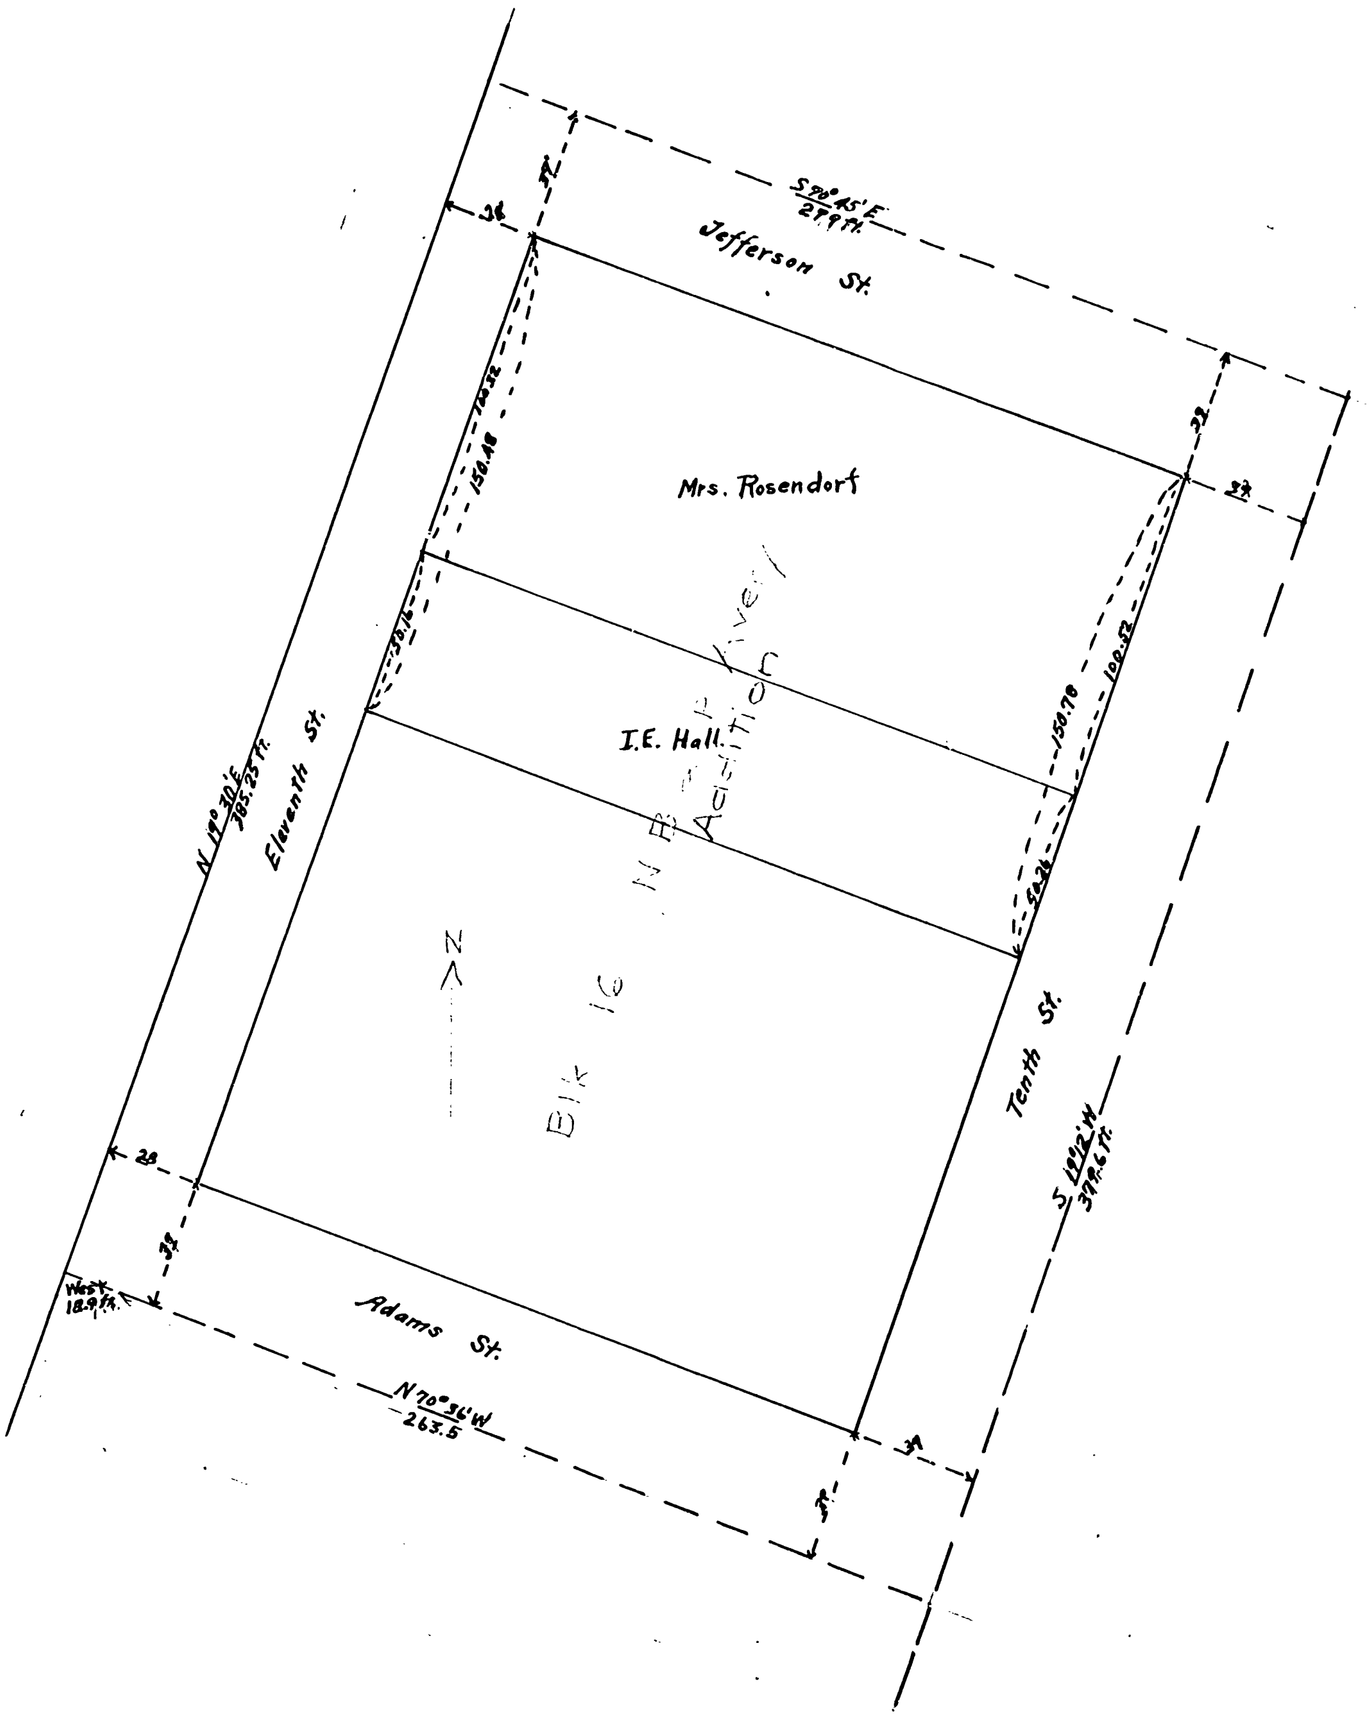
MADE FOR Mrs. Rosendorf.